

RELINQUISH NARY

APPLICATION

A 24121

SEWAGE DISPOSAL TESTING

P _____

STATE OF MARYLAND - DEPARTMENT OF HEALTH AND MENTAL HYGIENE

DISTRICT 3rd

HOWARD COUNTY HEALTH DEPARTMENT
ENVIRONMENTAL HEALTH SERVICES

DATE 10/4/76

P O BOX 476, ELLICOTT CITY, MARYLAND 21043
TELEPHONE: 465-5000, EXT. 356

*10/13/76 Not tested
1:30 P.M. Machine broke down
WWZ
4/9/76
+ 3:30 P.M.
11/15/76
2:00 P.M.*

*E = 11 min
120 A/BR + 20% + 25 A/BR ⇒ 145 A BR
Inlet 4 1/2', Max depth 10 1/2'*

TO THE COUNTY HEALTH OFFICER
ELLICOTT CITY, MARYLAND

I, HEREBY, APPLY FOR THE NECESSARY TEST IN ORDER TO CONSTRUCT (OR RECONSTRUCT) A SEWAGE DISPOSAL SYSTEM.

PROPERTY OWNER W. A. Rothe, Inc.

ADDRESS 9015 Liberty Road, Randallstown, Md. 21133 PHONE ~~655-3733~~
795-6555

PROPERTY LOCATION:

SUBDIVISION _____ LOT NO. A

ROAD AND DESCRIPTION Gaither Road

SIZE OF LOT 5.155 acres TYPE BLDG. 3 or 4 bedrooms
NUMBER OF BEDROOMS

IF NOT SINGLE RESIDENCE DESCRIBE _____

THE SYSTEM INSTALLED UNDER THIS APPLICATION IS ACCEPTABLE ONLY UNTIL PUBLIC FACILITIES BECOME AVAILABLE.

SIGNATURE OF APPLICANT /s/ W. A. Rothe BLDG. PERMIT, SIGNED AND RETURNED 11/7/77

APPROVED BY William H. Jupp FOR DW & tunnel DATE 12/8/76
(KIND OF SYSTEM)


REJECTED BY _____ FOR _____ DATE _____
(KIND OF SYSTEM)

HOLD PENDING FURTHER TESTS WWZ DATE 11/4/76 11/15/76

REASONS FOR REJECTION OR HOLDING Rock insuff. perc - final plat
w field located perc holes.

THIS IS NOT A PERMIT

A24121

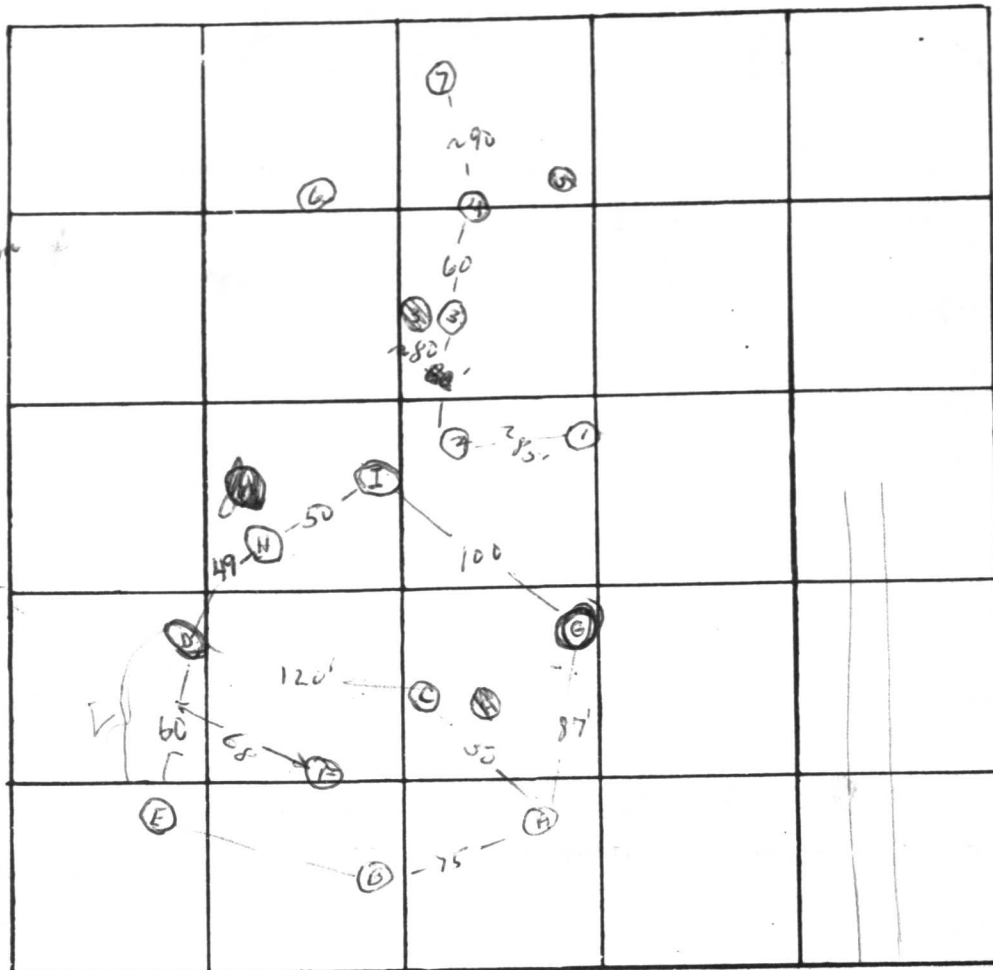

③ 0
5 clay
sandy loam
hard
13 Rock

④ 0
6 clay
sandy, but
hard
14 Rock

11/9/76
0
clay
11/3/76
grayish
sandy
loam
13 Rock

INDICATE NORTH. - NAME ADJOINING ROADWAY AS BASE LINE
← GATHER RD →

DATE	TEST NO.	DEPTH	PRE-WET		TEST - 1" DROP		TIME
			START	STOP	START	STOP	
11/3/76	1	4 1/2	Rock	fr. surface			
	2	7'	Rock				
	3	5 1/2	2:05	2:04	2:07	2:13	6
	3-A	13	2:06	2:22	2:22		
	4	5 1/2	2:19				
	4-A	11	2:19	2:23	2:23	2:30	7
	5	8	Rock; covered				
11/9/76	6	9	Rock; 6' of clay				
	7	8 1/2	Rock; fr 6 1/2"				
	A	5	2:11	2:22	2:22	2:27	5
	A-1	13	2:19	2:26	2:26	2:33	7
	B	5 1/2	2:23	2:26	2:26	2:33	7
	B-2	12 1/2	2:23	2:30	2:30	2:42	12
	C	6	2:30	2:35	2:35	2:47	12
	C-1	12 1/2	2:29	2:42	2:42	2:55	13
	D	4 1/2	2:55	NO	PERC		
	D-1	12	2:55	3:04	3:04	3:21	18
E	7	3:13	3:20	3:20	3:28	8	
	E-1	13	3:20	3:23	3:23	3:30	7

REMARKS A → B = 75'
Hole E dug to ';

TYPE OF SOIL _____
TESTED BY NWZ on 11/3/76
NWZ on 11/9/76 ALSO PRESENT: Brittingham, Potter

F 11' Rock @ 11'; good soil fr 4 3/4' - 11'
D-2 5 1/2 3:33 3:37 3:37 3:45 8