

9/20/77 please
a.m. please
~~9/15/77~~ a.m. please

PERMIT

P 85967

A 24121

SEWAGE DISPOSAL SYSTEM

MARYLAND STATE DEPARTMENT OF HEALTH

HOWARD COUNTY

03-282031

ELLICOTT CITY

DISTRICT 3rd

DATE 6/1/77

INDEXED

Donald Parlette

~~Jim Brittingham~~

IS PERMITTED TO INSTALL ALTER

ADDRESS 3004 N. Rogers Avenue, Ellicott City, Md. 21043 PHONE 461-1870

A SEWAGE DISPOSAL SYSTEM LOCATED AT _____

SUBDIVISION _____ ROAD 621 Gaither Road LOT Parcel A

PROPERTY OWNER W. A. Rothe, Inc.

ADDRESS 8015 Liberty Road, Randallstown, Md. 21133 Phone: 795-6555

SPECIFICATIONS 3 bedrooms

DRAIN FIELD _____ DEPTH _____ FEET, BOTTOM AREA _____ SQ. FT.

SEEPAGE PITS _____ ABSORBENT SIDE-WALL AREA _____ SQ. FT.

SEPTIC TANK CAPACITY 1000 GALLONS

FOR GARBAGE GRINDER, INCREASE DISPOSAL AREA 22% & TANK CAPACITY 50%.

OTHER DRY WELL AND TRENCH - Dry well to have 300 sq. ft. absorbent sidewall area. Inlet at 4½ ft. and maximum depth 10½ ft. below original grade. Locate dry well 40 ft. off right lot line, and 245 ft. from front property corner at left of driveway (see plat) as seen from Gaither Road (perc hole #6). Trench to be 23 ft. long for a total side-wall area of 135 sq. ft. Run trench off rear of dry well and parallel to right lot line which is 154.05 ft. long (see plat) towards perc hole #17. Inlet of trench to be 4½ ft. and maximum depth 10½ ft. NOTE: CALL FOR INSPECTION OF TRENCH BEFORE PLACING STONE IN TRENCH. NOTE: ALL PIPE FROM HOUSE TO DISPOSAL AREA MUST BE CAST IRON. PERMIT VOID AFTER THREE YEARS. NOTE: INSTALL STAND PIPE ON SEPTIC TANK AND DRY WELL. STAND PIPES MUST BE 6 INCHES IN DIAMETER. CAST IRON, CONCRETE OR TERRA

PLANS APPROVED BY William W. Zepp DATE 12/8/76


COTTA ACCEPTED.

FILL SEPTIC TANK AND DISTRIBUTION BOX WITH WATER BEFORE CALLING FOR AN INSPECTION. COVER NO WORK UNTIL INSPECTED AND APPROVED.

NEITHER THE HOWARD COUNTY COMMISSIONERS NOR THE HEALTH DEPARTMENT IS RESPONSIBLE FOR THE SUCCESSFUL OPERATION OF ANY SYSTEM.

A24121

A24121

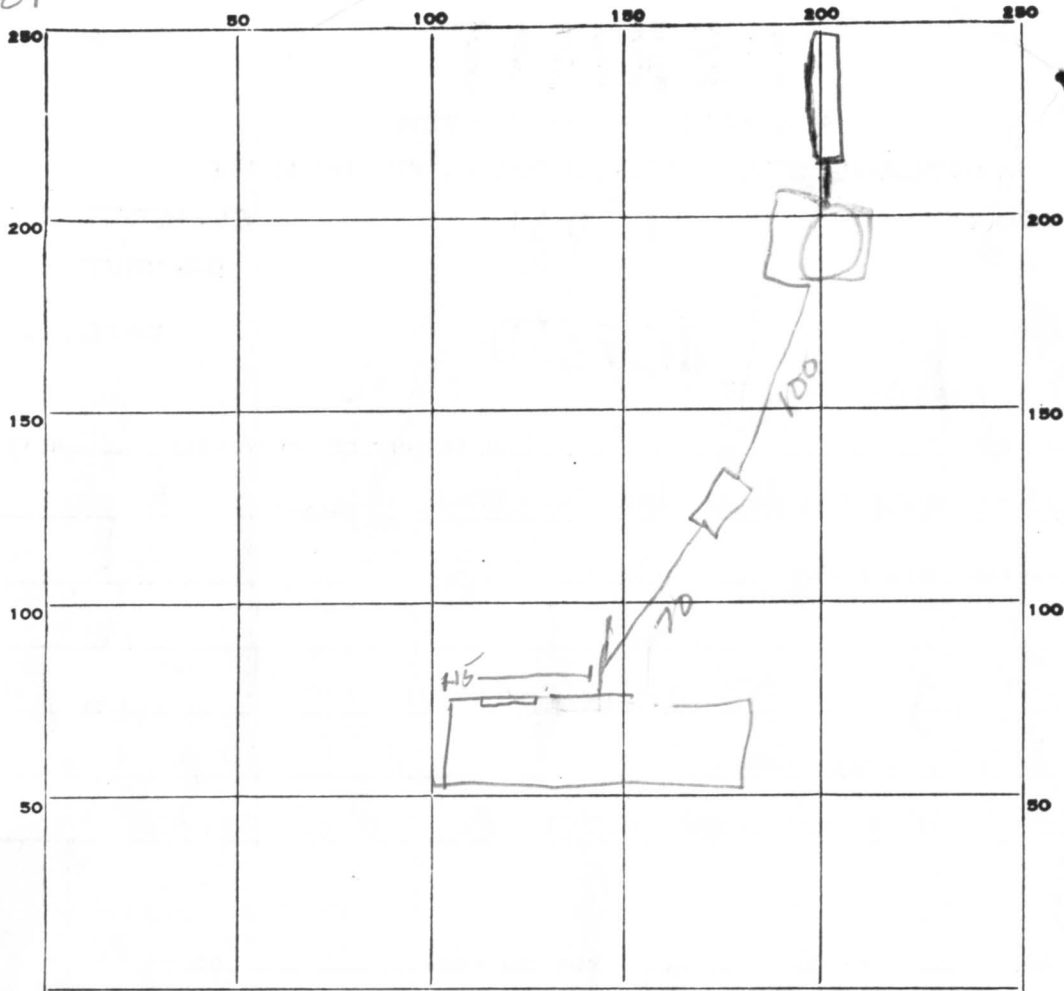

INDICATE NORTH. - NAME ADJOINING ROADWAY AS BASE LINE.

PERMIT CARD

SEPTIC TANK, LEVEL

CLEANOUTS Dir / ST

DISTRIBUTION BOX, LEVEL NA

TILE FIELD, DEPTH 25-30[?] FT. TRENCH WIDTH 2 FT.

GRAVEL DEPTH 3 1/2 from surface IN. TOTAL LENGTH 23 FT.

NUMBER OF TRENCHES 1 TOTAL BOTTOM AREA 161

SEEPAGE PITS, INSIDE DIAMETER 48 FT. DEPTH BELOW INLET 4 1/2 FT.

ABSORBENT AREA 288 SQ. FT. 449 total

REMARKS Trench depth not seen no buffer seen
Stop work - RB 9/15/77

DATE SYSTEM APPROVED Sept 20 77 INSPECTOR R Buzgoff

4
48
6
288

A24121

NOTE: TOPOGRAPHY SHOWN HEREON IS ASSUMED.

NOTE: CONTRACTOR TO SET SEPTIC SYSTEM AND HOUSE IN THE FIELD.

THE LOT SHOWN HEREON COMPLIES WITH THE MINIMUM OWNERSHIP WIDTH AND LOT AREA AS REQUIRED BY THE MARYLAND STATE DEPARTMENT OF HEALTH AND MENTAL HYGIENE.

PERCOLATION TEST HOLES SHOWN HEREON HAVE BEEN FIELD LOCATED.

APPROVED: FOR PRIVATE WATER AND PRIVATE SEWAGE SYSTEMS.

Joyce M. Boyd
COUNTY HEALTH OFFICER

11-30-76
DATE

HOUSE	DRYWELL
FF: 98 ⁰	EX. GRD: 94 ⁰
BSMT: 90 ⁰	FIN. GRD: 94 ⁰
GAR: 98 ⁰	INV. IN: 89 ⁰
INV. OUT: 93.5 ⁰ 95.50	

1000 GAL. SEPTIC TANK
EX. GRD: 96 ⁰
FIN. GRD: 96 ⁰
INV. IN: 92 ⁰
INV. OUT: 92 ⁰

WELL
EX. GRD: 97 ⁰
FIN. GRD: 97 ⁰

44-1-17-77
D.M.

