

GAITHER  
 11012  
 Proposed House OK  
 Pool House OK  
 KN  
 B00145700

11/16/04  
 B00145700  
 approved KN

11/16/04  
 Pool House  
 proposal  
 OK  
 KN

7.5575 AC. ±

URBANCE WHERE A  
 OR OTHER ACCEPTABLE  
 FEET) AND 800 LBS.  
 G. HARROW OR DISC INTO  
 30-0-0 UREAFORM  
 ARE FEET) AND 1000  
 ING. HARROW OR DISC  
 VEMBER 15, SEED  
 THE PERIOD  
 GRASS (.07 LBS.  
 PROTECT SITE BY  
 AS SOON AS  
 WROTTED SMALL GRAIN  
 & MULCH  
 (HALT FLAT  
 FEET)  
 DINGS.





DESIGNED	BY	NO.	REVISION
GSS	RF	1	REVISED HOUSE LOCATION DEL. SOUTH DR. ENTRANCE
DRAWN	RF	2	REVISED SEPTIC AREA
CHECKED	RF	3	REVISED POOL, GARAGE, & POOL HOUSE LOCATION
GSS			
DATE			
4/15/03			

DESIGNED	DATE
GSS	4/15/03
DRAWN	5/5/03
RF	1/8/04
CHECKED	
GSS	
DATE	4/15/03

GP-03-46 + 468.  
 GR

10/11/04 10:00 AM

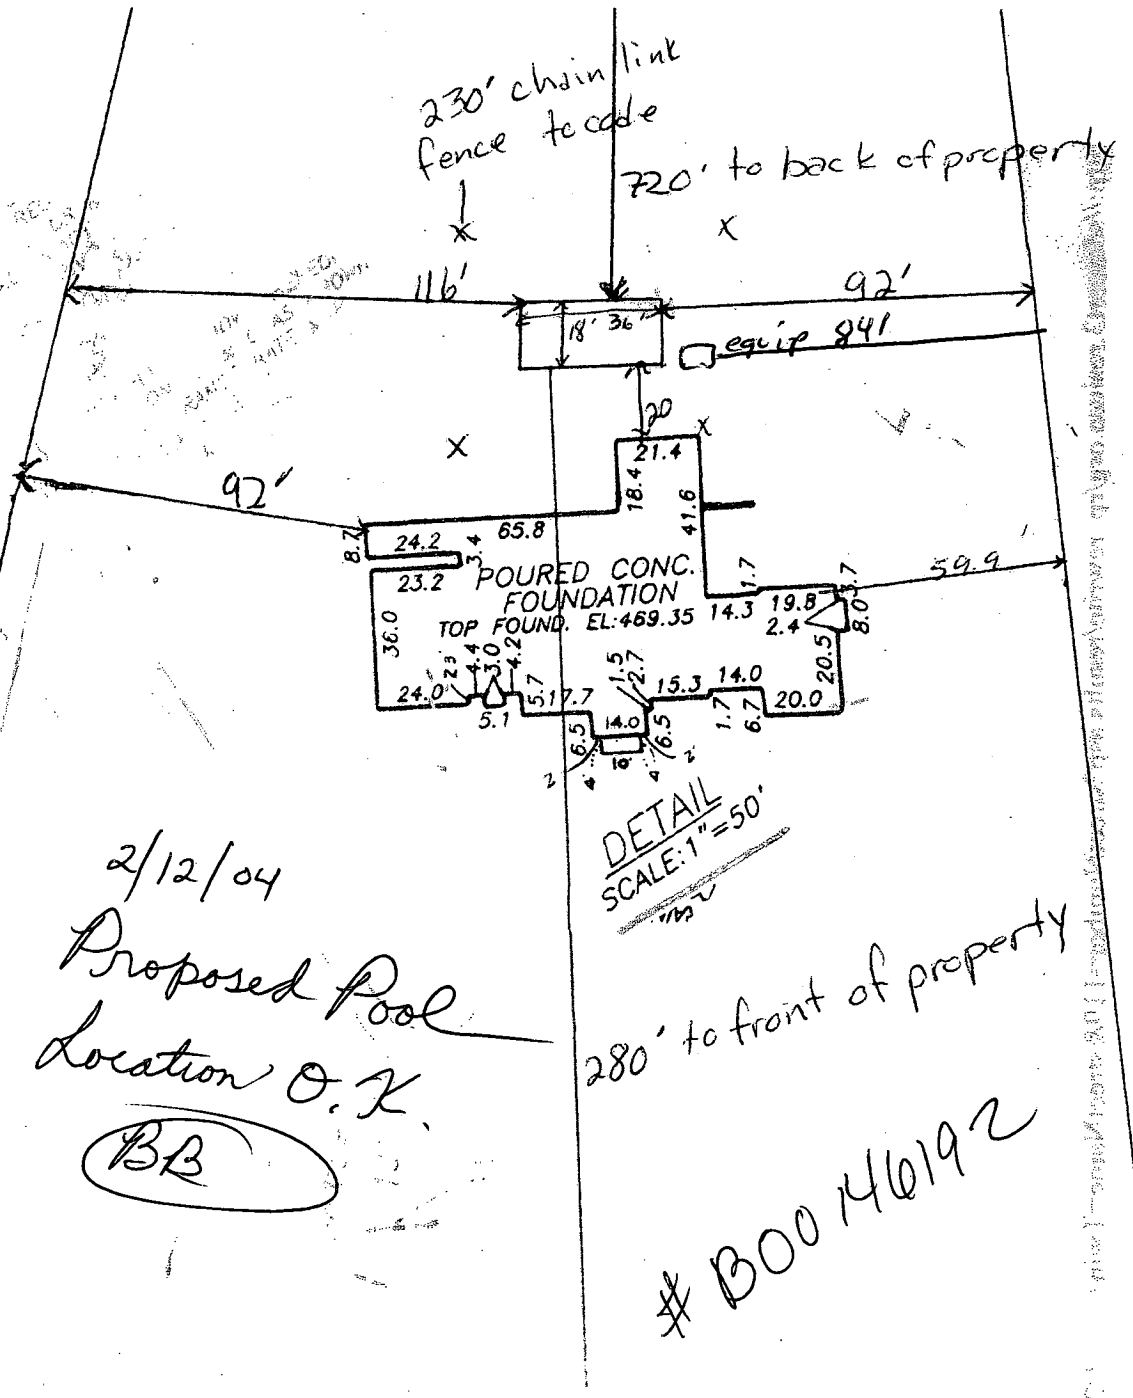

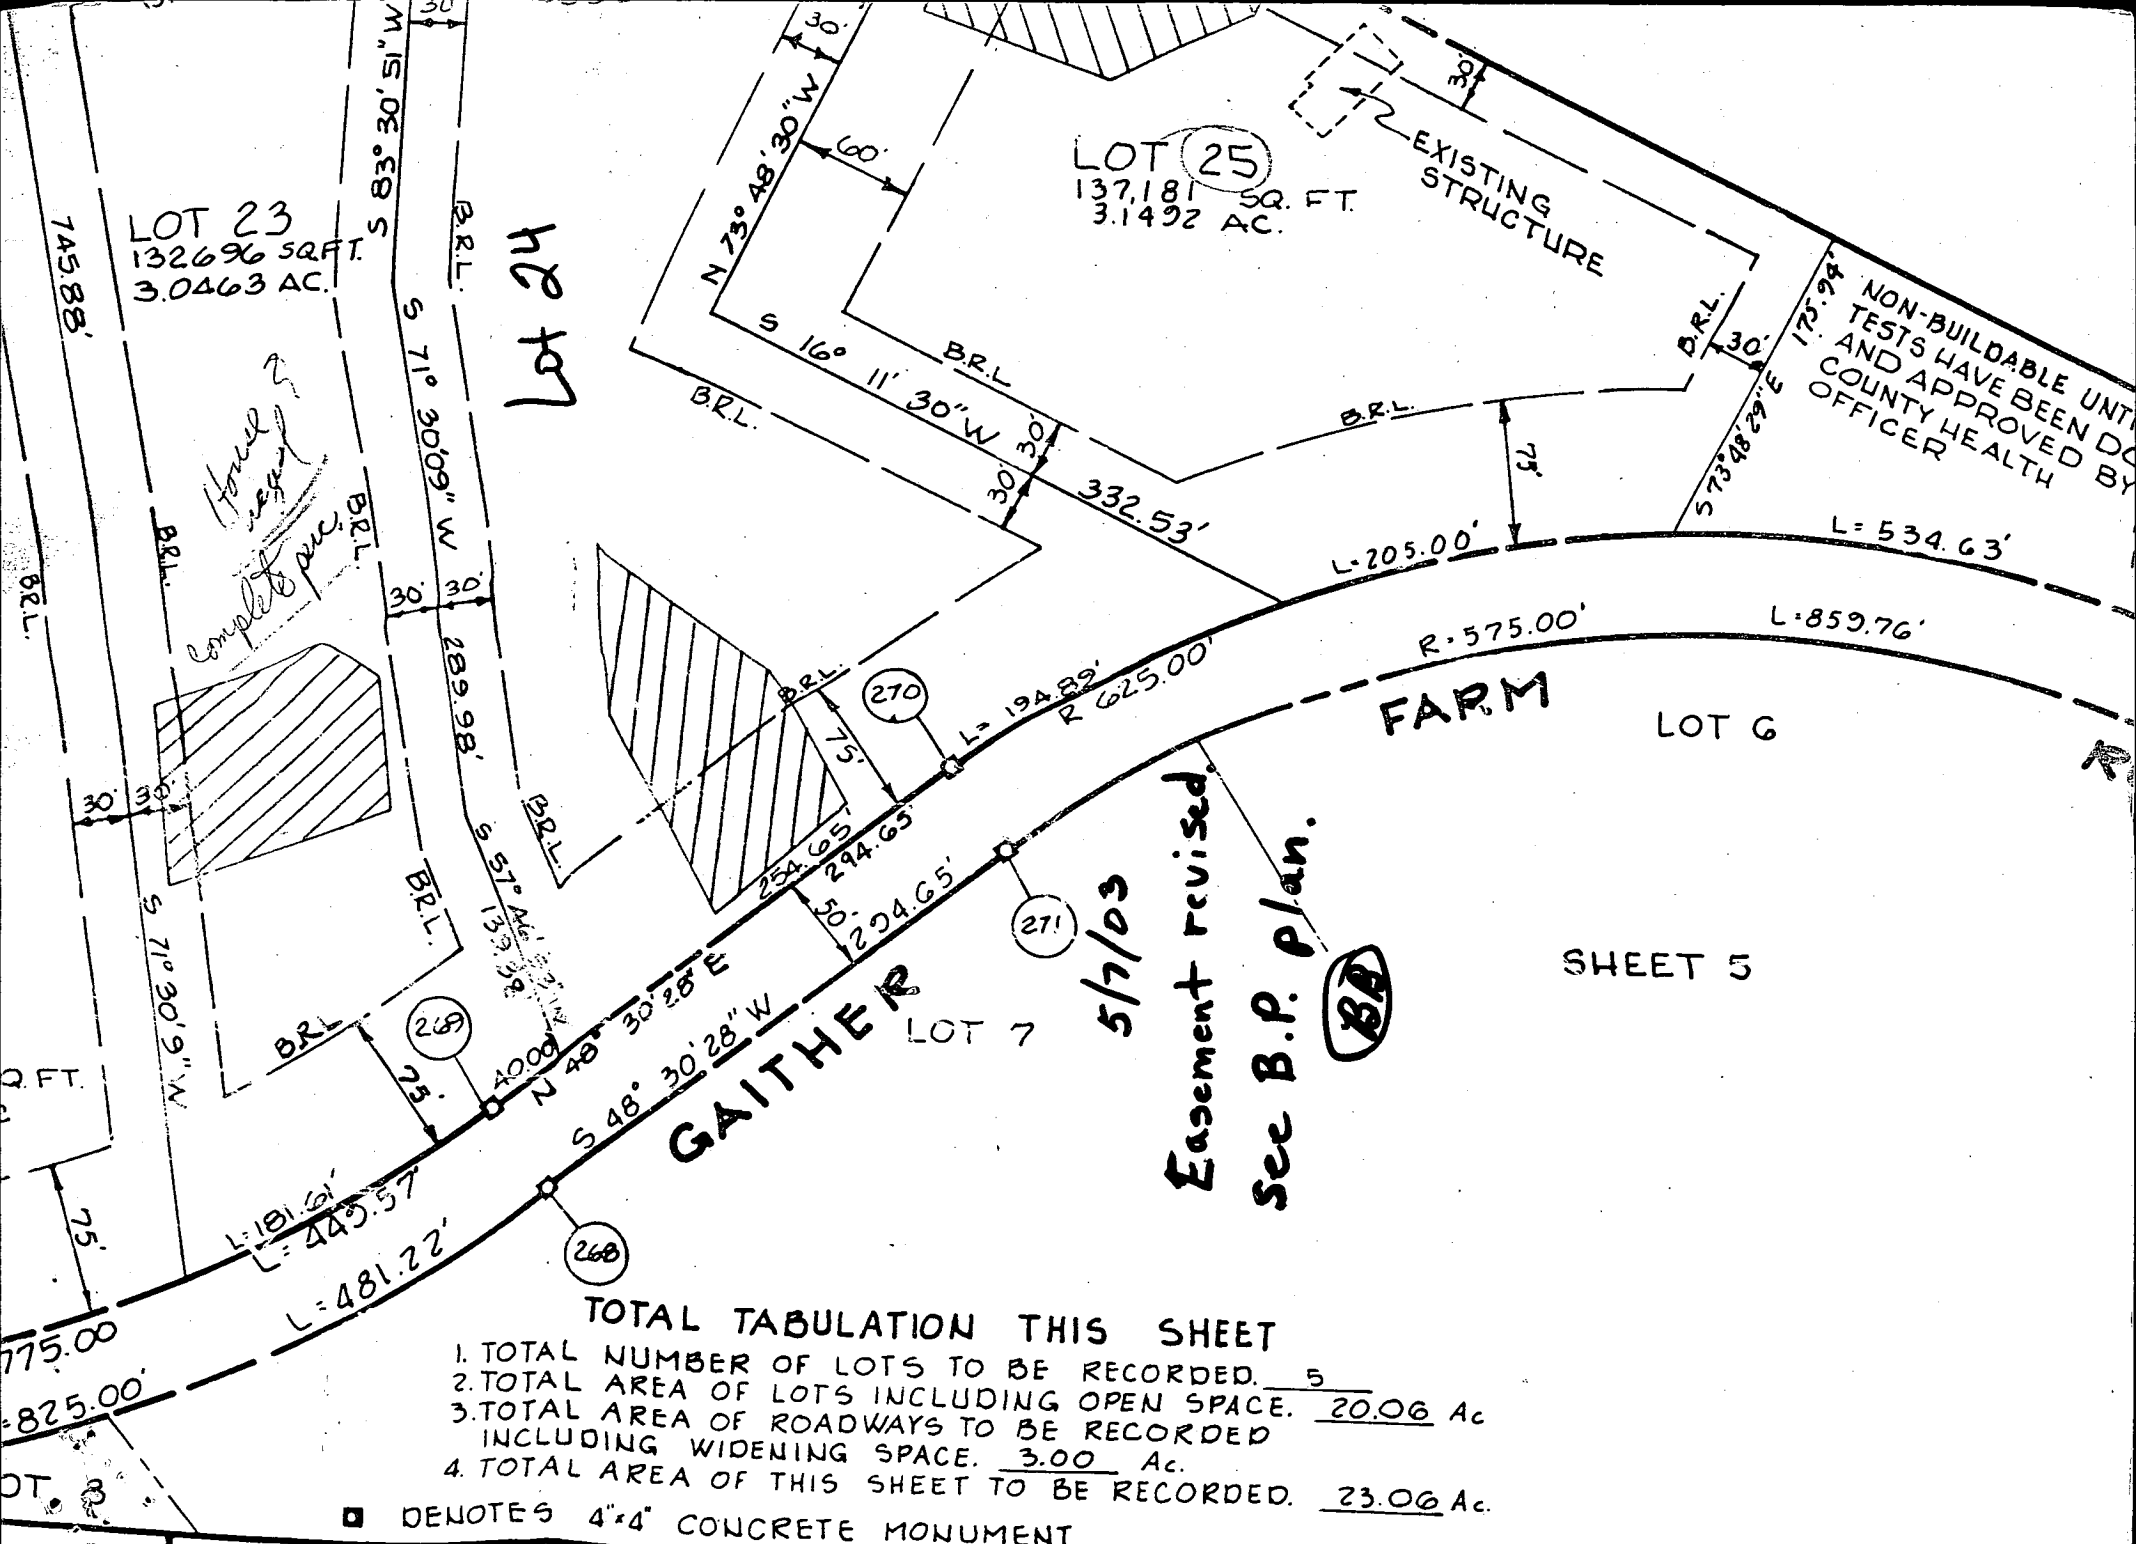

LOT 25  
137,181 SQ. FT.  
3.1492 AC.

LOT 23  
132,696 SQ. FT.  
3.0463 AC.

lot 24

FARM

LOT 6

LOT 7

SHEET 5

Easement revised.  
See B.R. Plan.  
5/7/03  
(BA)

TOTAL TABULATION THIS SHEET

1. TOTAL NUMBER OF LOTS TO BE RECORDED.	5
2. TOTAL AREA OF LOTS INCLUDING OPEN SPACE.	20.06 Ac
3. TOTAL AREA OF ROADWAYS TO BE RECORDED INCLUDING WIDENING SPACE.	3.00 Ac
4. TOTAL AREA OF THIS SHEET TO BE RECORDED.	23.06 Ac

■ DENOTES 4"x4" CONCRETE MONUMENT