

AP 5163


Brown L	1/2
Orange/Brown Sel	5
Yellow/Brown SL w/ trace Rock	11'
H ₂ O	12'

5162

Brown L	1/2
Red/Orange heavy Sel	5 1/2
Yellow/Brown SL w/ trace Rock	11'

5159

Brown L	1
Red/Orange Sel	4
Yellow/Brown SL w/ trace Rock	12'

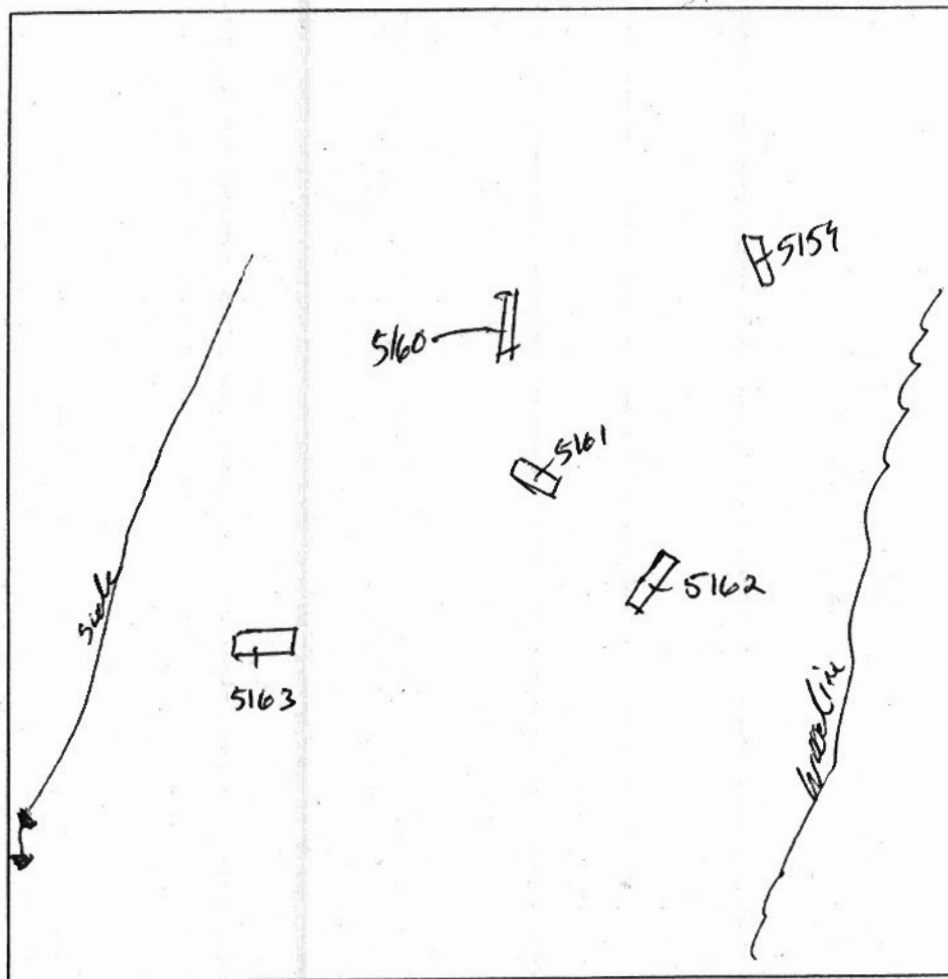

5160

Brown L	2'
Red/Orange Brown Sel	5
Yellow/Brown SL w/ trace Rock	11'

5161

Brown L	2'
Red/Orange Sel	5'
Yellow/Brown SL w/ trace Rock	11'

DATE	TEST #	DEPTH	START	BREAK 1' DROP	STOP 2' DROP	TIME OF 2nd INCH	P/F/H
9/15/05	5163	7' 12"	1:26	1:33	1:49	16min	P
	5162	5 1/2' 11"	2:17 1:57	2:15	2:23	3min	P
	5159	4' 12"	1:51	1:55	2:05	10min	P
	5160	5' 11"	2:04	2:08	2:13	5min	P
	5161	-	11"	-Visual-		OK	P

REMARKS lot 70 50

SANITARIAN _____ BACKHOE _____ OTHERS _____

TEST HOLES USED IN SDA _____ AVG. PERC TIME _____ SQ. FT/BR _____

TRENCH WIDTH _____ INLET DEPTH _____ MAX. BOT DEPTH _____ EFFECTIVE SW _____



Approved
Plan
1/25/08

NON-BUILDABLE
PRESERVATION
PARCEL
1.31 AC±

OWNED AND MAINTAINED BY HOA
HAZARD CLASS "X"
SLEEP-POOL 164.40
8840V. STORAGE IS NOT PERMITTED

B.M.P. No. 11
TICO-POOL
EXTENDED DETENTION POND
FOR W-104-CR

1605

1110

P17

LOT 26
52,069 sq. ft.

LOT 25
49,977 sq. ft.

LOT 28
48,145 sq. ft.

LOT 29
49,973 sq. ft.

LOT 24
45,879 sq. ft.

LOT 23
42,363 sq. ft.

LOT
46,239 sq. ft.

B.M.P. No. 3
LEVEL SPREADS

B.M.P. No. 13
LEVEL SPREADS

Wetland
Buffer

35. ENVIRONMENTAL BACKSTOP (EVS)

12. MAINT ACCESS

11. SLEEP POOL

10. SLEEP POOL

9. SLEEP POOL

8. SLEEP POOL

7. SLEEP POOL

6. SLEEP POOL

5. SLEEP POOL

4. SLEEP POOL

3. SLEEP POOL

2. SLEEP POOL

1. SLEEP POOL

0. SLEEP POOL

-1. SLEEP POOL

-2. SLEEP POOL

-3. SLEEP POOL

-4. SLEEP POOL

-5. SLEEP POOL

-6. SLEEP POOL

-7. SLEEP POOL

1. SLEEP POOL

2. SLEEP POOL

3. SLEEP POOL

120. S