


(Meters)  
 N 176723.3934  
 E 1301500  
 N 579800  
 E 396697.9934

*copy plot 21342  
 10/29/10*

Land Dedicated To  
 Howard County, Maryland  
 For The Purpose of A Public  
 Road (1746 Ac.)

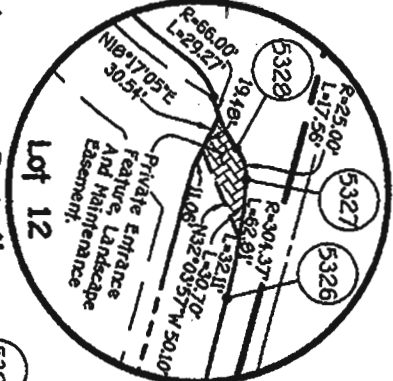



**Roxbury Road**  
 (Variable R/W)  
 Local Road

Private Entrance  
 Feature, Landscape  
 Maintenance Easement,  
 Maintained by  
 Homeowner's Association  
 (See Detail This Sheet)

ZONED: RC-DEO  
 FRANCES B. DEVLIN  
 LIBER 521, FOLIO 412  
 TAX MAP 21  
 PARCEL 28

Note  
 Curv  
 Note

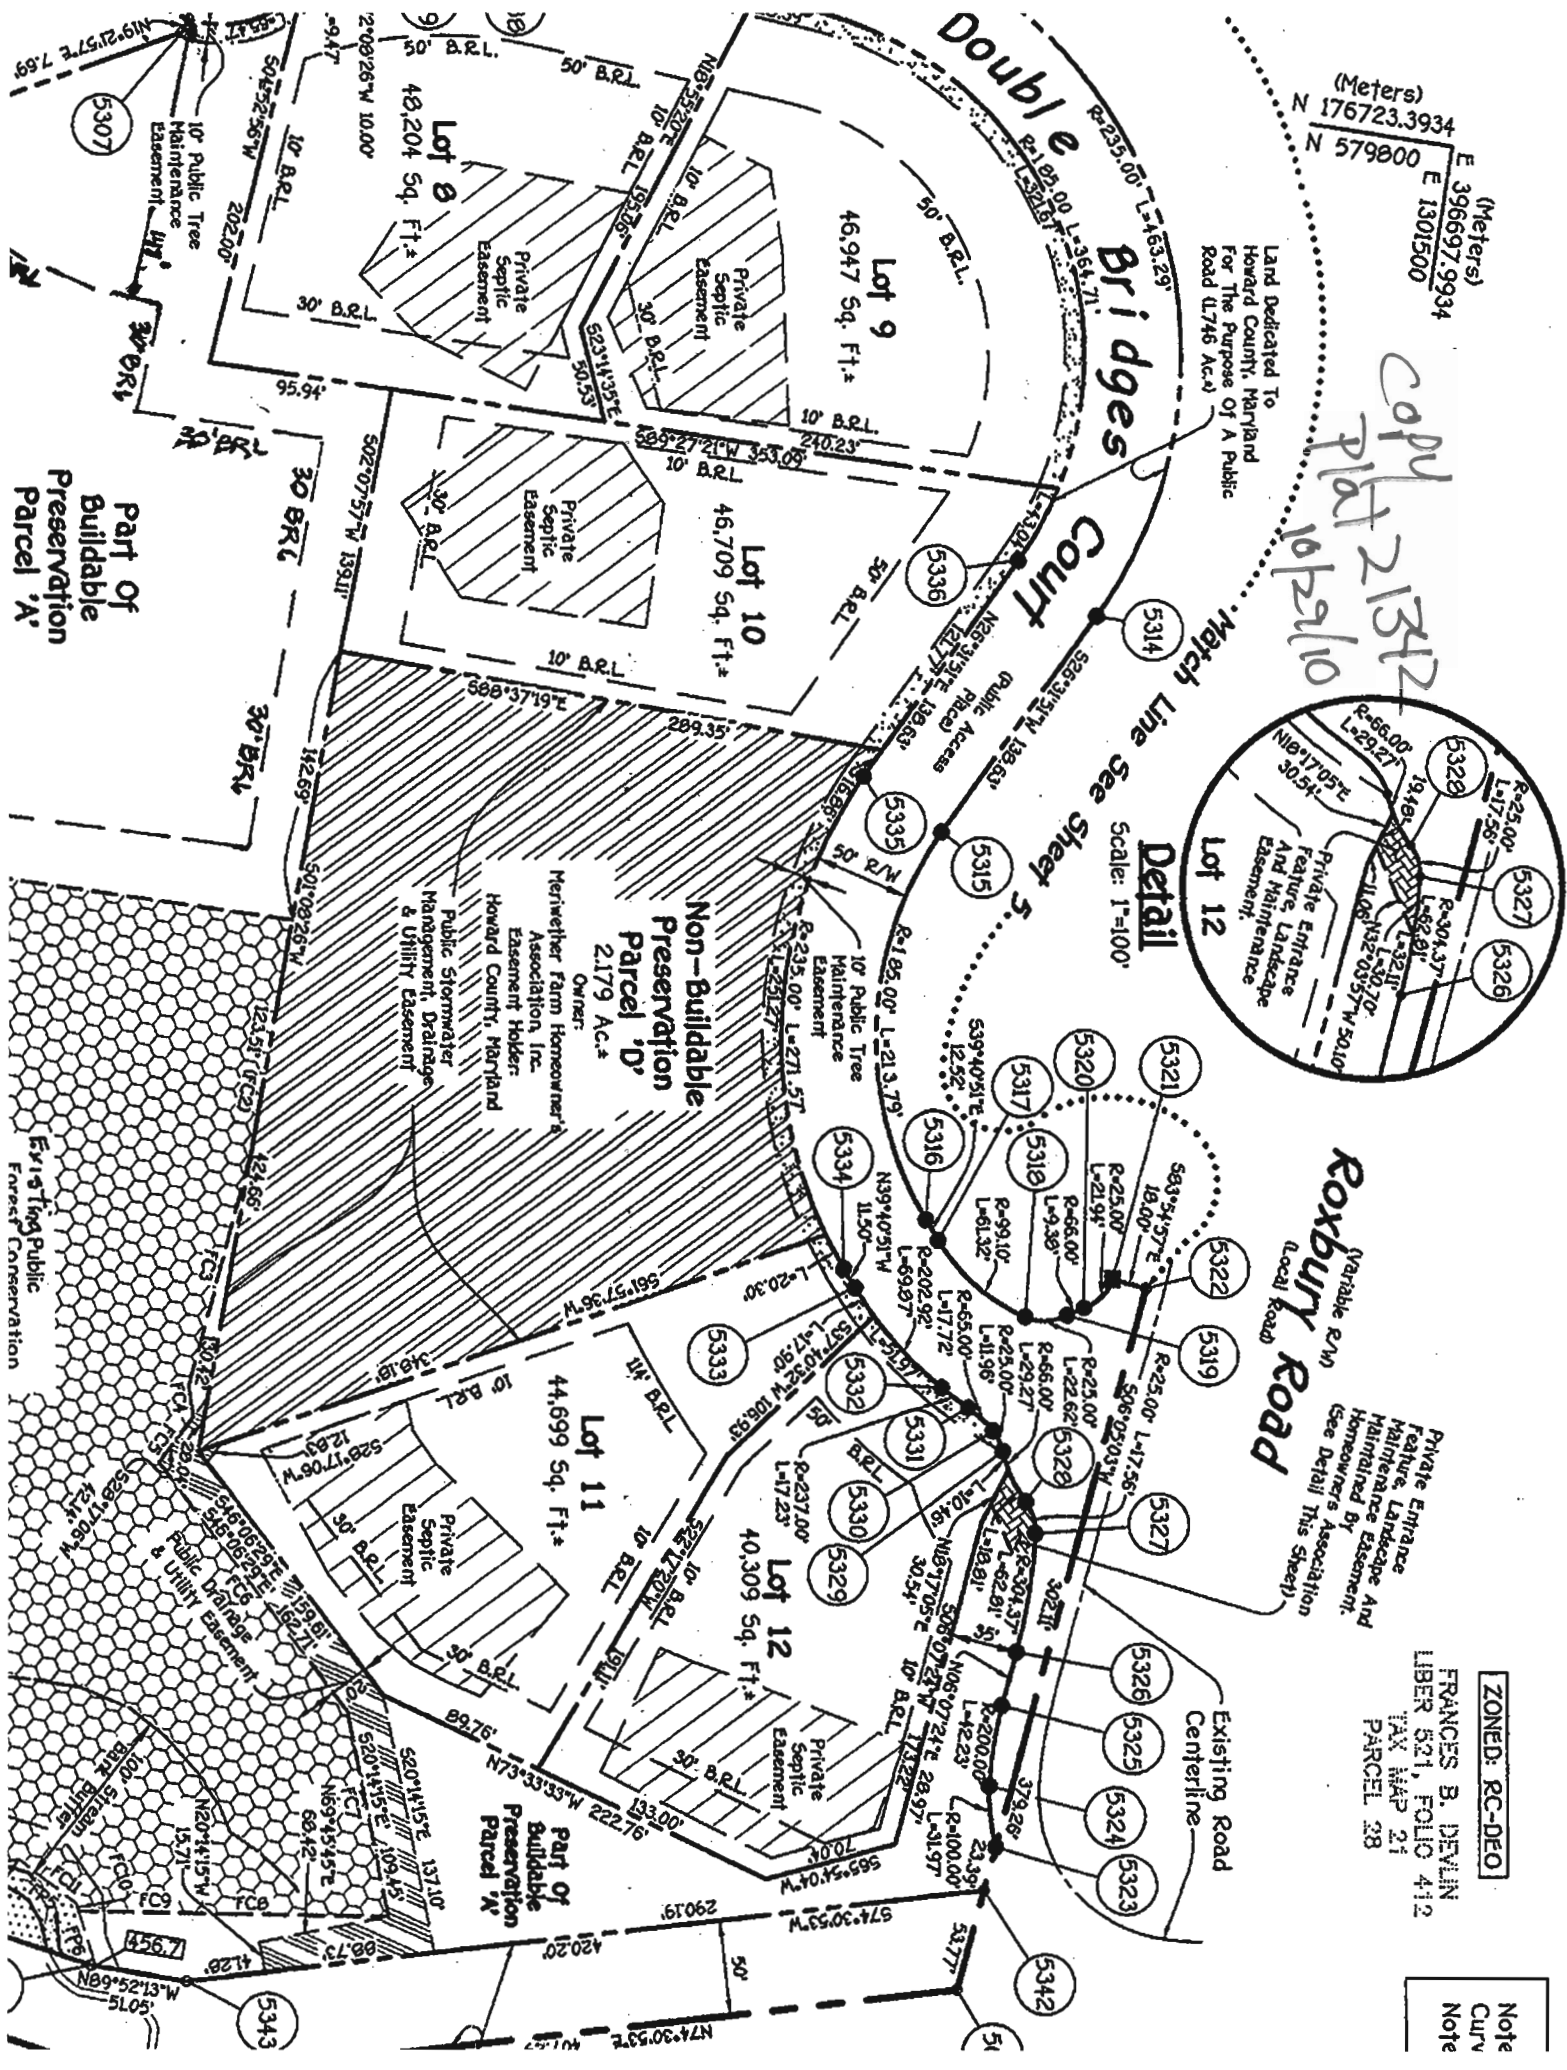

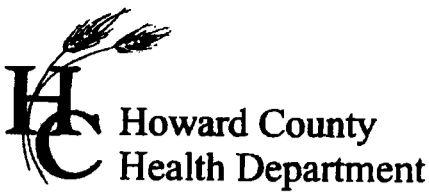

# APPLICATION

## FOR PERCOLATION TESTING AND SITE EVALUATION

LOT 10

TEST DATE(S) \_\_\_\_\_

TEST TIME \_\_\_\_\_

AP 522493-N

AGENCY REVIEW: \_\_\_\_\_

DATE 5/24/05

DO NOT WRITE ABOVE THIS LINE

I HEREBY APPLY FOR THE NECESSARY TESTING/EVALUATION PRIOR TO ISSUANCE OF SEWAGE DISPOSAL SYSTEM PERMIT(S) TO:

CHECK AS NEEDED:

- CONSTRUCT NEW SEPTIC SYSTEM(S)
- REPAIR/ADD TO AN EXISTING SEPTIC SYSTEM
- REPLACE AN EXISTING SEPTIC SYSTEM

CHECK AS NEEDED:

- NEW STRUCTURE(S)
- ADDITION TO AN EXISTING STRUCTURE
- REPLACE AN EXISTING STRUCTURE

CHECK ONE:

- CREATE NEW LOT(S)
- BUILD ON AN EXISTING LOT IN A SUBDIVISION
- BUILD ON AN EXISTING PARCEL OF RECORD

IS THE PROPERTY WITHIN 2500' OF ANY RESERVOIR?

- YES
- NO

THE TYPE OF STRUCTURE IS:

- RESIDENTIAL WITH PROPOSED BEDROOMS IN THE COMPLETED STRUCTURE (NOTE UNKNOWN IF APPROPRIATE)
- COMMERCIAL (PROVIDE DETAIL OF NUMBERS AND TYPES OF EMPLOYEES/CUSTOMERS ON ACCOMPANYING PLAN)
- INSTITUTIONAL/GOVERNMENT (PROVIDE DETAIL OF NUMBERS AND TYPES OF EMPLOYEES/USERS ON ACCOMPANYING PLAN)

PROPERTY OWNER(S) Frances Devlin

DAYTIME PHONE (410) 997-7400 (GOODIER BUILDERS) CELL \_\_\_\_\_ FAX \_\_\_\_\_

MAILING ADDRESS ECHO FARM ROUTE 3, 43 EAST LITCHFIELD ROAD, LITCHFIELD, CONNECTICUT 06750

STREET CITY/TOWN STATE ZIP

APPLICANT Heritage Land Development

DAYTIME PHONE 410-489-7900 CELL 410-984-0408 FAX 410-489-9768

MAILING ADDRESS 3060 Washington Road, Suite 220 Glenwood MD 21738

STREET CITY/TOWN STATE ZIP

APPLICANT'S ROLE  DEVELOPER  BUILDER  BUYER  RELATIVE/FRIEND  REALTOR  CONSULTANT

PROPERTY LOCATION Meriweather Farm LOT NO. 17

SUBDIVISION NAME \_\_\_\_\_

PROPERTY ADDRESS 14944 Roxbury Road Glenelg

STREET TOWN/POST OFFICE

TAX MAP PAGE(S) 21 GRID 16 PARCEL(S) 28 PROPOSED LOT SIZE 1 Acre



AS APPLICANT, I UNDERSTAND THE FOLLOWING: THE SYSTEM INSTALLED SUBSEQUENT TO THIS APPLICATION IS ACCEPTABLE ONLY UNTIL PUBLIC SEWAGE IS AVAILABLE. THIS APPLICATION IS COMPLETE WHEN ALL APPLICABLE FEES AND A SUITABLE SITE PLAN HAVE BEEN RECEIVED. I ACCEPT THE RESPONSIBILITY FOR COMPLIANCE WITH ALL M.O.S.H.A. AND "MISS UTILITY" REQUIREMENTS. APPROVAL IS BASED UPON SATISFACTORY REVIEW OF A PERC CERTIFICATION PLAN. TEST RESULTS WILL BE MAILED TO APPLICANT.

Jeany Rutter  
SIGNATURE OF APPLICANT

HOWARD COUNTY HEALTH DEPARTMENT, BUREAU OF ENVIRONMENTAL HEALTH, WELL AND SEPTIC PROGRAM  
3525-H ELLICOTT MILLS DRIVE, ELLICOTT CITY, MARYLAND 21043-4544 (410) 313-1771 FAX (410) 313-2648  
TDD (410) 313-2323 TOLL FREE 1-877-4MD-DHMH

522493-N

AVP ~~WVVA~~

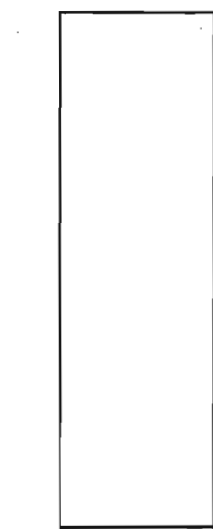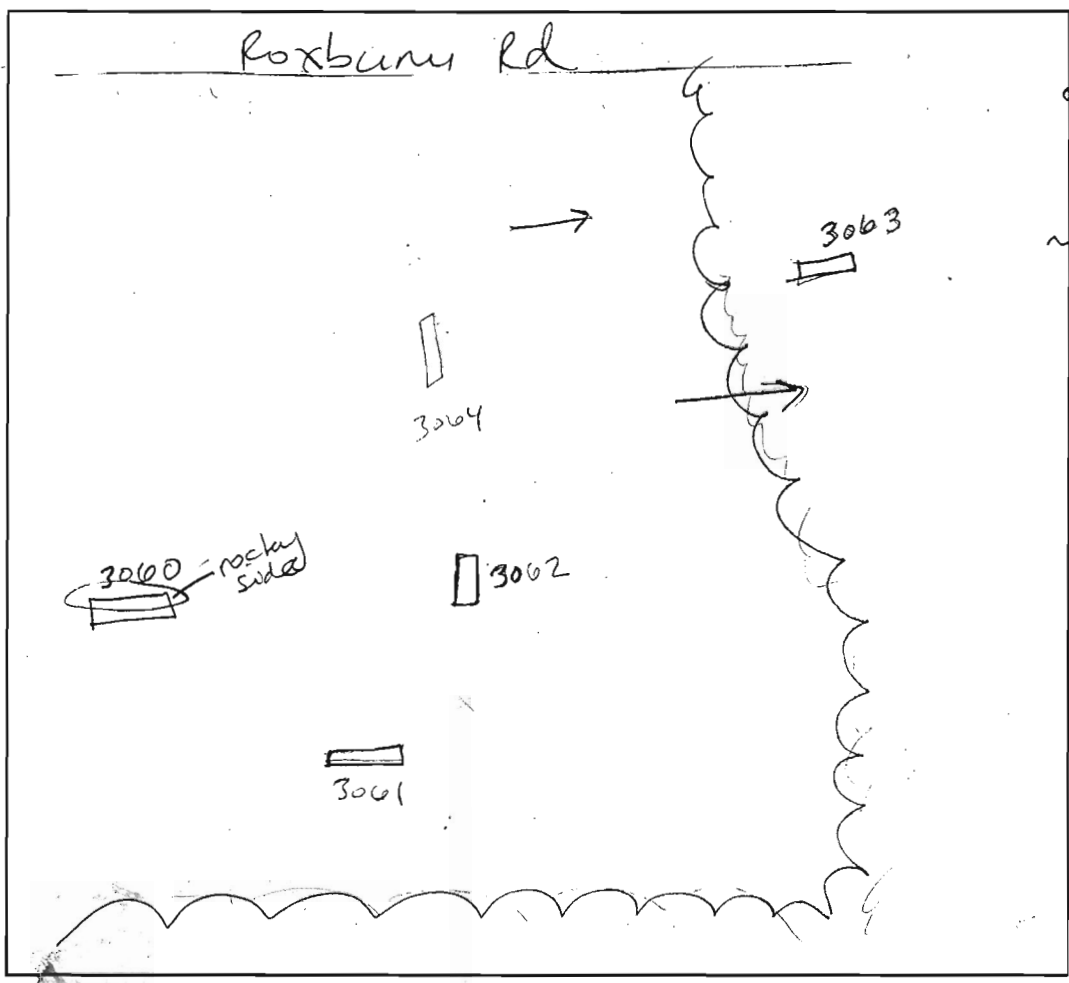

3064  
brown L  
orange/red brown  
cw sbk  
s/l

4'4"  
orange brown  
gray (decomposing rock)  
s/l cw  
S-10% cobbles / coarse chert

12'  
3063  
brown L  
orange brown  
L- sbk  
cw  
10-15% coarse chert

3'10"  
yellow brown  
s/l bk  
gritty from rock grains  
~10% coarse chert

3062  
brown L  
orange brown  
L- s/l bk  
sg  
5% cobbles / coarse chert  
orange brown  
s/l sg bk  
gritty due to rock grain  
5% coarse cherty  
dump rock

3061  
brown L  
orange brown  
cw s/l bk  
sg  
5% coarse cherty

5'2"  
yellow gray  
brown s/l  
10% cobbles / sg  
stone


3060  
brown L  
orange brown  
s/l  
cw bk  
5% coarse chert  
yellow brown  
s/l platy  
w/ rock grains  
15% cobbles / cw sg  
stone

DATE	TEST #	DEPTH	START	BREAK 1" DROP	STOP 2" DROP	TIME OF 2nd INCH	P/F/H
6-27-05	3064	5'4" / 12'	10:49 <sup>20</sup>	10:56	11:00	4	P
	3063	6' / 11'	10:11 <sup>20</sup>	10:13 <sup>01</sup>	10:15 <sup>46</sup>	2 <sup>45</sup>	P
	3062	5'2" / 11'	10:54	11:08	11:38	30	P
	3061	5'5" / 12'	11:04 <sup>21</sup>	11:15	11:30	15	P
	3060	4'10" / 9'10"	11:49 <sup>56</sup>	12:02	12:25	23	P

REMARKS: Holes dug per plan  
 SANITARIAN: SF BACKHOE: Justin (L. ...) OTHERS: Tim Feage  
 TEST HOLES USED IN SDA: \_\_\_\_\_ AVG. PERC TIME: 14.9 SQ. FT/BR: \_\_\_\_\_  
 TRENCH WIDTH: \_\_\_\_\_ INLET DEPTH: \_\_\_\_\_ MAX. BOT DEPTH: \_\_\_\_\_ EFFECTIVE S/W: \_\_\_\_\_

1 OT 15

Community Health Department  
Signature  
BPT

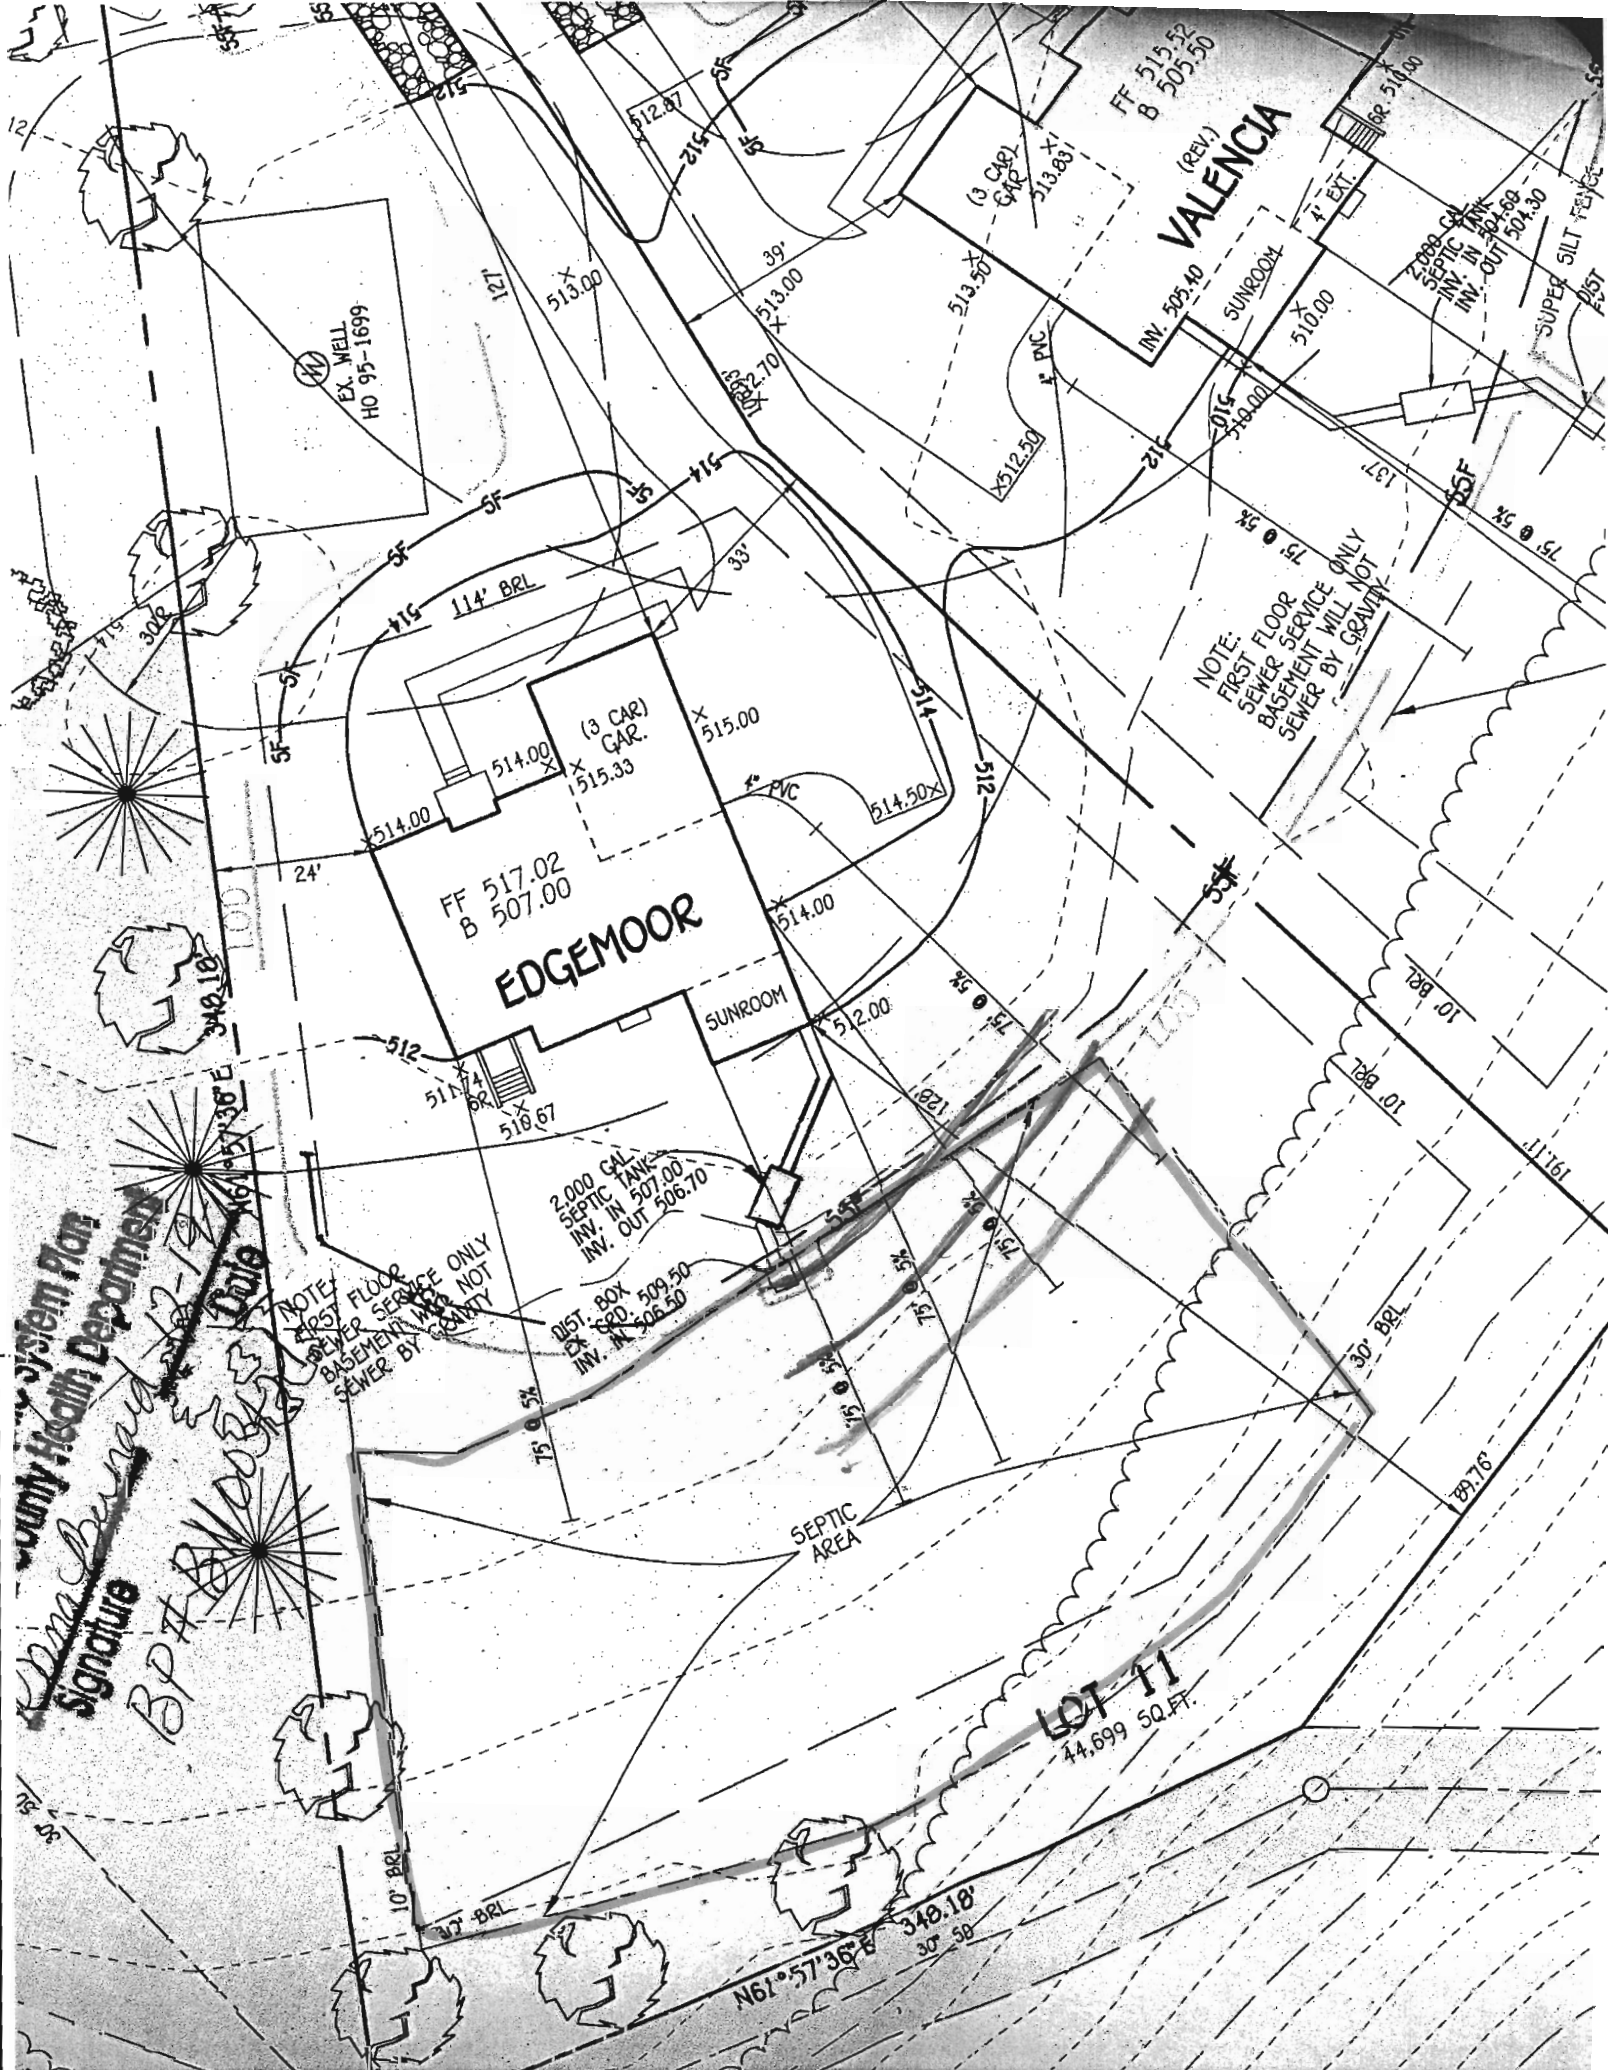

NOTE:  
FIRST FLOOR  
SEWER SERVICE ONLY  
BASEMENT WILL NOT  
SEWER BY GRAVITY

NOTE:  
FIRST FLOOR  
SEWER SERVICE ONLY  
BASEMENT WILL NOT  
SEWER BY GRAVITY

EDGEMOOR

VALENCIA


LOT 11  
44,699 SQ. FT.

EX. WELL  
HO 95-1699

2,000 GAL  
SEPTIC TANK  
INV. IN 507.00  
INV. OUT 506.70

2,000 GAL  
SEPTIC TANK  
INV. IN 504.50  
INV. OUT 504.30

SUPER SILT FENCE

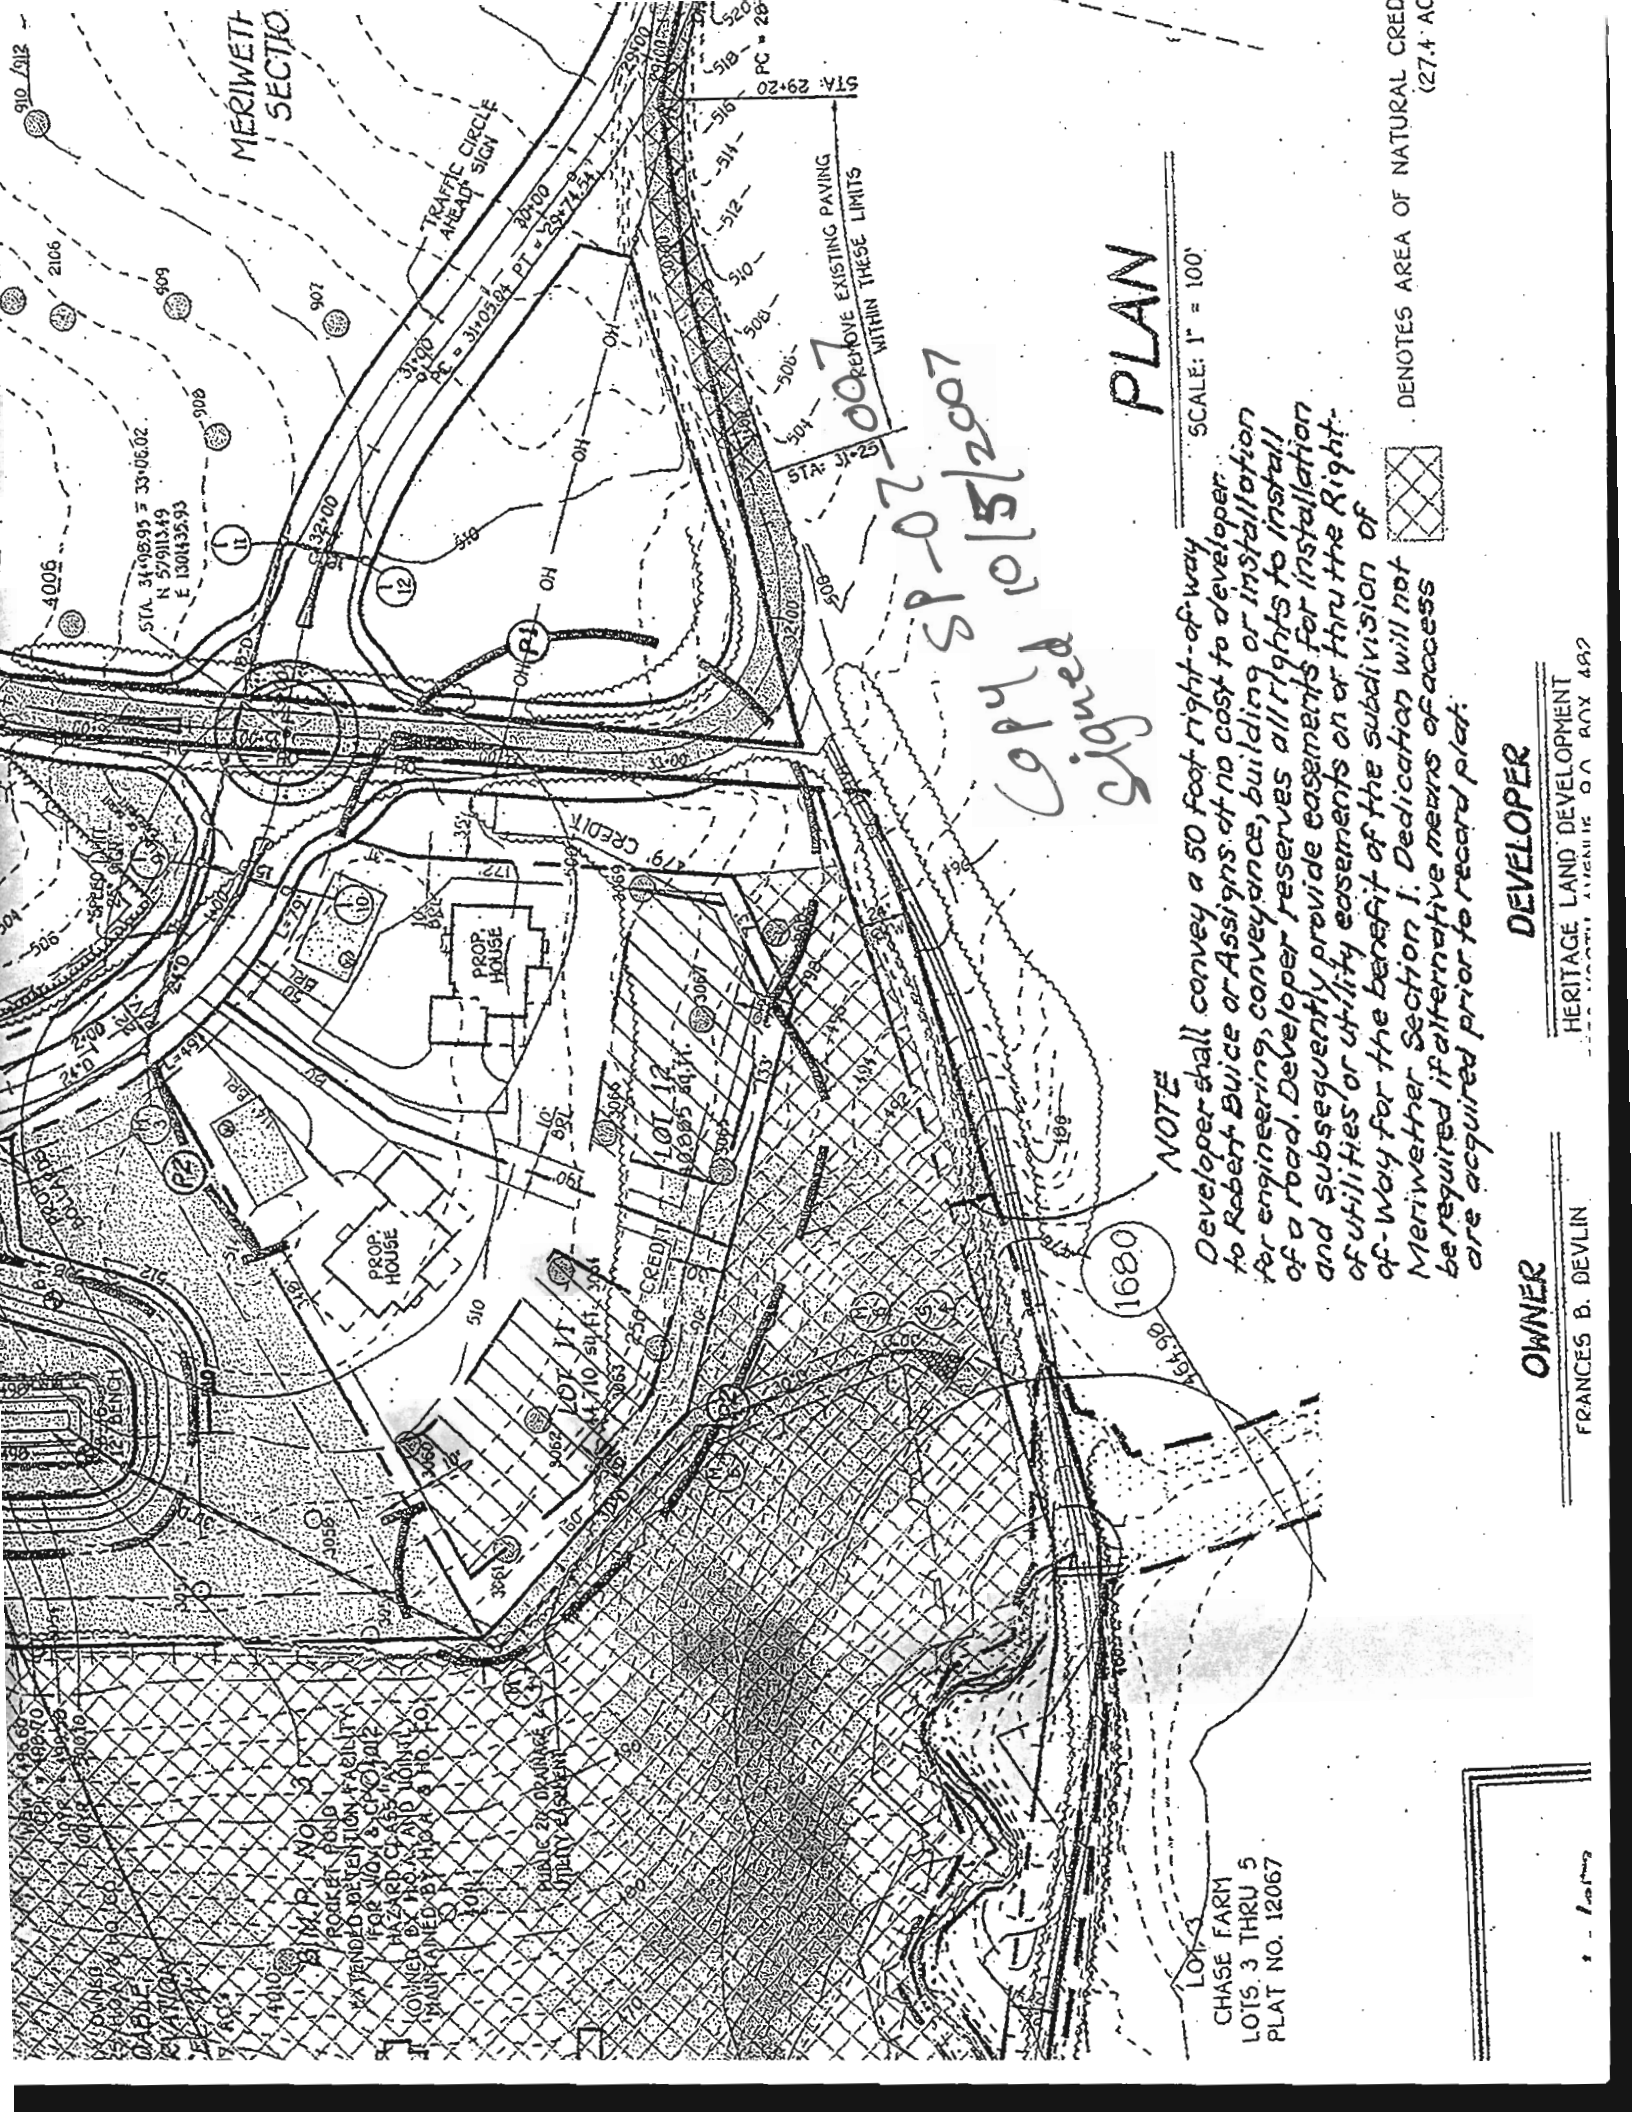

MERIWETHER SECTION

TRAFFIC CIRCLE  
AHEAD SIGN

REMOVE EXISTING PAVING  
WITHIN THESE LIMITS

PLAN

SCALE: 1" = 100'

NOTE

Developer shall convey a 50 foot right-of-way to Robert Buice or Assigns at no cost to developer for engineering, conveyance, building or installation of a road. Developer reserves all rights to install and subsequently provide easements for installation of utilities or utility easements on or thru the Right-of-Way for the benefit of the subdivision of Meriwether Section 1. Dedication will not be required if alternative means of access are acquired prior to record plat.



DENOTES AREA OF NATURAL CREDIT (27.4 AC)

OWNER

FRANCES B. DEVLIN

DEVELOPER

HERITAGE LAND DEVELOPMENT  
HERITAGE AVENUE, O.A. BOX 482

LOTS  
CHASE FARM  
LOTS 3 THRU 5  
PLAT NO. 12067

Copy 10/5/2007  
signed

PROPOSED DEVELOPMENT FACILITIES  
FOR WAYS & CROSSLINGS  
HAZARDOUS CLASSIFICATION  
CONDUCTED BY HOVA AND JOINT  
PUBLISHED BY HOVA & HO, INC.  
PUBLIC ZONING DEPARTMENT  
CITY OF DENVER