

AVP 5173

Brown L
 Orange/Brown
 Sel w/ 25% coarse chd from
 Red/Brown
 SL
 Yellow/Brown
 SL w/ trace Red

1'
 3 1/2'
 7 1/2'
 12'

5174


Brown L
 Brown/Orange
 Sel
 Brown/Yellow
 Red
 SL
 Yellow/Brown
 SL
 w/ trace Red

1 1/2'
 4'
 8'
 12'

5172

Brown L
 Orange/Brown
 Sel
 Yellow/Brown
 SL
 Yellow/Brown
 S
 w/ trace Red

1/2'
 4'
 12'

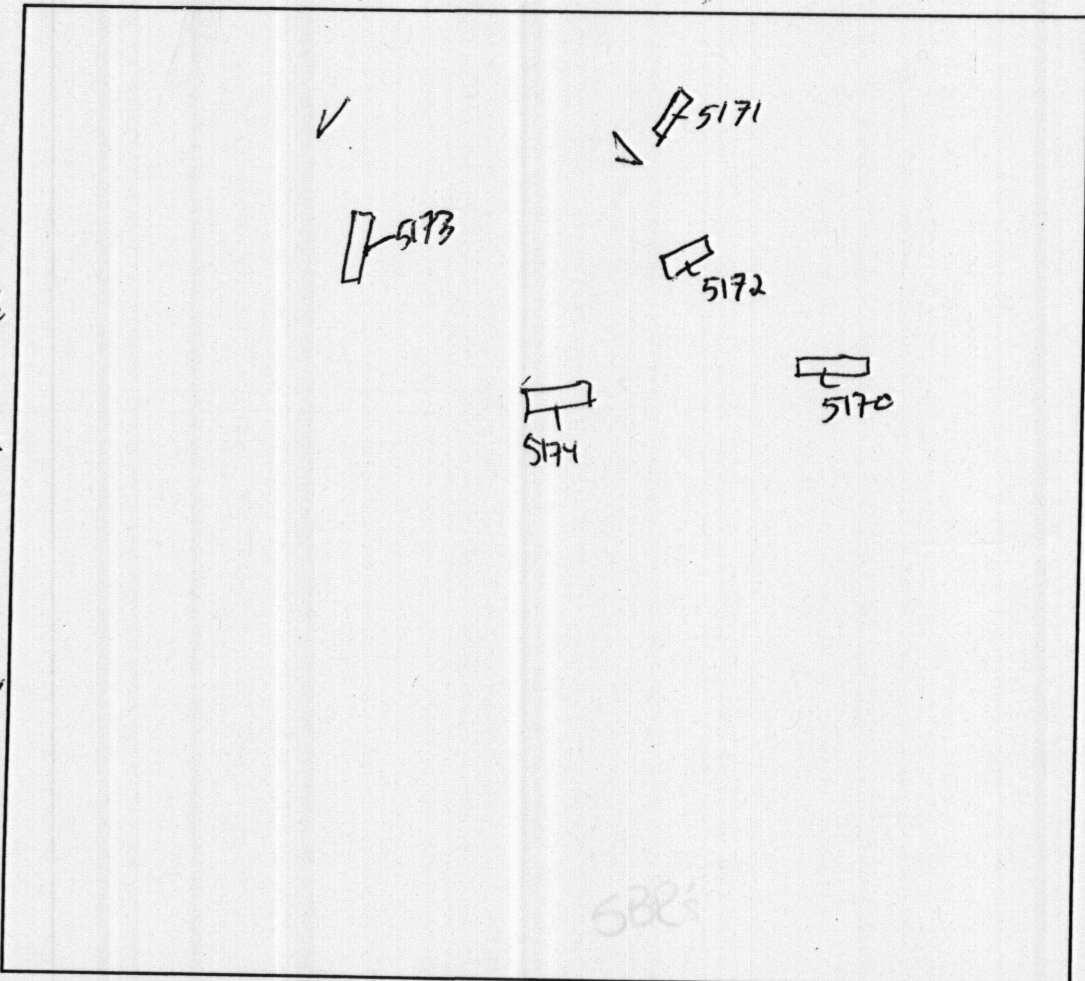

5171
 Brown L
 Orange/Brown
 Sel
 Yellow/Brown
 SL
 Orange/Brown
 S
 w/ trace Red

5170
 Brown L
 Red/Brown
 heavy
 Sel
 Orange/Brown
 Red
 SL
 Yellow/Brown
 SL
 w/ trace Red


DATE	TEST #	DEPTH	START	BREAK 1" DROP	STOP 2" DROP	TIME OF 2nd INCH	P/F/H
9/15/05	5173	4' / 12'	10:08	10:09	10:11	2nu	P
	5174	4 1/2' / 12'	10:13	10:16	10:24	8mir	P
	5172	4' / 12'	10:16	10:20	10:28	8mis	P
	5171	5' / 10'	10:27	10:30	10:34	4mis	P
	5170	4' / 11'	10:34	10:36	10:38	2mir	P
			10:37				

REMARKS lot 73 5170 shared w/ lot 22

SANITARIAN _____ BACKHOE _____ OTHERS _____

TEST HOLES USED IN SDA _____ AVG. PERC TIME _____ SQ. FT/BR _____

TRENCH WIDTH _____ INLET DEPTH _____ MAX. BOT DEPTH _____ EFFECTIVE S/W _____

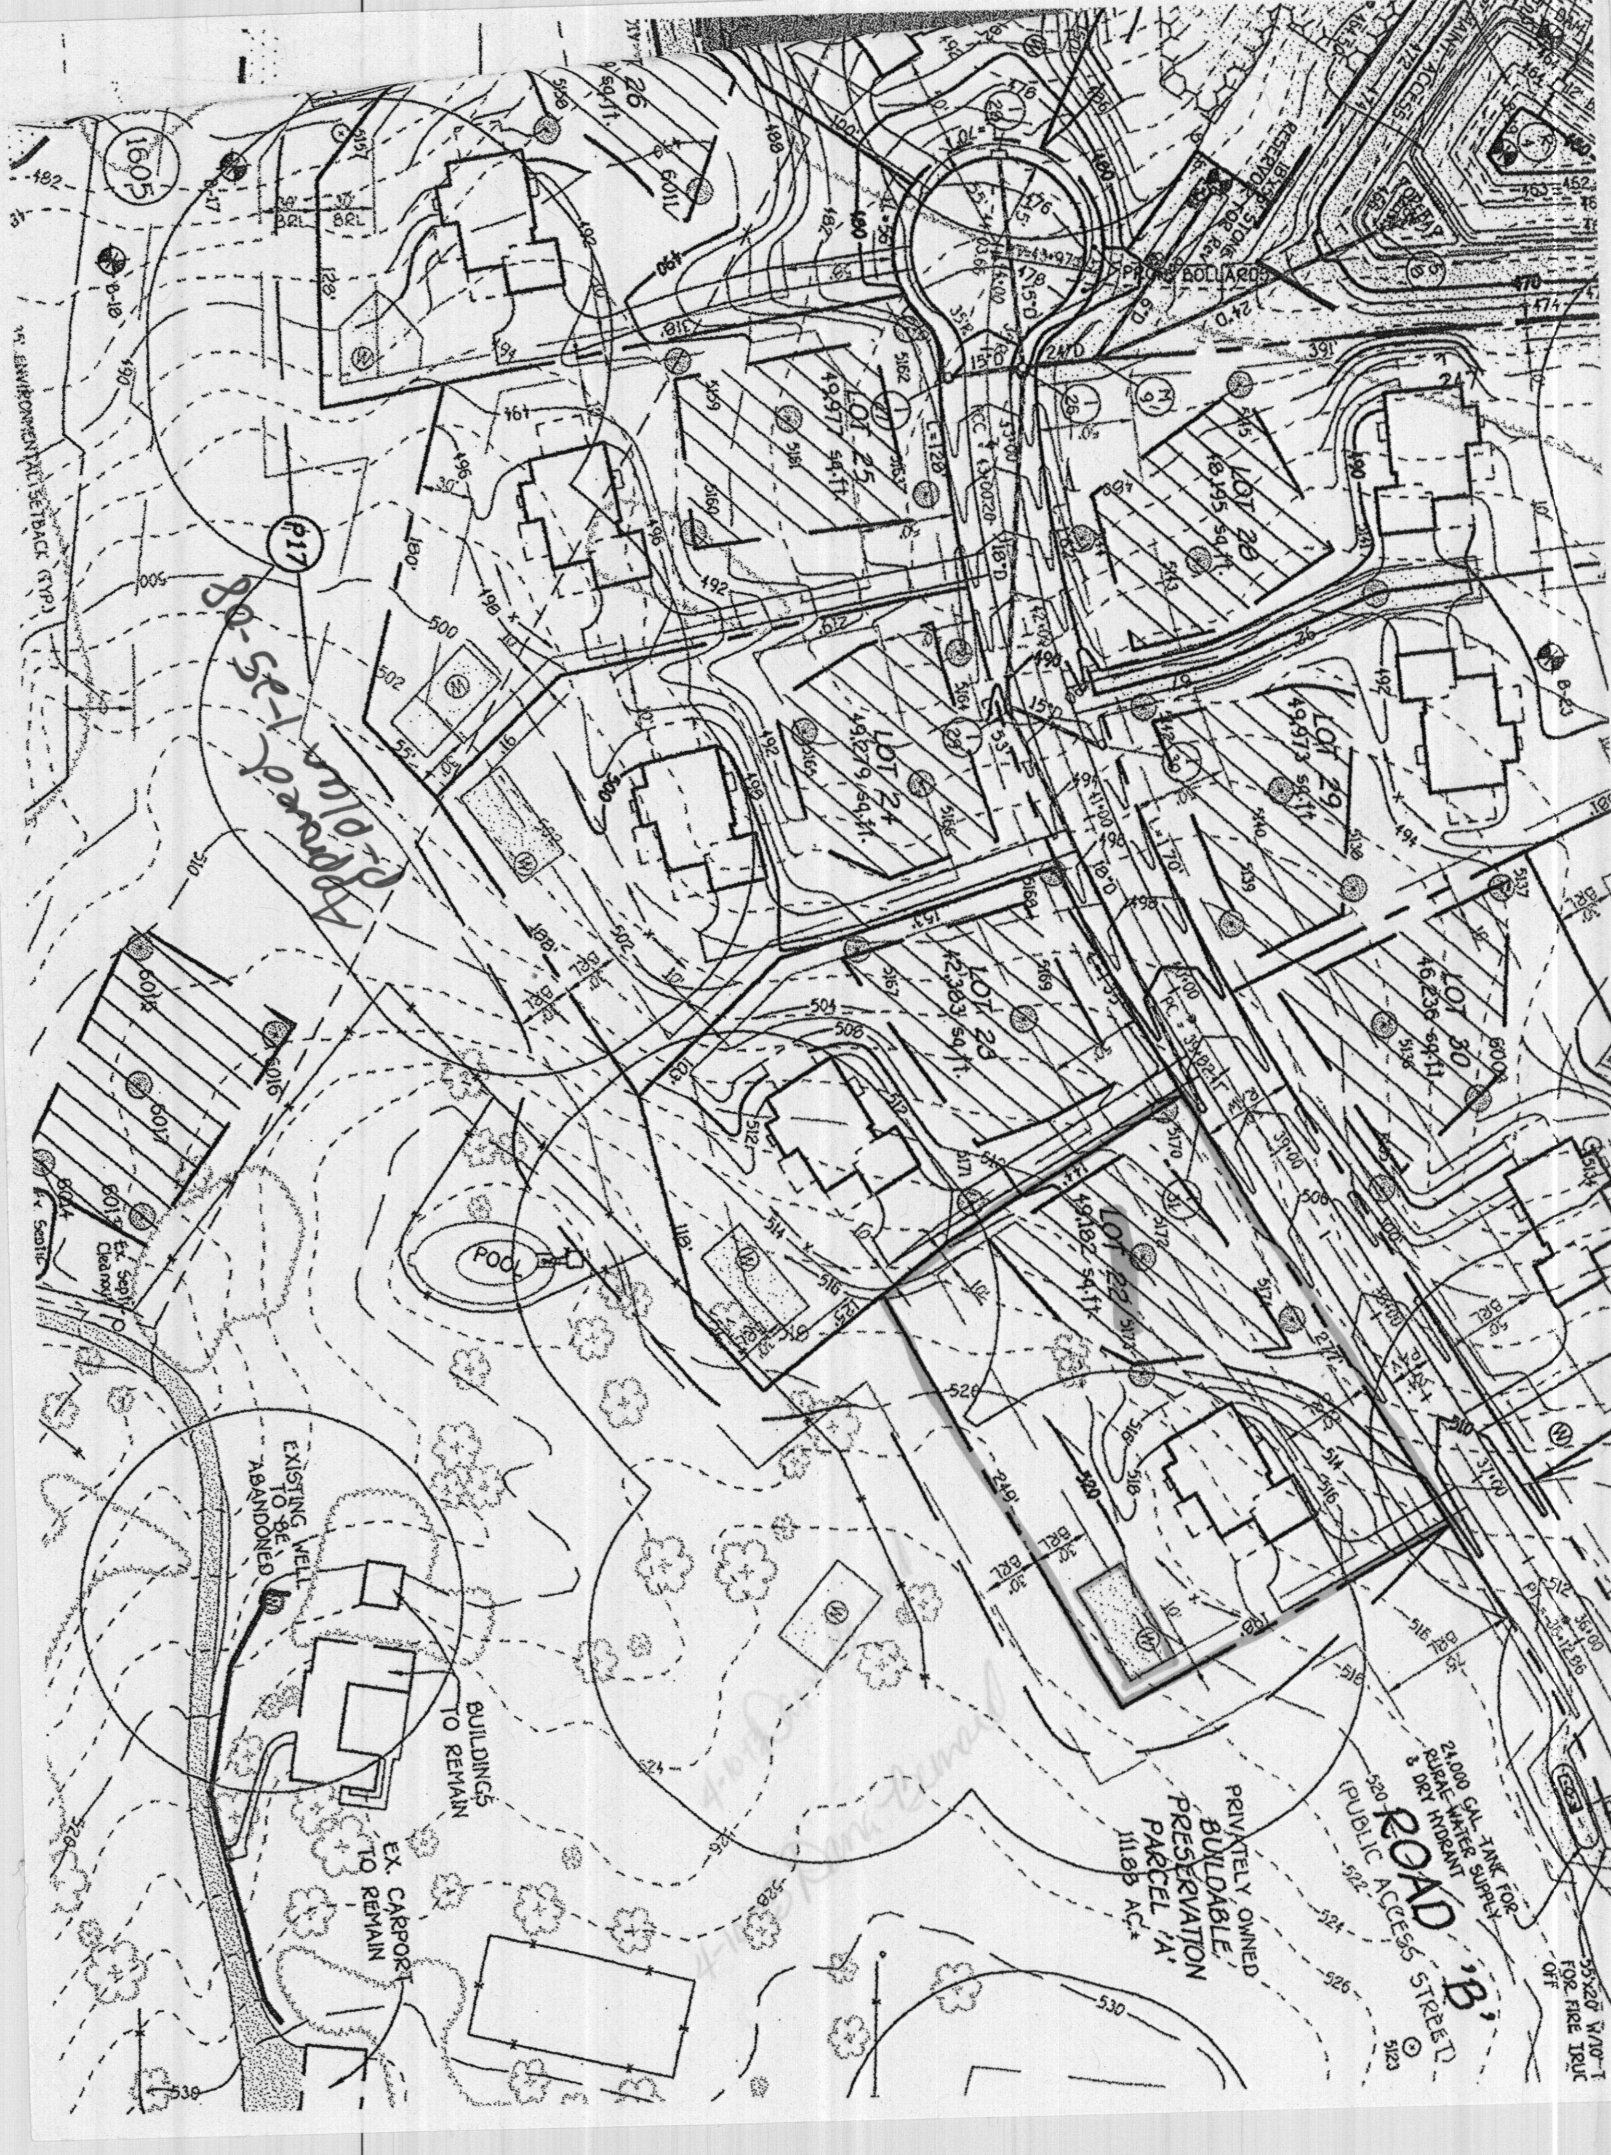

Private 1-25-88

EXISTING WELL
TO BE
ABANDONED

BUILDINGS
TO REMAIN

EX. CARPORT
TO REMAIN

PRIVATELY OWNED
BUILDABLE
PRESERVATION
PARCEL 1A
111.88 AC.

ROAD B
(PUBLIC ACCESS STREET)

21,000 GAL. TANK FOR
PURE WATER SUPPLY
& DRY HYDRANT

55x20' W/OT
FOR FIRE DEPT
OFF

1/4" ENVIRONMENTAL SETBACK (17P)

530

1605

P17

POOL

125

191

500

502

501

501

125

191

500

502

501

501

125

191