

Approved Septic System Plan
 Howard County Health Department


[Signature]
 Date: 11/31/12
 B2002161

SCALE
 1" = 50'

THE EXISTING WELL SHOWN ON LOT 33 TAG NO. 95-0461 HAS BEEN FIELD LOCATED BY ROBERT H. VOGEL ENGINEERING, INC., AND IS ACCURATELY SHOWN.

BUILDING OF LOT 33 FLOOR AREAS:
 BASEMENT FLOOR AREA: 1410
 FIRST FLOOR AREA: 1440
 SECOND FLOOR AREA: 1930
 BEDROOMS: 4

NOTE: STORMWATER MANAGEMENT FOR THIS LOT IS PROVIDED BY 2 MICRO-POOL EXTENDED DETENTION PONDS AND ONE BIO-RETENTION FACILITY APPROVED UNDER F-06-130
 BUILDING PERMIT NO. _____

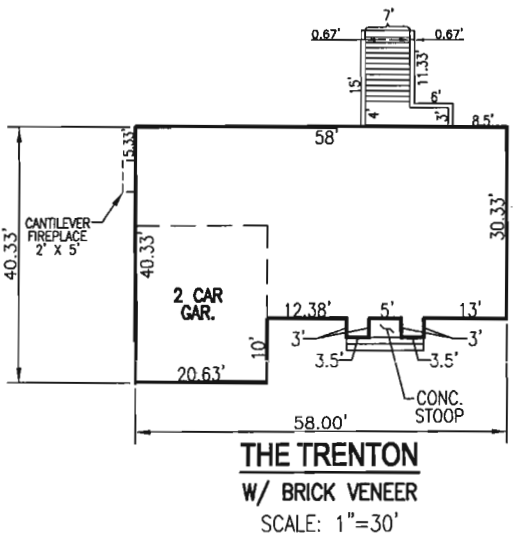


SCALE: AS SHOWN
 DRAWN BY: JMR
 CHECKED BY: RHV
 DATE: DECEMBER 2012
 PROJECT #: 2017085
 SHEET#: 1 OF 1

PLOT PLAN
CASTLEBERRY AT
TEN OAKS
LOT 33
REF: F-06-130
 TAX MAP 22 PARCEL 90
 BLOCK 19
 5TH ELECTION DISTRICT
 HOWARD COUNTY, MARYLAND

ADDRESS
 4031 CANDLE LIGHT DR.
 DAYTON, MD 21036
 GP: 10-52

OWNER
 CASTLEBERRY AT TEN OAKS, LLC.
 3675 PARK AVENUE, SUITE 301
 ELLICOTT CITY, MARYLAND 21043
 (410) 740-9401

ROBERT H. VOGEL ENGINEERING, INC.
 ENGINEERS • SURVEYORS • PLANNERS
 8407 MAIN STREET ELLICOTT CITY, MD 21043 TEL: 410.461.7666 FAX: 410.461.8961

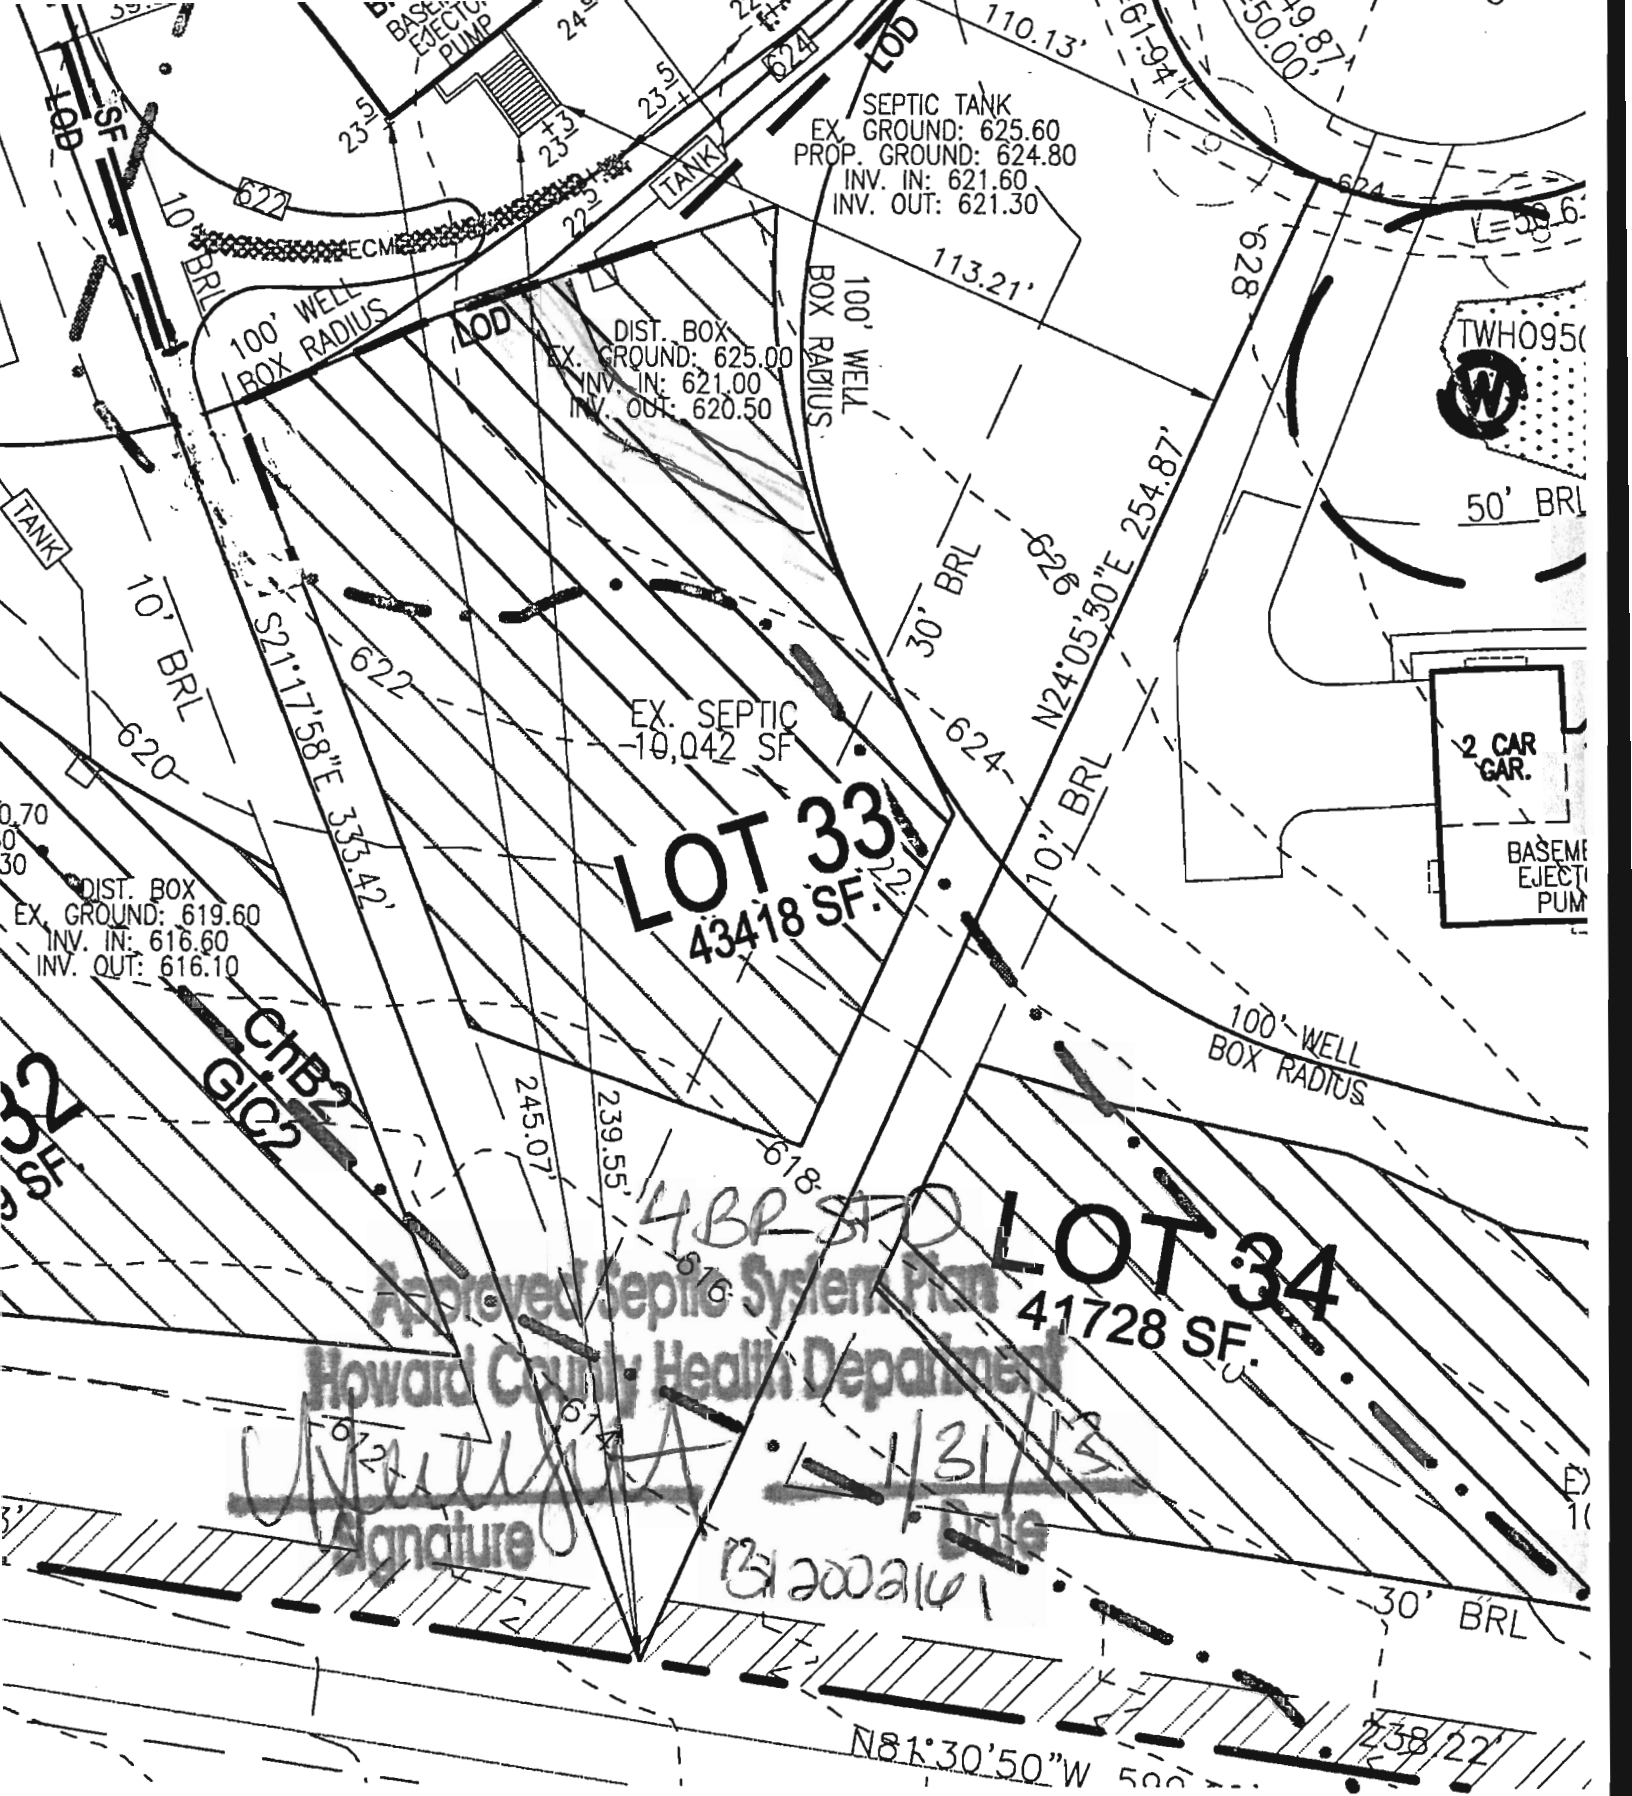

LOT 33
43418 SF.

LOT 34
41728 SF.

Approved Septic System Plan
Howard County Health Department

[Handwritten Signature]
Signature

11/31/13
Date

1312002141

SCALE

1"=50'

0.67'

15'

58'

ON LOT 33
BEEN FIELD LOCATED
GINEERING, INC..



dedicated to excellence and service

January 9, 2013

RE: Building Permit #B12002161
Lot #33 Castleberry at Ten Oaks
13800 Point Breeze Dr.
Dayton, MD 21036

Attn: Plan Review

Please approve the following changes to above permit. House type change to a Trenton, 2 story, full basement, ~~3~~ rooms (4 bed, 2.5 baths), Fire place, 2 car garage.

2 sets of construction drawings are included.

Please call when approved.

Thank you,

Sherry Mewshaw
Trinity Quality Homes
410-531-5813

cc: Heather
PED
PFZ

Check # 27466
invoice # 305054

RECEIVED

JAN 15 2013

LICENSES & PERMITS
DIVISION