

AP 5139

Brown L 1'

Red/Orange Heavy Sol 4'

Red/Orange SL w/ trace Red 6 1/2'

Yellow/Red Sol trace Red 11 1/2'

5140

Brown L 1'

Red/Orange Heavy Sol 5'

Yellow/Red SL 9'

Yellow/Red SL w/ trace Red 12'


5141

Brown L 1'

Orange/Red Brown Sol 4'

Red/Brown SL 5 1/2'

Yellow/Red SL w/ trace Red 13'

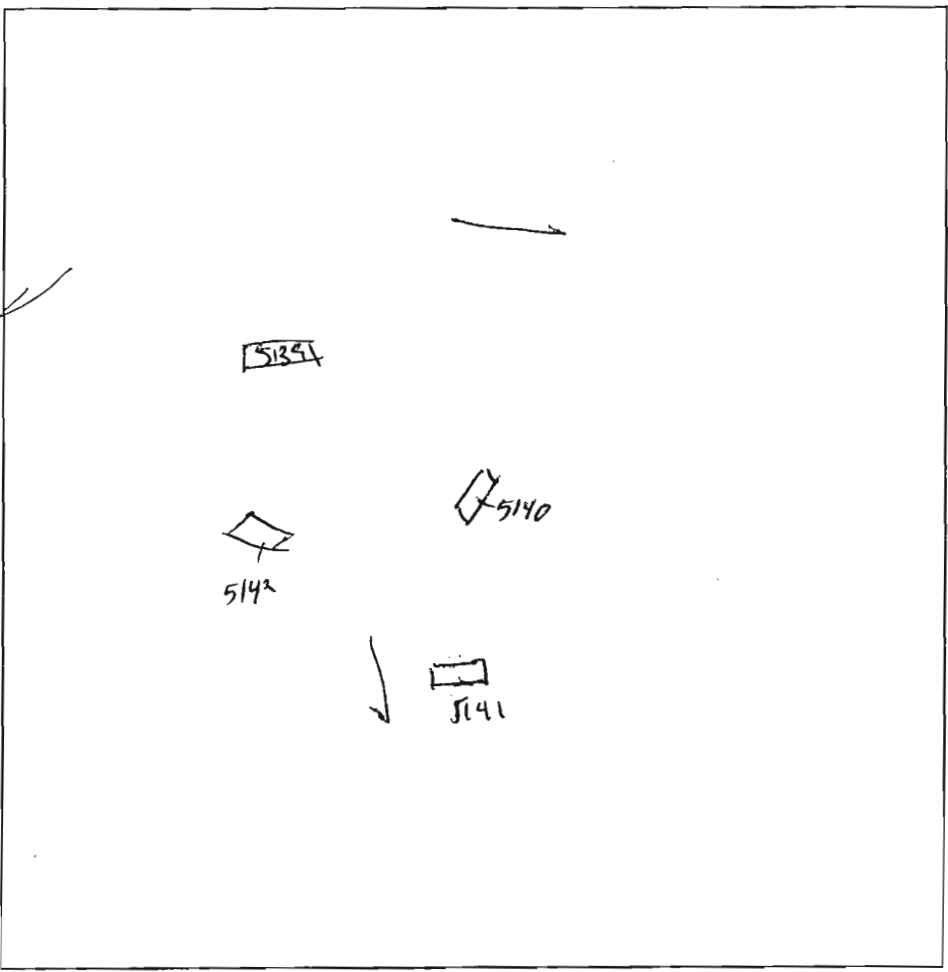

5142

Brown L 1/2'

Red/Brown Sol 4'

Yellow/Red SL w/ trace Red 12'

DATE	TEST #	DEPTH	START	BREAK 1" DROP	STOP 2" DROP	TIME OF 2nd INCH	P/F/H
9/15/05	5139	4 1/2' / 11 1/2'	11:44	11:44	11:59	10min	P
	5140	5' / 12'	11:47	11:52	12:02	10min	P
	5141	4' / 13'	12:54	12:57	1:03	6min	P
	5142	4 1/2' / 18'	2:43	2:46	2:49	3min	P

REMARKS lot 65

SANITARIAN _____ BACKHOE _____ OTHERS _____

TEST HOLES USED IN SDA _____ AVG. PERC TIME _____ SQ. FT/BR _____

TRENCH WIDTH _____ INLET DEPTH _____ MAX. BOT DEPTH _____ EFFECTIVE S/W _____

**COMPLETE THIS FORM WHEN DROPPING OFF ANY
CORRESPONDENCE AND/OR PLANS TO THE HOWARD COUNTY
DEPARTMENT OF INSPECTIONS, LICENSES AND PERMITS COUNTER:**

Date: 9/27/13
 To: Build Development - Sydonia
 (Person's Name and Division)
 From: Jeremy Clancy 443,3401229
 (Your Name, Company Name and Telephone Number)
 Subject: Project name _____
 Project site address 14908 Meriwether Drive
 Permit Number 313 8442 SDP # _____
 (System down)
 Other information pertinent to this project _____

Please check the attachments below that you are submitting with this transmittal:

- Letter of response to Howard County plan review code letter
- Revised plans and/or revised details: When submitting for a complete re-review, **duplicate sets shall be submitted.**
Per comments tank location revised
- Structural steel certification
- Energy conservation calculations
- Certification for _____ (be specific).
- Copies of _____ (be specific).
- Two sets of single family dwelling model plans to be placed on permanent file: Model name and/or # _____
- Other _____

RECEIVED
 9/27/2013
 LICENSES & PERMITS
 DIVISION

Is there anyone else that should be contacted regarding this project if there are questions?

If so, please list that person's name and telephone number below:

Jeremy Clancy 443,3401229
 (Person's name) (Telephone number)

PLEASE ASSURE ALL DOCUMENTS AND/OR REVISIONS ARE APPROPRIATELY SIGNED AND SEALED, IF NECESSARY, BY A LICENSED ARCHITECT OR ENGINEER. PLEASE BE ADVISED THAT INSUFFICIENT INFORMATION MAY RESULT IN THE DELAY OF REVIEW BY THE PLANS EXAMINER. THE DEPARTMENT OF INSPECTIONS, LICENSES AND PERMITS WILL CONTACT YOU IF THERE IS A PROBLEM. IN ADDITION, ONCE THE BUILDING PERMIT IS APPROVED BY THE PLAN REVIEW DIVISION AND ALL OTHER REQUIRED SIGNATORY AGENCIES, AND THE BUILDING PERMIT IS READY FOR ISSUANCE, THE PERMIT DIVISION WILL NOTIFY THE APPROPRIATE CONTACT PERSON FOR PERMIT PICK UP. ALL PERMIT STATUS INQUIRIES SHALL BE DIRECTED TO THE PERMIT DIVISION AT 410-313-2455. CODE RELATED QUESTIONS AND PLAN REVIEW INQUIRIES SHALL BE DIRECTED TO THE PLAN REVIEW DIVISION AT 410-313-2436. PLEASE ALLOW A MINIMUM OF FIVE (5) WORKING DAYS FOR ANY PLAN SUBMITTALS TO BE REVIEWED. THANK YOU.

Received by cha CC: Heather

white: Plan Review Division
 yellow: Applicant
 pink: Permit Division

413.74
1-1079

Wetland Buffer

*Approved plan
1/2 5/08*

FOREST PRESERVATION
16.5 AC. (10%)
20.06 AC. (13%)
12.18 AC. (7.5%)
TOTAL 48.74 AC. (30.5%)

PRIVATELY OWNED
EASEMENT HOLDERS' H.O.A. & HO. CO., MD.
**BUILDABLE
PRESERVATION
PARCEL 'A'**
111.88 AC.*

ORDER H.O.A. PUBLIC 6-W.M. DRAINAGE &
EASEMENT HOLDER HO. CO. MD. UTILITY EASEMENT

**NON-BUILDABLE
PRESERVATION
PARCEL 'F'**
132 AC.*


CREDIT

35' ENVIRONMENTAL
SETBACK (TYR.)

No. 1-1
RETENTION POND
WAY & COPY
2D CLASS A
MAINTAINED BY H.O.A.
24' POOL = 461.50
No. STORAGE IS NOT REQ'D.


B.M.P. No. 10
LEVEL SPREADER
280'

580250

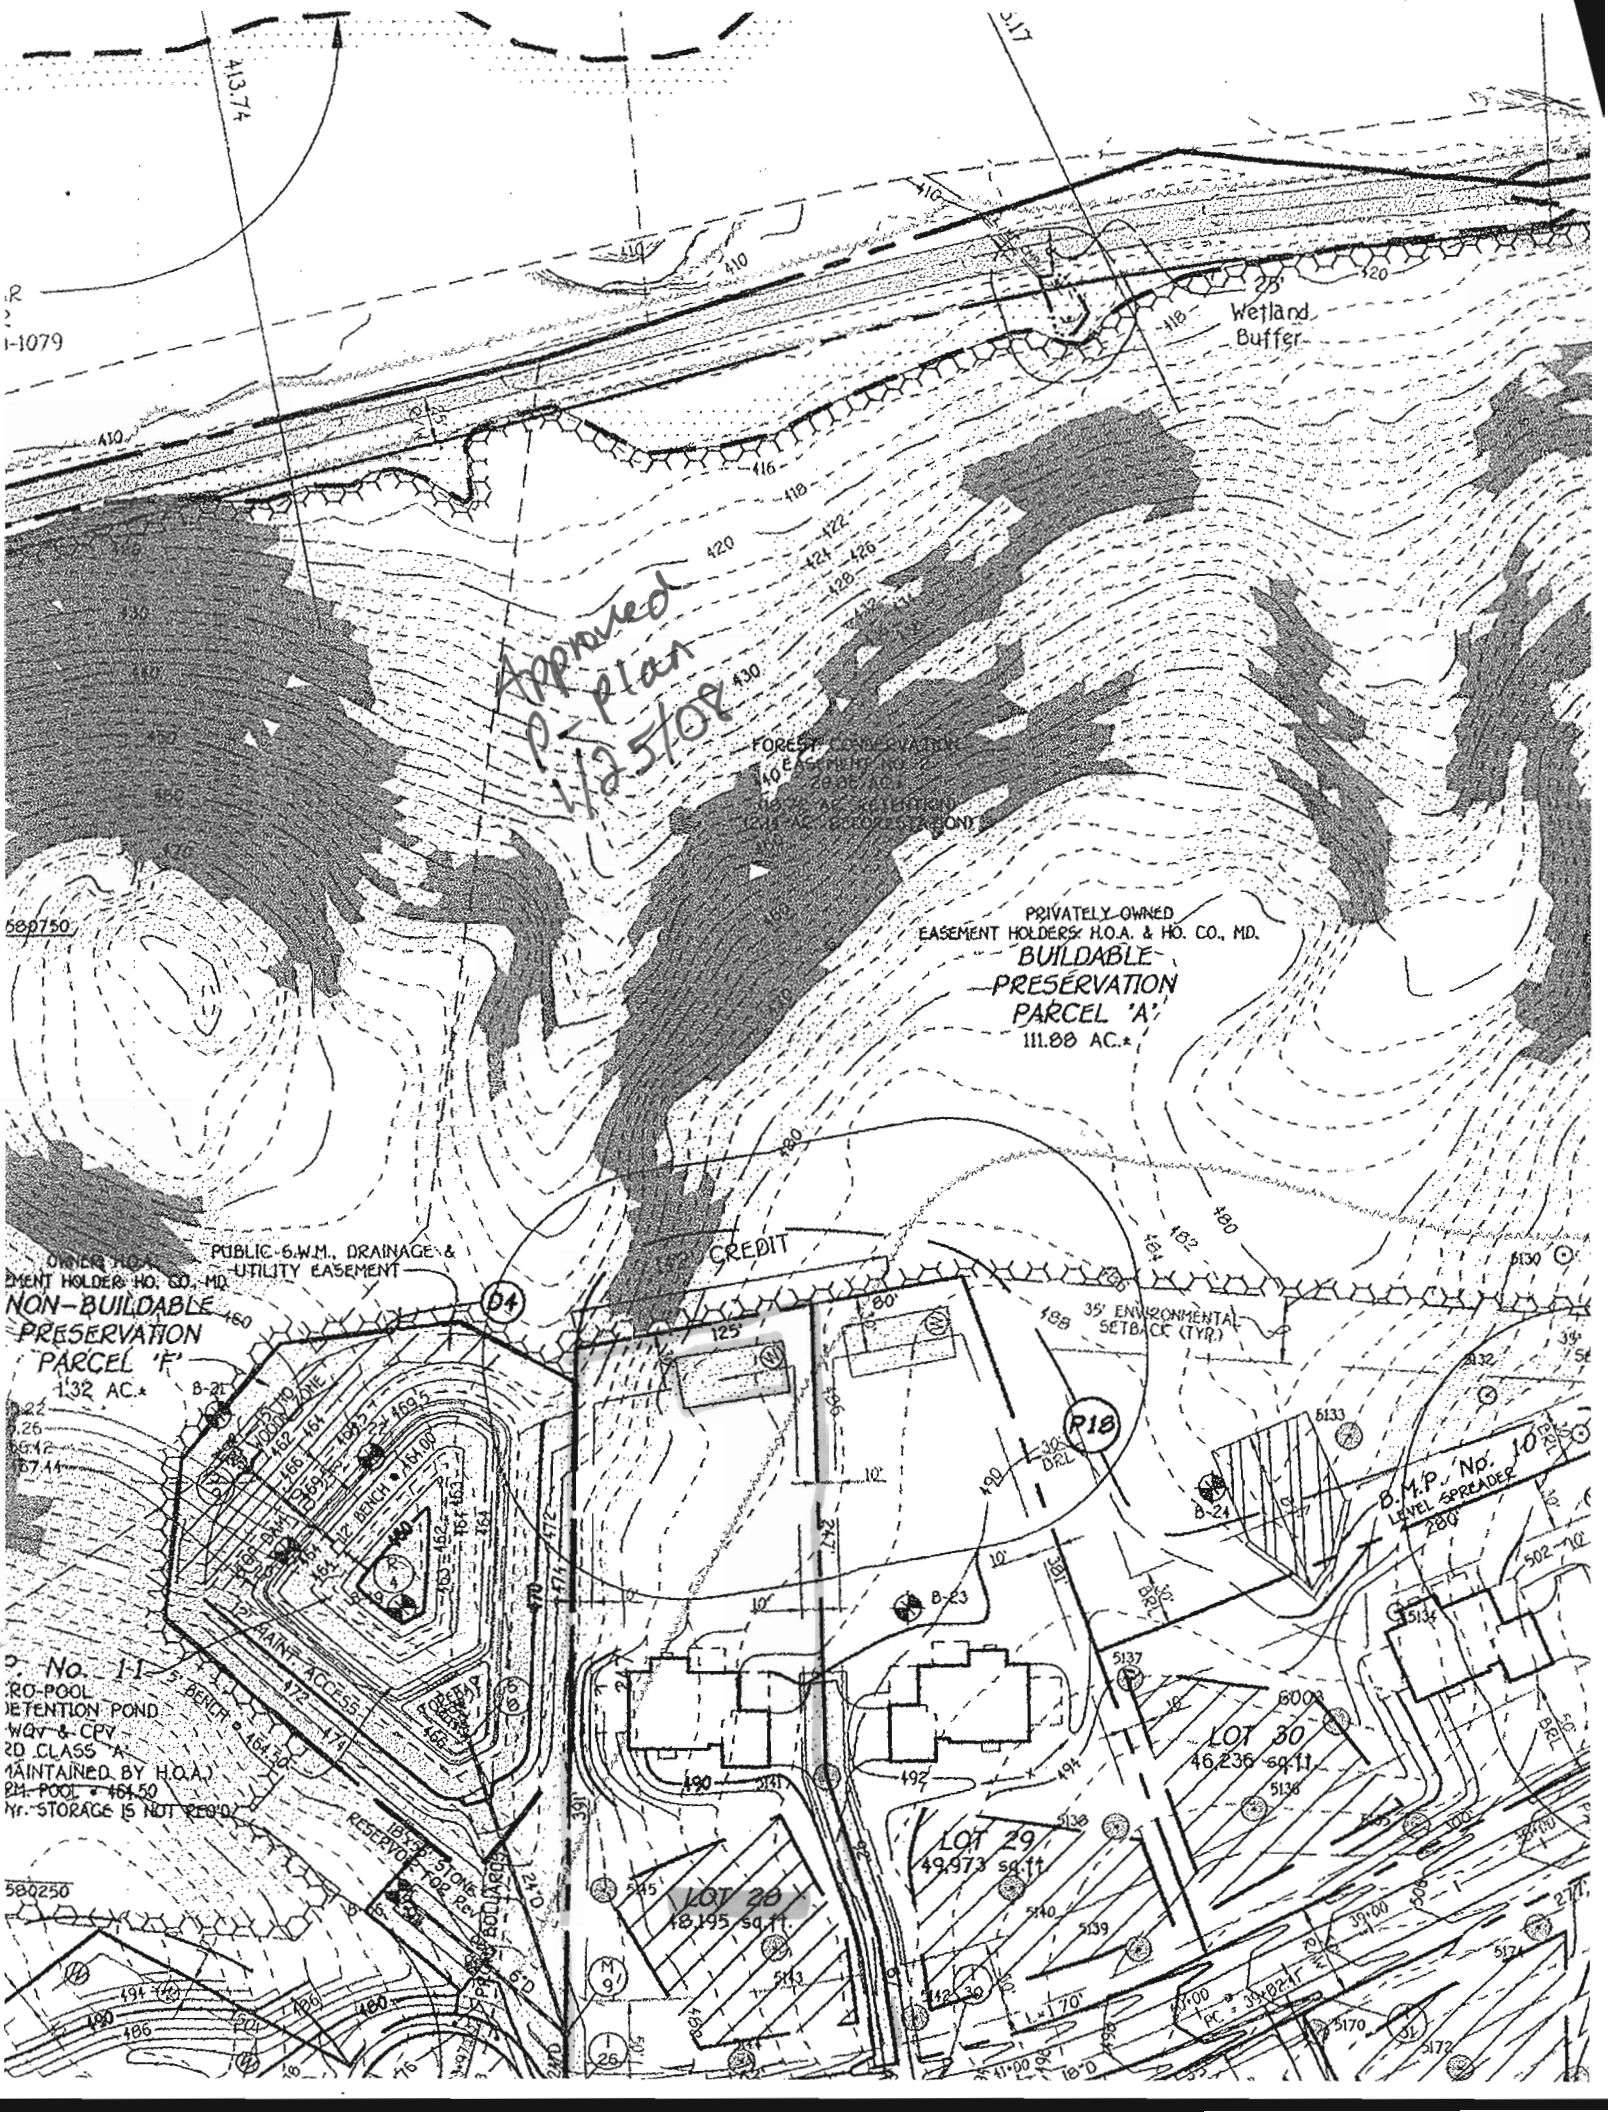

AP 5143

Brown
L
Red/Orange
Sol 1 1/2'
Yellow/Brown
SL (4)
w/ trace
Rock

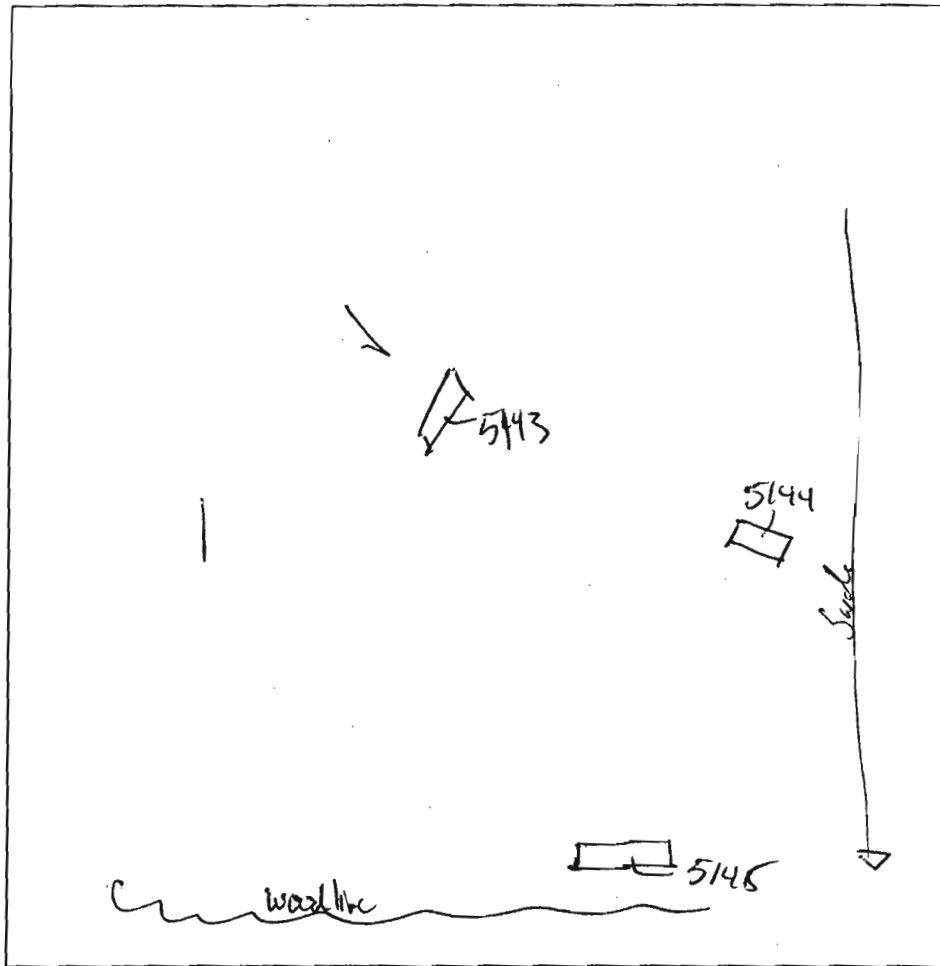

5144

Brown
L
Orange/Brown
Red
Sol 1'
Yellow/Brown
SL 4'
Yellow/gray
Brown
SL w/ mottling
F-2 10'
H₂O 11'
12'

5145

Brown
L 1/2'
Orange/Red
Sol 4 1/2'
Yellow/Brown
SL
w/ trace
Rock

DATE	TEST #	DEPTH	START	BREAK 1" DROP	STOP 2" DROP	TIME OF 2nd INCH	PIF/H
9/15/05	5143	4' / 12'	1:06	1:09	1:12	9 min	P
	5144	4' / 12'	1:09	1:19	1:26	7 min	P
	5145	4 1/2' / 11'	1:21	1:24	1:29	5 min	P

REMARKS _____

SANITARIAN _____ BACKHOE _____ OTHERS _____

TEST HOLES USED IN SDA _____ AVG. PERC TIME _____ SQ. FT/BR _____

TRENCH WIDTH _____ INLET DEPTH _____ MAX. BOT DEPTH _____ EFFECTIVE SW _____

THE EXISTING WELL(S) SHOWN ON THIS PLAN (IDENTIFIED WITH THE ATTACHED WELL TAG NUMBER HO-95-2166 HAS BEEN FIELD LOCATED BY ESE CONSULTANTS, INC. PROFESSIONAL LAND SURVEYOR(S), AND IS ACCURATELY SHOWN.

BUILDING SETBACKS (B.R.L.'s) SHOWN HEREON PER SITE DEVELOPMENT PLAN SETBACK DISTANCES SHOWN HEREON AS "±" HAVE AN ACCURACY OF ±0.1' FOOT.

THIS AREA DESIGNATES A PRIVATE SEWAGE EASEMENT OF AT LEAST 10,000 SQ. FT. AS REQUIRED BY THE STATE DEPARTMENT OF THE ENVIRONMENT FOR INDIVIDUAL SEWAGE DISPOSAL IMPROVEMENTS OF ANY NATURE IN THIS AREA IS RESTRICTED UNTIL PUBLIC SEWER IS AVAILABLE. THIS EASEMENT SHALL BECOME NULL AND VOID UPON CONNECTION TO A PUBLIC SEWAGE SYSTEM. THE COUNTY HEALTH OFFICER SHALL HAVE THE AUTHORITY TO GRANT ADJUSTMENTS TO THE PRIVATE SEWAGE EASEMENT. ANY CHANGES TO A PRIVATE SEWAGE EASEMENT SHALL REQUIRE A REVISED PERCOLATION CERTIFICATION PLAN. RECORDATION OF A MODIFIED EASEMENT PLAT SHALL NOT BE NECESSARY.

THE LOT SHOWN HEREON WAS RECORDED ON THE PLAT FOR MERIWETHER FARMS, PLAT No. 21769, ET SEQ. REFER TO THIS PLAT FOR ANY RESTRICTIONS AND/OR PROVISIONS.

SWM FOR THIS LOT IS MANAGED PER PLAN F-09-044

E & S CONTROLS PER PLAN F-09-044

CULVERT FOR DRIVEWAY PER F-09-044

ADDRESS: 14908 MERIWETHER DRIVE
GLENELG, MD 21737


TOPOGRAPHIC INFORMATION ESTABLISHED AT TWO FOOT INTERVALS BASED ON AERIAL TOPOGRAPHY PROVIDED TO ESE BY FISHER, COLLINS & CARTER, INC.

INV. HOUSE	486.9
GROUND INV. HOUSE	490.0
INV. IN TANK	484.9
INV. OUT TANK	484.7
TOP OF TANK	485.7
GROUND OVER TANK	488.2
INV. IN DIST. BOX	484.5
INV. OUT DIST. BOX	484.2
GROUND BOX	488.2

BASEMENT DOES NOT GRAVITY SEWER

THE INITIAL SEPTIC SYSTEM DISTRIBUTION TRENCHES MUST BE INSTALLED IN THE UPPERMOST PORTION OF THE SEPTIC RESERVE AREA.

IF THE ELEVATION OF THE HOUSE SEWER IS DIFFERENT THAN THAT SHOWN ON THIS PLAN AT TIME THAT THE SEWER HOUSE CONNECTION (SHC) IS COMPLETED, THE ATTENDING ENVIRONMENTAL SANITARIAN MAY REQUIRE INSTALLATION OF A PUMP AND PUMP CHAMBER TO DELIVER SEPTIC TANK EFFLUENT TO THE UPPERMOST PORTION OF THE SEPTIC RESERVE AREA.

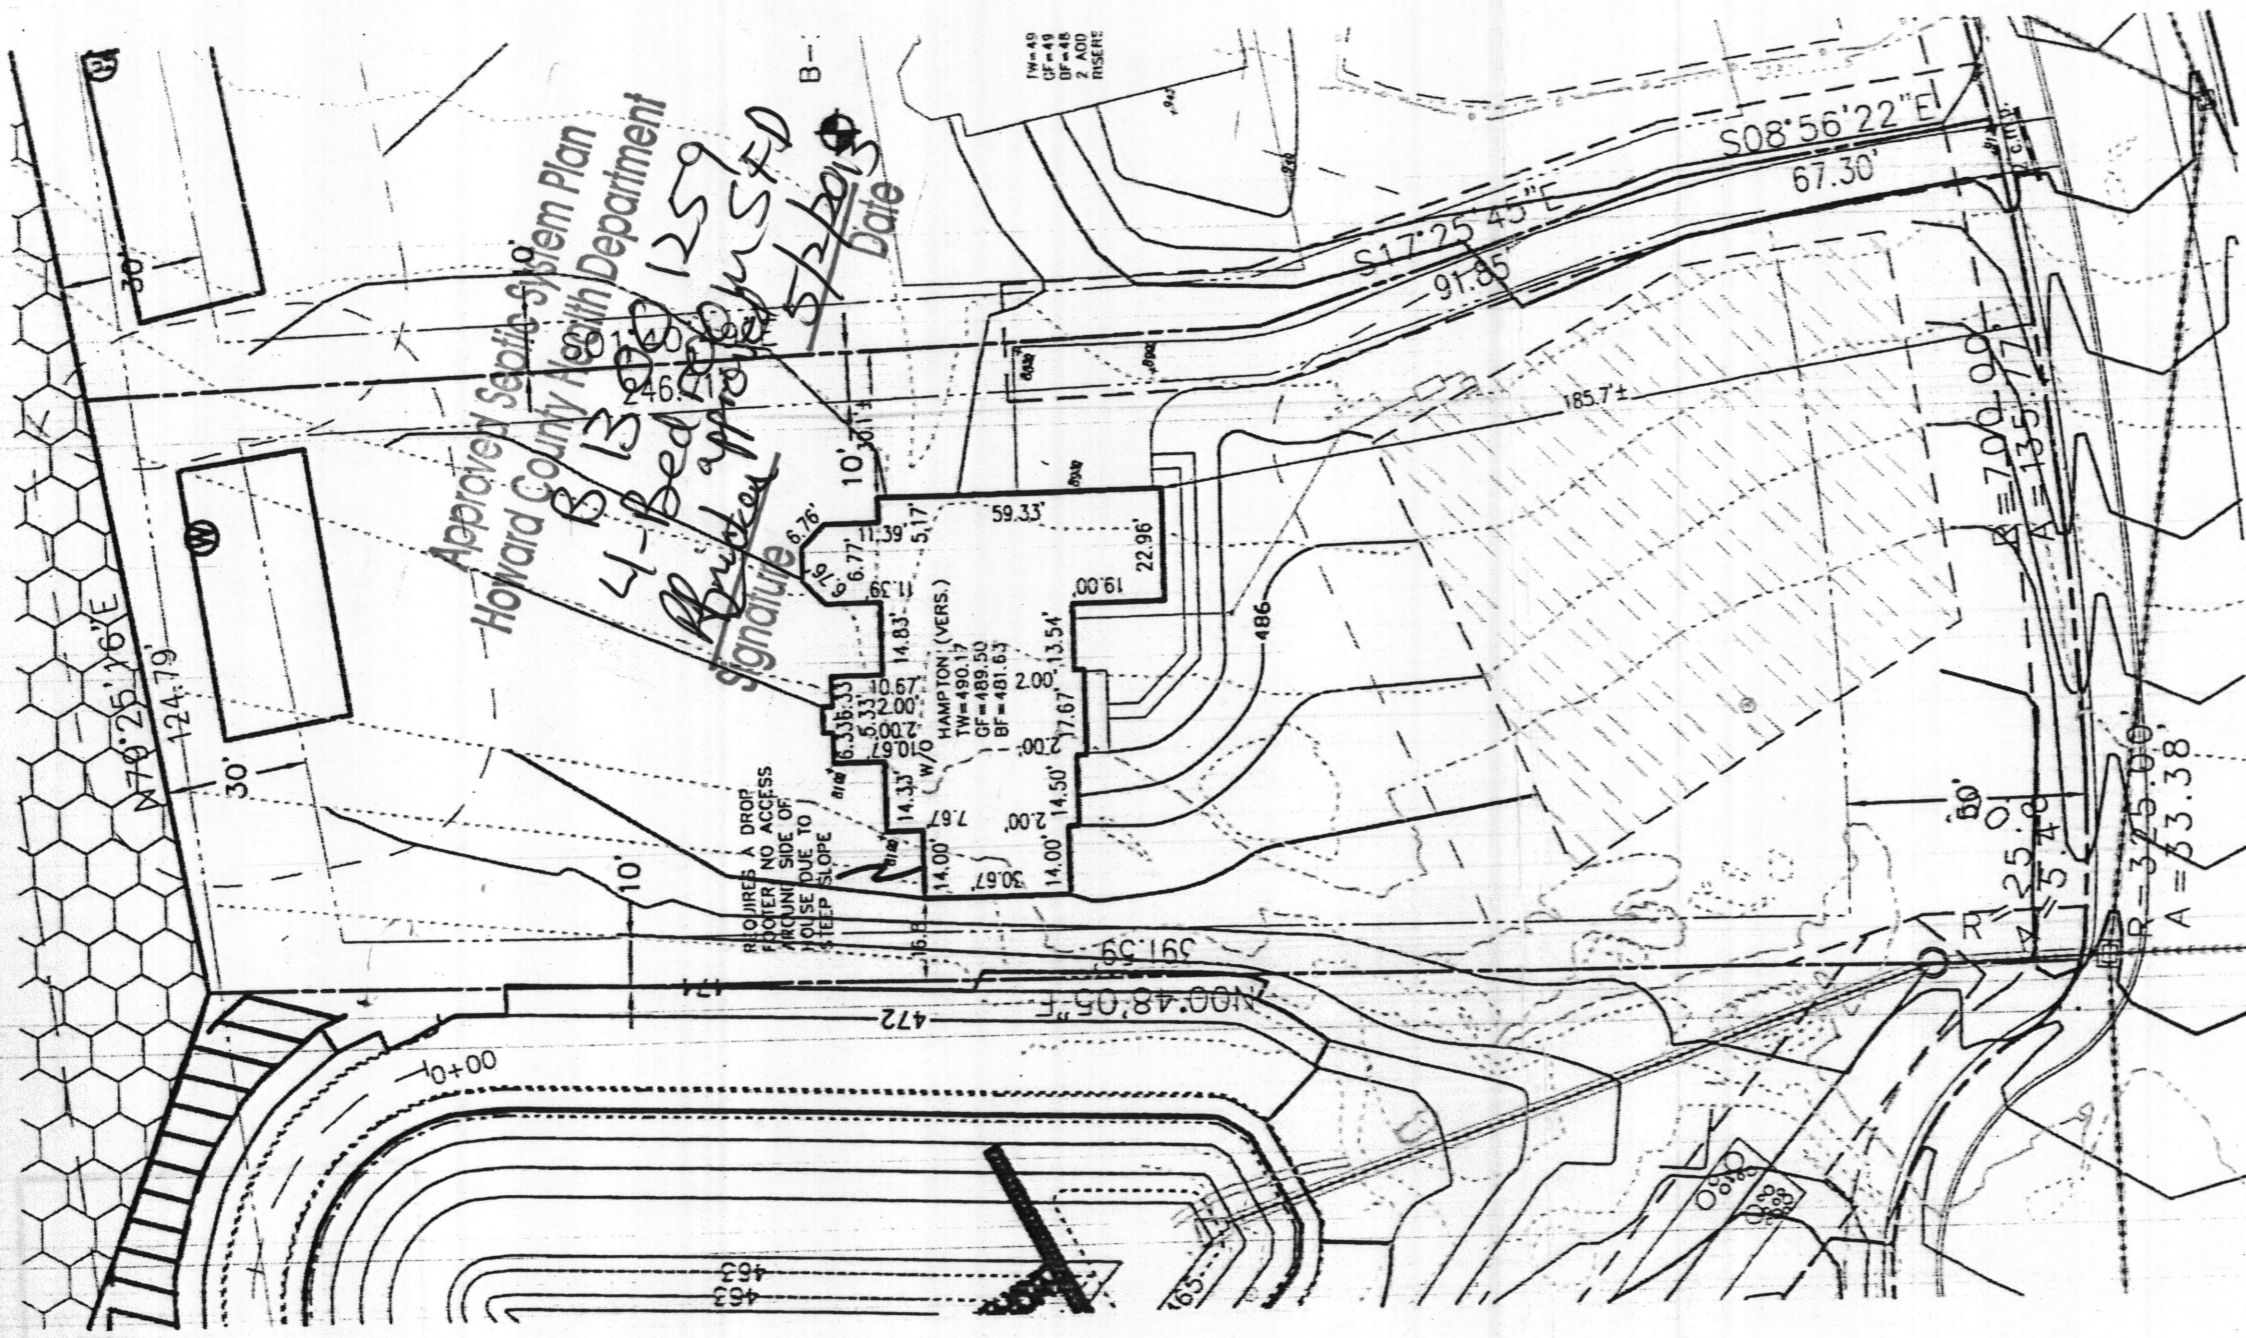

Approved Septic System Plan
 Howard County Health Department
 B-13
 41-Bed Septic Tank
 Approved by SFD
 Signature
 Date

- TYPE: HAMPTON (VERSAILLES)-
 WALKOUT BASEMENT
 EXPANDED FAMILY ROOM/GREAT ROOM
 ADD'L 1' TO HEIGHT OF BASEMENT
 NAPLES SUNROOM
 FOUNDATION LEDGE FOR STONEMWORK, FRONT AND SIDE
 CONSERVATORY ELITE

- OPTION No. 017
 OPTION No. 023
 OPTION No. 070
 OPTION No. 529
 OPTION No. 90028004
 OPTION No. 039



PLOT PLAN
 LOT #28
MERIWETHER FARMS

LIBER 12124, FOLIO 120
 PLAT No. 21769, ET SEQ.
 FOURTH ELECTION DISTRICT
 HOWARD COUNTY, MARYLAND

ESE Land Planning
 Engineering
 Land Surveying

ESE Consultants Inc.
 7164 Columbia Gateway Dr.
 Suite 203
 Columbia, MD 21046
 TEL: 410-872-9105
 FAX: 410-872-4870

DATE: 04/04/13 SCALE: 1"=40' FILE: LOT 28 PP Hampton Vers.
 CHK'D: MJB JOB#: 3184 DRAWN: MJE

PROFESSIONAL CERTIFICATION: I HEREBY CERTIFY THAT THESE DOCUMENTS WERE PREPARED BY ME OR UNDER MY RESPONSIBLE CHARGE, AND THAT I AM A DULY LICENSED PROFESSIONAL LAND SURVEYOR UNDER THE LAWS OF THE STATE OF MARYLAND, LICENSE NO. 21245, EXPIRATION DATE 1/27/13.