

ISSUE DATE:

6/12/2012

PERMIT

P 533738

APPROVAL DATE:

6/26/12

A _____

Tax ID # 03-295842

**ON-SITE SEWAGE DISPOSAL SYSTEM
TANK REPLACEMENT
HOWARD COUNTY HEALTH DEPARTMENT
BUREAU OF ENVIRONMENTAL HEALTH**

James and Mildred Coroneos IS PERMITTED TO INSTALL ALTER

ADDRESS: 2205 Frederick Road Catonsville, MD 21228 PHONE NUMBER: 410-988-9575

SUBDIVISION: Shema Property LOT NUMBER: Tax Map 16 Par 206

ADDRESS: 11335 Frederick Road PROPERTY OWNER: James and Mildred Coroneos

SEPTIC TANK CAPACITY (GALLONS): 2000 OUTLET BAFFLE FILTER REQUIRED

PUMP CHAMBER CAPACITY (GALLONS): _____ COMPARTMENTED TANK REQUIRED

NUMBER OF BEDROOMS: 3 APPLICATION RATE: _____

SQUARE FOOTAGE OF HOUSE: 2082

*Earl
Preston
410-254-9521*

Set septic tank (replacement) 15' west of driveway with 3 feet or less of soil over tank. Tank should align with 4" PVC (existing). Sleeve SHC under driveway. Contractor to expose SHC and 4" PVC for layout inspection. Call for layout inspection. Attending Environmental Sanitarian may require evaluation of existing drain field. Pump, crush and fill old tank for final approval of this permit.

NOTES:	Do not order the septic tank until after layout inspection and Sanitarian approval. Layout inspection required prior to tank installation. Original septic tank must be properly abandoned before new tank installation. A written variance request is required for tanks deeper than 3 feet. A traffic bearing lid is required for tanks deeper than 4 feet.
--------	--

PLANS APPROVED: Robert Bricker RB 6/12/12 DATE: 6/12/2012


- NOTE: PERMIT VOID AFTER 2 YEARS
- NOTE: CONTRACTOR RESPONSIBLE FOR SCHEDULING A PRE-CONSTRUCTION INSPECTION FOR ALL INSTALLATIONS
- NOTE: WATERTIGHT SEPTIC TANKS REQUIRED
- NOTE: ALL PARTS OF SEPTIC SYSTEM SHALL BE 100 FEET FROM ANY WATER WELL
- NOTE: MANHOLE RISERS REQUIRED ON ALL SEPTIC TANKS AND PUMP CHAMBERS

NEITHER THE HOWARD COUNTY COUNCIL OR THE HEALTH DEPARTMENT IS RESPONSIBLE FOR THE SUCCESSFUL OPERATION OF ANY SYSTEM PERMITTEE RESPONSIBLE FOR OBTAINING FINAL APPROVAL ON THIS PERMIT CALL 410-313-1771 FOR INSPECTION OF SEPTIC SYSTEM

NOT TO SCALE

R+ 144

023388

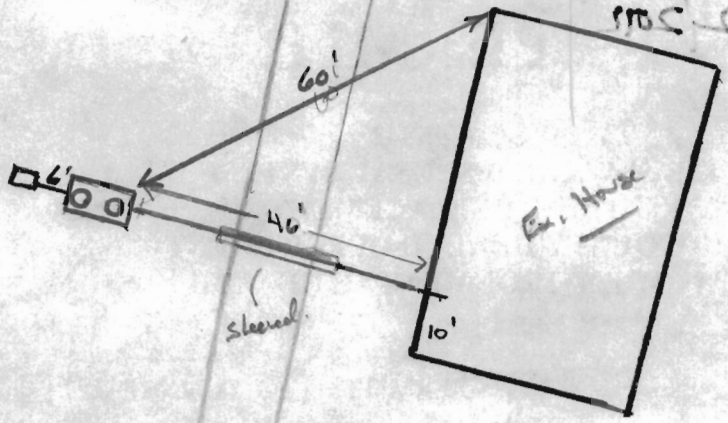

TRENCH/DRAINFIELD DATA

WIDTH _____ INLET _____ BOTTOM _____

NUMBER OF TRENCHES _____

TOTAL LENGTH _____

ABSORPTION AREA _____

DISTRIBUTION BOX LEVEL _____

DISTRIBUTION BOX BAFFLE _____

DISTRIBUTION BOX PORT _____

SEPTIC TANK DATA

SEPTIC TANK 1 LEVEL Yes

MANUFACTURER Mayer Bros

CAPACITY 2000 GAL

SEAM LOC Top

TANK LID DEPTH 2'

BAFFLES _____

BAFFLE FILTER -

MANHOLE LOC Front/Rear

6" PORT LOC none

WATERTIGHT TEST OK 6-26-12

SLOTTED Yes

DATE ON LID -

PUMP/SEPTIC TANK LEVEL N/A

MANUFACTURER _____

CAPACITY _____ GAL

SEAM LOC _____

TANK LID DEPTH _____

BAFFLES _____

BAFFLE FILTER _____

MANHOLE LOC _____

6" PORT LOC _____

WATERTIGHT TEST _____

SLOTTED _____

DATE ON LID _____

PRE-CONSTRUCTION:

6/14/12 Met w/ contractor on-site. Keep new S.T. @ least 20' from dwelling. sleeve the under drive way. Pump, valleys ex, septic tank. Homeowner wants to use 6" sch 40 from house to tank. I am ok w/ 6" sch 40 to tank. Just make sure tank has 6" core hole on inlet side. (KW)

INSTALLATION: 6/25/12 Tank hole dug. Pipe ran across to tank. Told contractor of water tight test on tank. (KW)

6/26/12 Tank in place w/ H2O set 24 hrs. 1 hour H2O test OK. No drop in level. OK to backfill all work (KW)

FINAL INSPECTOR

K. Wolf

DATE OF APPROVAL

6/26/12