

10/17/76
after 1pm

PERMIT

SEWAGE DISPOSAL SYSTEM

MARYLAND STATE DEPARTMENT OF HEALTH

HOWARD COUNTY

ELLICOTT CITY

DISTRICT 3rd

DATE 9/28/76

P-24087
A-18346

Approved
10-7-76
INDEXED

Jim Brittingham

IS PERMITTED TO INSTALL ALTER

ADDRESS 3004 N. Rogers Avenue, Ellicott City, Md. 21043 PHONE 461-1870

A SEWAGE DISPOSAL SYSTEM LOCATED AT

SUBDIVISION Gwenlee Estates ROAD Gared Drive LOT 6, Blk. C, Sec. 1

PROPERTY OWNER John Finnegan

ADDRESS

SPECIFICATIONS 4 bedrooms

DRAIN FIELD FEET, BOTTOM AREA SQ. FT.

SEEPAGE PITS ABSORBENT SIDE-WALL AREA SQ. FT.

SEPTIC TANK CAPACITY 1250 GALLONS

FOR GARBAGE GRINDER, INCREASE DISPOSAL AREA 22% & TANK CAPACITY 50%.

OTHER DRY WELL AND TRENCH - Dry well to ~~be~~ 350 sq. ft. absorbent sidewall area. Inlet at 3 ft. and bottom of dry well 10 ft. Locate dry well 20 ft. from left property line and 130 ft. from front property line as seen from Gared Drive. Trench to be 50 ft. long and run parallel to Gared Drive. CALL FOR INSPECTION OF TRENCH BEFORE PLACING STONE IN TRENCH.

NOTE: ALL PIPE FROM HOUSE TO DISPOSAL AREA MUST BE CAST IRON. PERMIT VOID AFTER THREE YEARS.

NOTE: INSTALL STAND PIPE ON SEPTIC TANK AND DRY WELL. STAND PIPES MUST BE 6 INCHES IN DIAMETER. CAST IRON, CONCRETE OR TERRA COTTA ACCEPTED.


PLANS APPROVED BY David J. O'Neill DATE 4/14/76

FILL SEPTIC TANK AND DISTRIBUTION BOX WITH WATER BEFORE CALLING FOR AN INSPECTION. COVER NO WORK UNTIL INSPECTED AND APPROVED.

NEITHER THE HOWARD COUNTY COMMISSIONERS NOR THE HEALTH DEPARTMENT IS RESPONSIBLE FOR THE SUCCESSFUL OPERATION OF ANY SYSTEM.

A-18346

INSPECTOR DATE SYSTEM APPROVED

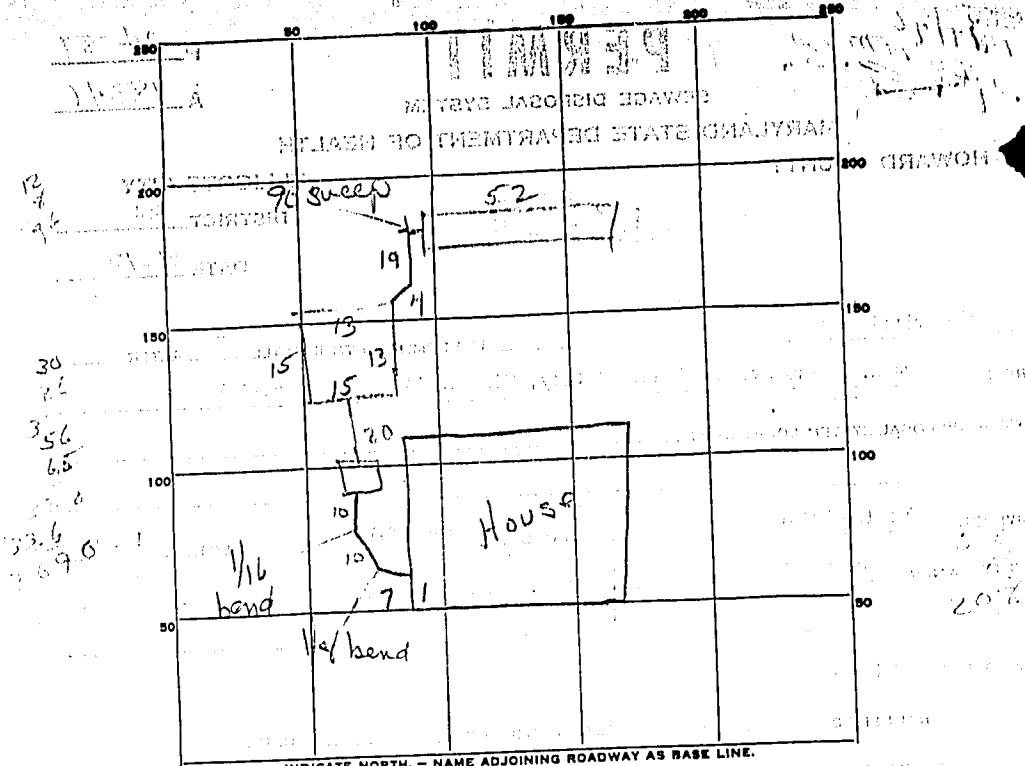

PERMIT CARD yes OW/ST

SEPTIC TANK, LEVEL 1250 g/yes CLEANOUTS —

DISTRIBUTION BOX, LEVEL _____

TILE FIELD, DEPTH 10 FT. TRENCH WIDTH 2 FT.

GRAVEL DEPTH 6 IN. TOTAL LENGTH 52 FT.

NUMBER OF TRENCHES 1 TOTAL-BOTTOM AREA 312

SEEPAGE PITS, INSIDE DIAMETER 56 FT. DEPTH BELOW INLET 6 FT. = 336 OW

Total ABSORBENT AREA 536 SQ. FT.

REMARKS _____

DATE SYSTEM APPROVED Thur Oct 7 '76 INSPECTOR hal bonson

