

DATE	TEST #	DEPTH	START	BREAK 1" DROP	STOP 2" DROP	TIME OF 2nd INCH	P/F/H
12-2-05	600	4 1/2'	9:54	10:01	10:14	13	P
	602	4' 10"	9:59	10:02	10:20	MUD	P
	603	4' 6"	10:06	10:09	10:12	3	P
	604	4 1/2'	10:11	10:16	10:23	7	P
	605	5 1/2'	10:20	10:45	NOTE: 2" deeper	no pegs	no cover
	607	5' 3"	10:17	10:21	10:26	5	P
	601	Visual	ca				
	605	6' 1"	10:51	10:53	10:57	5	P
	HOLES DUG AS STAKED			Except	601A & 606A		

REMARKS V.F. SANDS & SILT Approx. 10-15%

SANITARIAN Kacie Norman BACKHOE Level Land OTHERS Zepp & Feaga

TEST HOLES USED IN SDA \_\_\_\_\_ AVG. PERC TIME 8-10 min SQ. FT./BR 210

TRENCH WIDTH 3 INLET DEPTH 4 MAX. BOT DEPTH 7' EFFECTIVE S/W 2' ±

1 ATS 102 HOLES DOWNHILL OF #605 - 180 ft per bedroom

V/P 601

Red brn  
CL  
one hole  
20' 5' flag stone  
s.l.  
overall  
chart  
& flag  
30% stone  
paved in  
Rock  
evening  
bottom

601A  
my  
brn  
myL

3 1/2  
Compact  
L.S.L  
some pacity  
Rxn 7'  
Chart  
25-30%  
H. B. 11/10

604


org brn  
SIL

3 1/2 to  
1 1/2 ±

some  
pacity  
& compact  
structure  
wk org  
yellow-  
w/oz  
STND  
chart 2/15/9  
H. B. 10

606A

org brn  
myL  
plains  
less  
qtz  
frag  
st y brn  
lean  
Rxn 15%  
ok

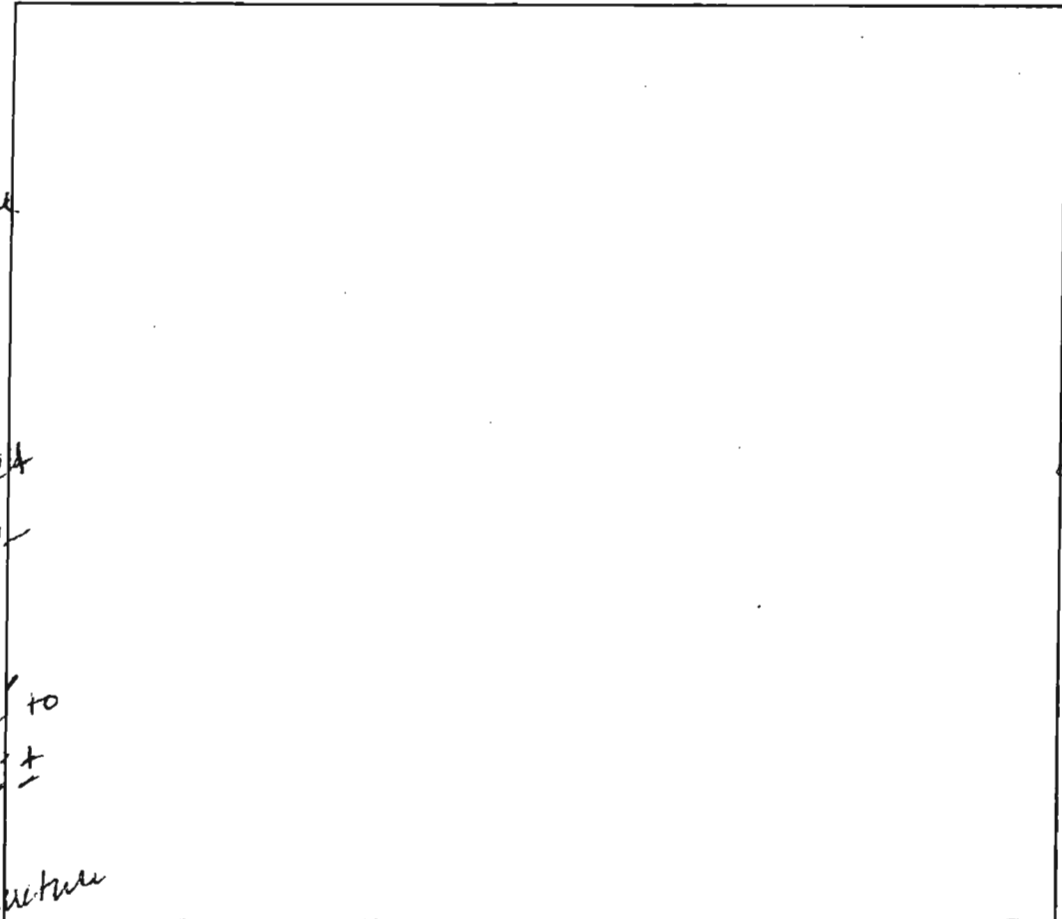

DATE	TEST #	DEPTH	START	BREAK 1" DROP	STOP 2" DROP	TIME OF 2nd INCH	P/F/H	
12/2/05	601	4' 8"	10:27	10:31	10:41	10	P	
	604	4 1/2'	10:35	10:40	10:49	9	P	
		Although Perc Rates Pass, additional						
		holes further downhole						
	606A	VISUAL					OK	
	601A	VISUAL					OK	

REMARKS \_\_\_\_\_

SANITARIAN Kacie BACKHOE Level Land OTHERS Zepp & Fago


TEST HOLES USED IN SDA \_\_\_\_\_ AVG. PERC TIME \_\_\_\_\_ SQ. FT/BR \_\_\_\_\_

TRENCH WIDTH \_\_\_\_\_ INLET DEPTH \_\_\_\_\_ MAX. BOT DEPTH \_\_\_\_\_ EFFECTIVE S/W \_\_\_\_\_

B. B. 11/10

RCEL 90  
DS MARTHA  
270 F 19  
NED RC-DEQ

Ex. Structure

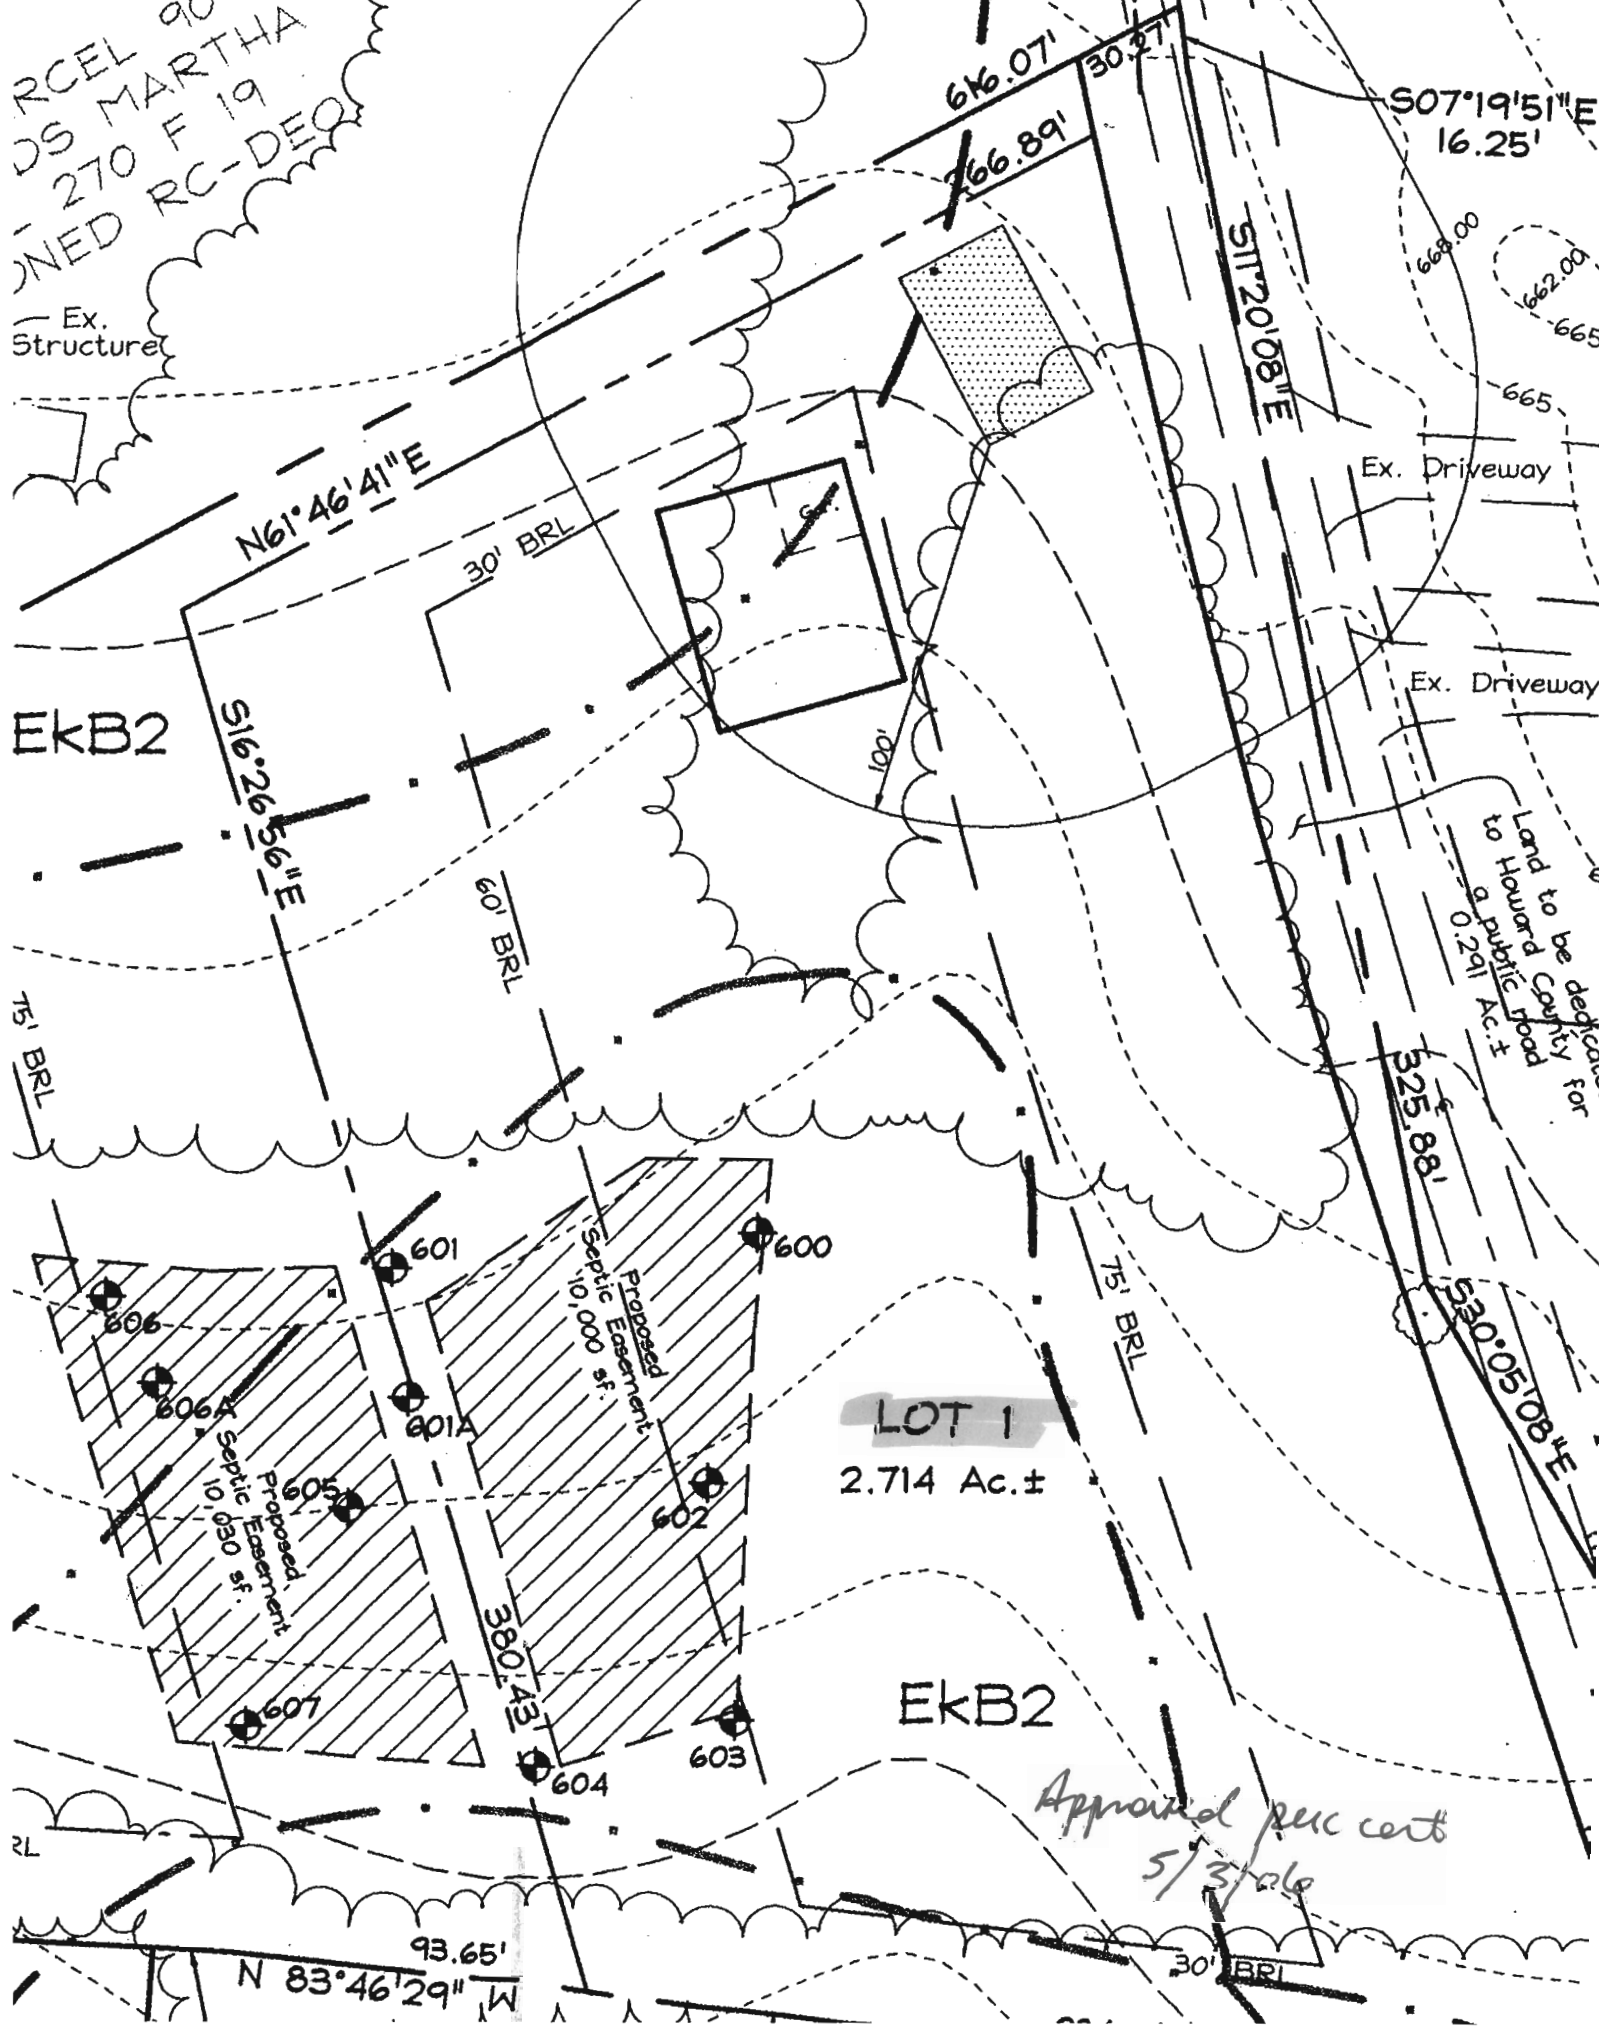

EKB2

LOT 1  
2.714 Ac.±

EKB2

Appraised per cert  
5/3/06

93.65'  
N 83°46'29" W

S07°19'51"E  
16.25'

Ex. Driveway

Ex. Driveway

Land to be dedicated  
to Howard County  
a public road  
0.2611 Ac.±

325.88'

S30°05'08"E

S11°20'08"E

616.07'

766.89'

30.27'

N61°46'41"E

30' BRL

S16°26'56"E

30' BRL

75' BRL

30' BRL

75' BRL

RL

665

665

