

# APPLICATION

A 18347

## SEWAGE DISPOSAL TESTING

STATE OF MARYLAND - DEPARTMENT OF HEALTH AND MENTAL HYGIENE  
 HOWARD COUNTY HEALTH DEPARTMENT  
 ENVIRONMENTAL HEALTH SERVICES  
 P. O. BOX 476, ELLICOTT CITY, MARYLAND 21043  
 TELEPHONE: 463-3000, EXT. 386

P \_\_\_\_\_

DISTRICT 3

DATE \_\_\_\_\_

*Septic Tank - 1250 gal  
 Dry Well - 500 sq. ft.*

*abandoned sidewalk area to begin below the first  
 4 ft. of more porous soil. Max. depth permitted for  
 dry well is 11 1/2 ft. Locate Dry well 19 ft from  
 left side line and 139 ft. from front lot line as seen  
 from Laurel Drive*

TO: THE COUNTY HEALTH OFFICER  
 ELLICOTT CITY, MARYLAND

I, HEREBY, APPLY FOR THE NECESSARY TEST IN ORDER TO CONSTRUCT (OR RECONSTRUCT) A SEWAGE DISPOSAL SYSTEM.

PROPERTY OWNER \_\_\_\_\_

ADDRESS \_\_\_\_\_ PHONE \_\_\_\_\_

PROPERTY LOCATION: \_\_\_\_\_

SUBDIVISION Greenwood Est. LOT NO. 3  
XX

ROAD AND DESCRIPTION Road B

SIZE OF LOT 45,500 sq. ft. TYPE BLDG. 3 or 4  
 IF NOT SINGLE RESIDENCE DESCRIBE \_\_\_\_\_ NUMBER OF BEDROOMS \_\_\_\_\_

THE SYSTEM INSTALLED UNDER THIS APPLICATION IS ACCEPTABLE ONLY UNTIL PUBLIC FACILITIES BECOME AVAILABLE.

SIGNATURE OF APPLICANT John Alexander

APPROVED BY Robert V. Tom FOR Dry Well DATE 2/14/74  
 (KIND OF SYSTEM)

REJECTED BY \_\_\_\_\_ FOR \_\_\_\_\_ DATE \_\_\_\_\_  
 (KIND OF SYSTEM)

HOLD PENDING FURTHER TESTS \_\_\_\_\_ DATE \_\_\_\_\_


REASONS FOR REJECTION OR HOLDING \_\_\_\_\_


# THIS IS NOT A PERMIT



lot #3  
 sect. I  
 Block "C"  
 Gwen Lee Estates  
 3rd & 4th ELEC. DIST. Ho. Co. Md.

A19347

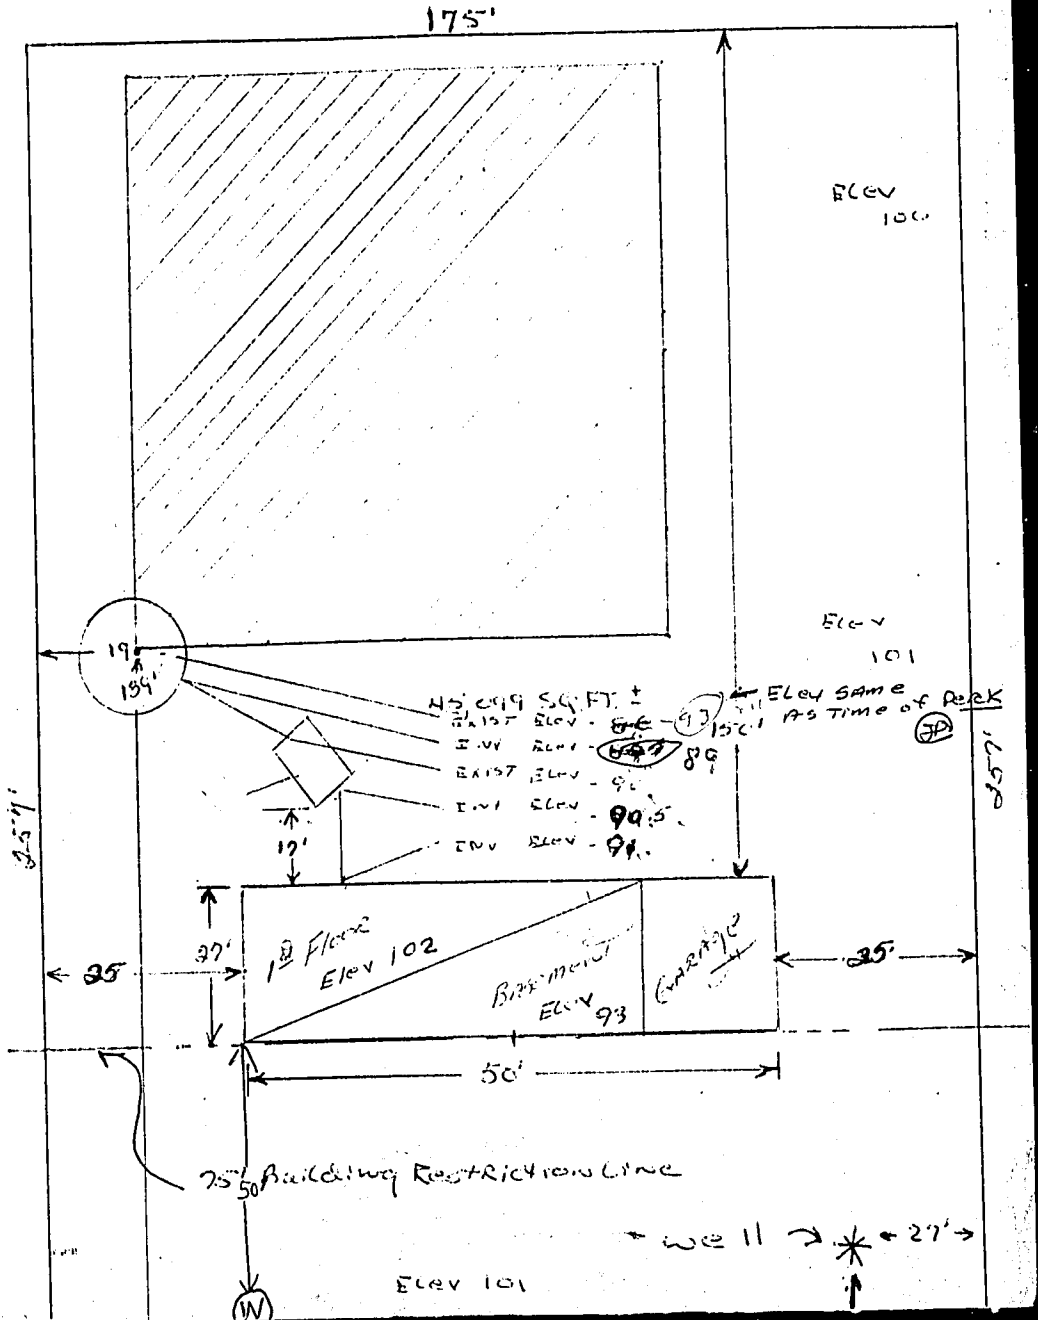

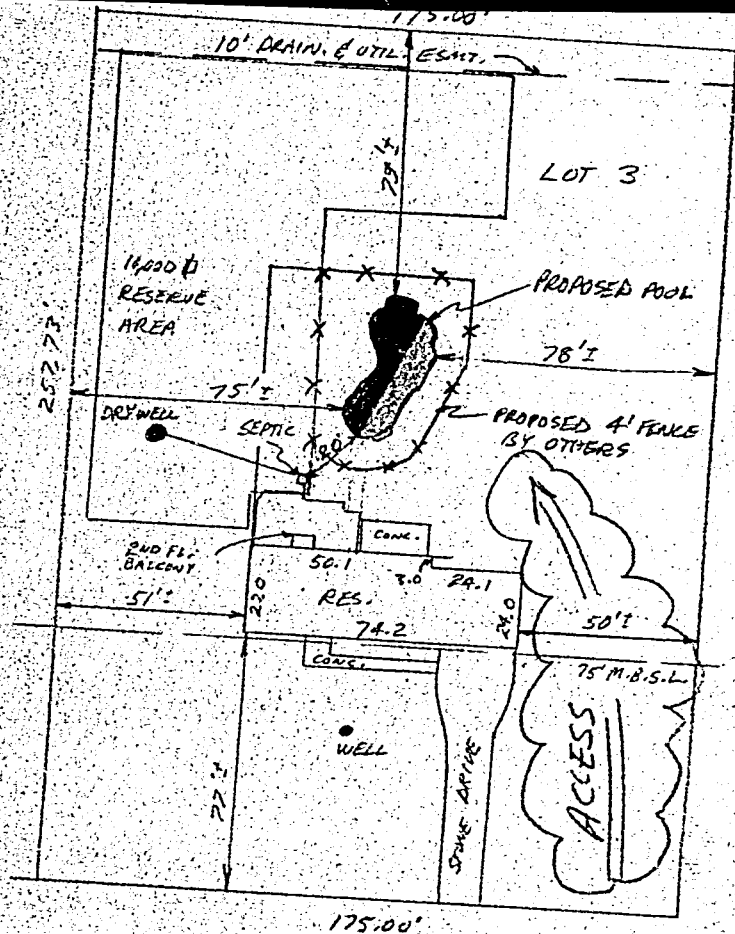

NO IMPACT ON EXISTING SEPTIC  
8/28/85 QLT

14086 GARED ROAD

A18347