

6/17/75
6/20/75
6/21/75

6/9/75
Partial
R.T.

PERMIT

SEWAGE DISPOSAL SYSTEM

MARYLAND STATE DEPARTMENT OF HEALTH

HOWARD COUNTY

INDEXED

P 21626

A 18347

ELLICOTT CITY

DISTRICT 3

DATE 6/5/75

Costello Builders, Inc. IS PERMITTED TO INSTALL ALTER

ADDRESS 2201 Route 94, Woodbine, Maryland 21797 PHONE 442-2288

A SEWAGE DISPOSAL SYSTEM LOCATED AT

SUBDIVISION Gwenlee Estates ROAD 14080 Gared Drive LOT 3, Blk. C, Sec. 1

PROPERTY OWNER ~~W. L. Doring~~ Robert Tangenti

ADDRESS

SPECIFICATIONS - 3 bedrooms

DRAIN FIELD FEET, BOTTOM AREA SQ. FT.

SEEPAGE PITS ABSORBENT SIDE-WALL AREA SQ. FT.

SEPTIC TANK CAPACITY 1,250 GALLONS

FOR GARBAGE GRINDER, INCREASE DISPOSAL AREA 22% & TANK CAPACITY 50%.

OTHER Dry well - 500 sq. ft. absorbent sidewall area to begin below the first 4 ft. of non-porous soil. Max. depth permitted for dry well is 11 1/4 ft. Locate dry well 19 ft. from left side line and 139 ft. from front lot line as seen from Gared Drive.

Use 10 ft. dry well with 7 1/4 ft. effective depth below first 4 ft. of original grade. Bring inlet in at 3 1/4 ft. below original grade. Max. depth permitted for dry well is 11 1/4 ft. below original grade. Come off dry well 5 ft. solid pipe (earth buffer) begin trench. Trench to be 11 1/4 ft. deep - 30 ft. long with 7 1/4 ft. gravel under pipe.

NOTE: CALL FOR INSPECTION OF TRENCH BEFORE GRAVEL IS INSTALLED.

PERMIT VOID AFTER THREE YEARS.

NOTE: INSTALL CLEANOUTS ON SEPTIC TANK AND DRY WELL. CLEANOUT MUST BE 6" IN DIA. CAST IRON,

PLANS APPROVED BY Robert V. Torre DATE 2/14/74
CONCRETE, OR TERRA COTTA ACCEPTED.


FILL SEPTIC TANK AND DISTRIBUTION BOX WITH WATER BEFORE CALLING FOR AN INSPECTION. COVER NO WORK UNTIL INSPECTED AND APPROVED.

INSTALL CAST IRON FROM HOUSE TO DISPOSAL AREA.

NEITHER THE HOWARD COUNTY COMMISSIONERS NOR THE HEALTH DEPARTMENT IS RESPONSIBLE FOR THE SUCCESSFUL OPERATION OF ANY SYSTEM.

BLDG. PERMIT SIGNED AND RETURNED 5/15/74
Serial # 5-8672
BLDG. PERMIT SIGNED AND RETURNED 8/28/75 Serial # 46665
Sub.

A 18347

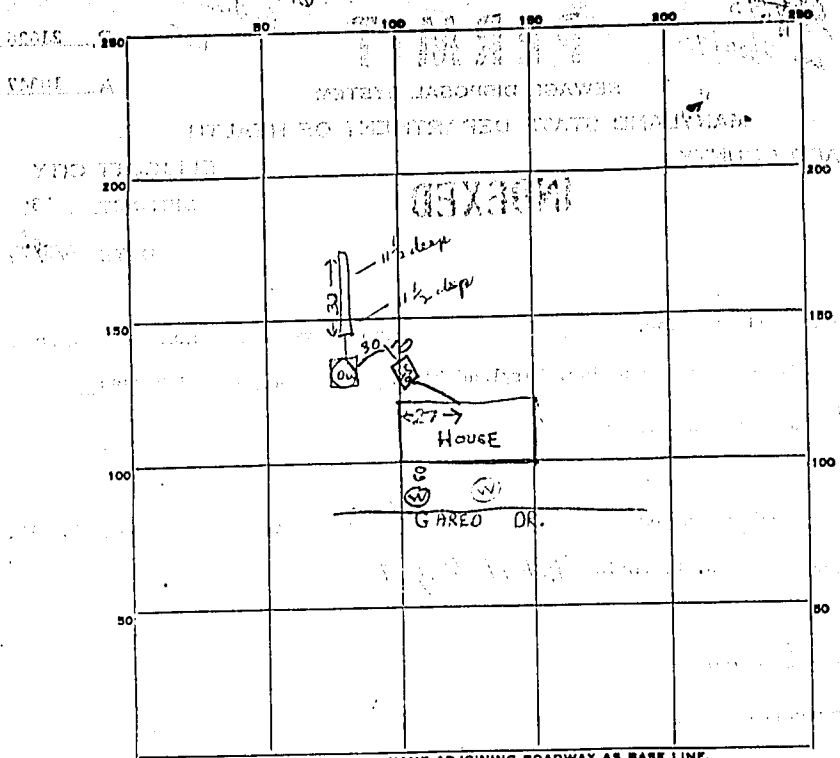

PERMIT CARD _____
 SEPTIC TANK, LEVEL 1 CLEANOUTS 1 R. 0 R.
 DISTRIBUTION BOX, LEVEL _____

DITCH TILE FIELD, DEPTH 11 1/2 FT. TRENCH WIDTH 2 FT.
 GRAVEL DEPTH 6 1/2 FT. TOTAL LENGTH 36 FT.
 NUMBER OF TRENCHES 1 TOTAL SIDEWALL-BOTTOM AREA 234
 SEEPAGE PITS, INSIDE DIAMETER 10 FT. DEPTH BELOW INLET 7 FT.
 ABSORBENT AREA 287 SQ. FT.

REMARKS TOTAL ABSORBENT AREA 529 SQ FT

6/9/75 12 runs of ditch (8ft) R.T.
6/13/75 Septic tank in ground, bed not connected to driveway
6/20/75 DRYWELL INLET 6 FT BELOW GRAVE
INLET TO DITCH 6 FT BELOW GRAVE
PERIMETER OF D.W. IS 41 FT 4 IN = 287 SQ FT
PUT PIPE IN DITCH & COVER
 DATE SYSTEM APPROVED 6/20/75 INSPECTOR Raymond Hooper