

C 1 **6576** SEQUENCE NO. (WRA USE ONLY)
 1 2 3 (SEQ. NO.) 6
 (THIS NUMBER IS TO BE PUNCHED IN CO. S. 3-C ON ALL CARDS)

STATE OF MARYLAND
WATER RESOURCES ADMINISTRATION
 TAWES STATE OFFICE BLDG., ANNAPOLIS, MD. 21401
WELL COMPLETION REPORT

THIS REPORT MUST BE SUBMITTED WITHIN 30 DAYS AFTER WELL COMPLETION
FILL IN THIS FORM COMPLETELY
 COUNTY NUMBER

DATE RECEIVED (WRA USE ONLY) 3/10/77 DATE WELL COMPLETED 300 DEPTH OF WELL 300 (TO NEAREST FOOT) 22 26
 PERMIT NO. FROM "PERMIT TO DRILL WELL" A0-73-1871
 28 29 30 31 32 33 34 35 36 37
 DRILLERS IDENTIFICATION NO. 48

OWNER F. Karditsch Joseph LAST NAME FIRST NAME
 STREET OR RFD 547 Brock Bridge Rd. POST OFFICE Laurel Md.

WELL LOG
 STATE THE KIND OF FORMATIONS PENETRATED, THEIR COLOR, DEPTH, THICKNESS AND IF WATER BEARING

DESCRIPTION (USE ADDITIONAL SHEETS IF NECESSARY)	FEET		CHECK IF WATER BEARING
	FROM	TO	
Top soil	0	2	
Shaly	2	15	
SANDstone	15	30	
M.C.A	30	220	✓
FLY ROCK	220	225	✓
M.C.A	225	300	

GROUTING RECORD
 WELL HAS BEEN GROUTED (CIRCLE APPROPRIATE BOX) YES NO
 TYPE OF GROUTING MATERIAL (CIRCLE BOX):
 CEMENT BENTONITE CLAY
 NO. OF BAGS 8 NO. OF POUNDS 800
 GALLONS OF WATER 40
 DEPTH OF GROUT SEAL (TO NEAREST FOOT)
 FROM 0 FT. TO 22 FT.
 (ENTER 0 IF FROM SURFACE)

PUMPING TEST
 C 3
 1 2 3 (SEQ. NO.) 6
 HOURS PUMPED (TO NEAREST HOUR) 4
 PUMPING RATE (GALLONS PER MINUTE TO NEAREST GALLON) 11
 METHOD USED TO MEASURE PUMPING RATE Bucket
 WATER LEVEL: (DISTANCE FROM LAND SURFACE)
 BEFORE PUMPING 60 (NEAREST FOOT)
 WHEN PUMPING 300 (NEAREST FOOT)
 TYPE OF PUMP USED (CIRCLE APPROPRIATE BOX) (FOR PUMPING TEST)
 AIR PISTON TURBINE
 CENTRIFUGAL ROTARY OTHER (DESCRIBE BELOW)
 JET SUBMERSIBLE

CASING RECORD
 INSERT APPROPRIATE CODE BELOW
 STEEL CONCRETE
 PLASTIC OTHER
 MAIN CASING TYPE 57 NOMINAL DIAMETER TOP (MAIN) CASING (NEAREST INCH) 6 TOTAL DEPTH OF MAIN CASING (NEAREST FOOT) 29

PUMP INSTALLED
 TYPE OF PUMP (WRITE APPROPRIATE LETTER IN BOX - SEE ABOVE: A, C, J, P, R, S, T, O) 29
 DRILLER WILL INSTALL PUMP (CIRCLE APPROPRIATE BOX) YES NO
 CAPACITY:
 GALLONS PER MINUTE (TO NEAREST GALLON) 31 35
 PUMP HORSE POWER 37 41
 PUMP COLUMN LENGTH (NEAREST FOOT) 43 47

OTHER CASING (IF USED)
 DIAMETER (INCH) DEPTH (FEET) FROM TO
 EACH CASING

SCREEN RECORD
 SCREEN TYPE OR OPEN HOLE
 INSERT APPROPRIATE CODE BELOW
 STEEL BRASS OR BRONZE OPEN HOLE
 PLASTIC OTHER

CASING HEIGHT (CIRCLE APPROPRIATE BOX AND ENTER CASING HEIGHT)
 ABOVE } LAND SURFACE (NEAREST FOOT)
 BELOW } 2

CIRCLE APPROPRIATE BOXES
 A WELL WAS ABANDONED AND SEALED WHEN THIS WELL WAS COMPLETED
 E ELECTRIC LOG OBTAINED
 P TEST WELL CONVERTED TO PRODUCTION WELL

C 2
 1 2 3 (SEQ. NO.) 6
 DEPTH (NEAREST WHOLE FOOT) FROM TO
 EACH SCREEN
 1 10 22 300
 2 23 24 26 30 32 36
 3 38 39 41 45 47 51
 SLOTSIZE 1, 2, 3, _____

LOCATION OF WELL ON LOT
 SHOW PERMANENT STRUCTURE SUCH AS BUILDINGS, SEPTIC TANKS, AND/OR OTHER LAND MARKS AND INDICATE NOT LESS THAN TWO DISTANCES (MEASUREMENTS TO WELL).
 HOUSE


I HEREBY CERTIFY THAT I HAVE COMPLIED WITH ALL CONDITIONS STATED ON THE ABOVE-CAPTIONED "PERMIT TO DRILL WELL", AND THAT INFORMATION CONTAINED IN THIS REPORT IS TRUE, ACCURATE, AND COMPLETE TO THE BEST OF MY KNOWLEDGE, INFORMATION AND BELIEF.
 DRILLERS NAME
 (PLEASE PRINT) R.F. Eastwood
 SIGNATURE R.F. Eastwood

DIAMETER OF SCREEN 56 60 (NEAREST INCH) FROM TO
 GRAVEL PACK _____
 IF WELL DRILLED WAS A FLOWING WELL CIRCLE BOX 68 F
 WRA USE ONLY (NOT TO BE FILLED IN BY DRILLER) (E.R.O.S.)
 T W Q
 70 72 74 75 76
 TELESCOPE CASING LOG INDICATOR OTHER DATA AVAILABLE

POOL ELEVATION: TOP OF POOL 2" ABOVE GROUND AT B.M.

ROUTE 32 (GUILFORD ROAD)

MARYLAND POOLS INC.

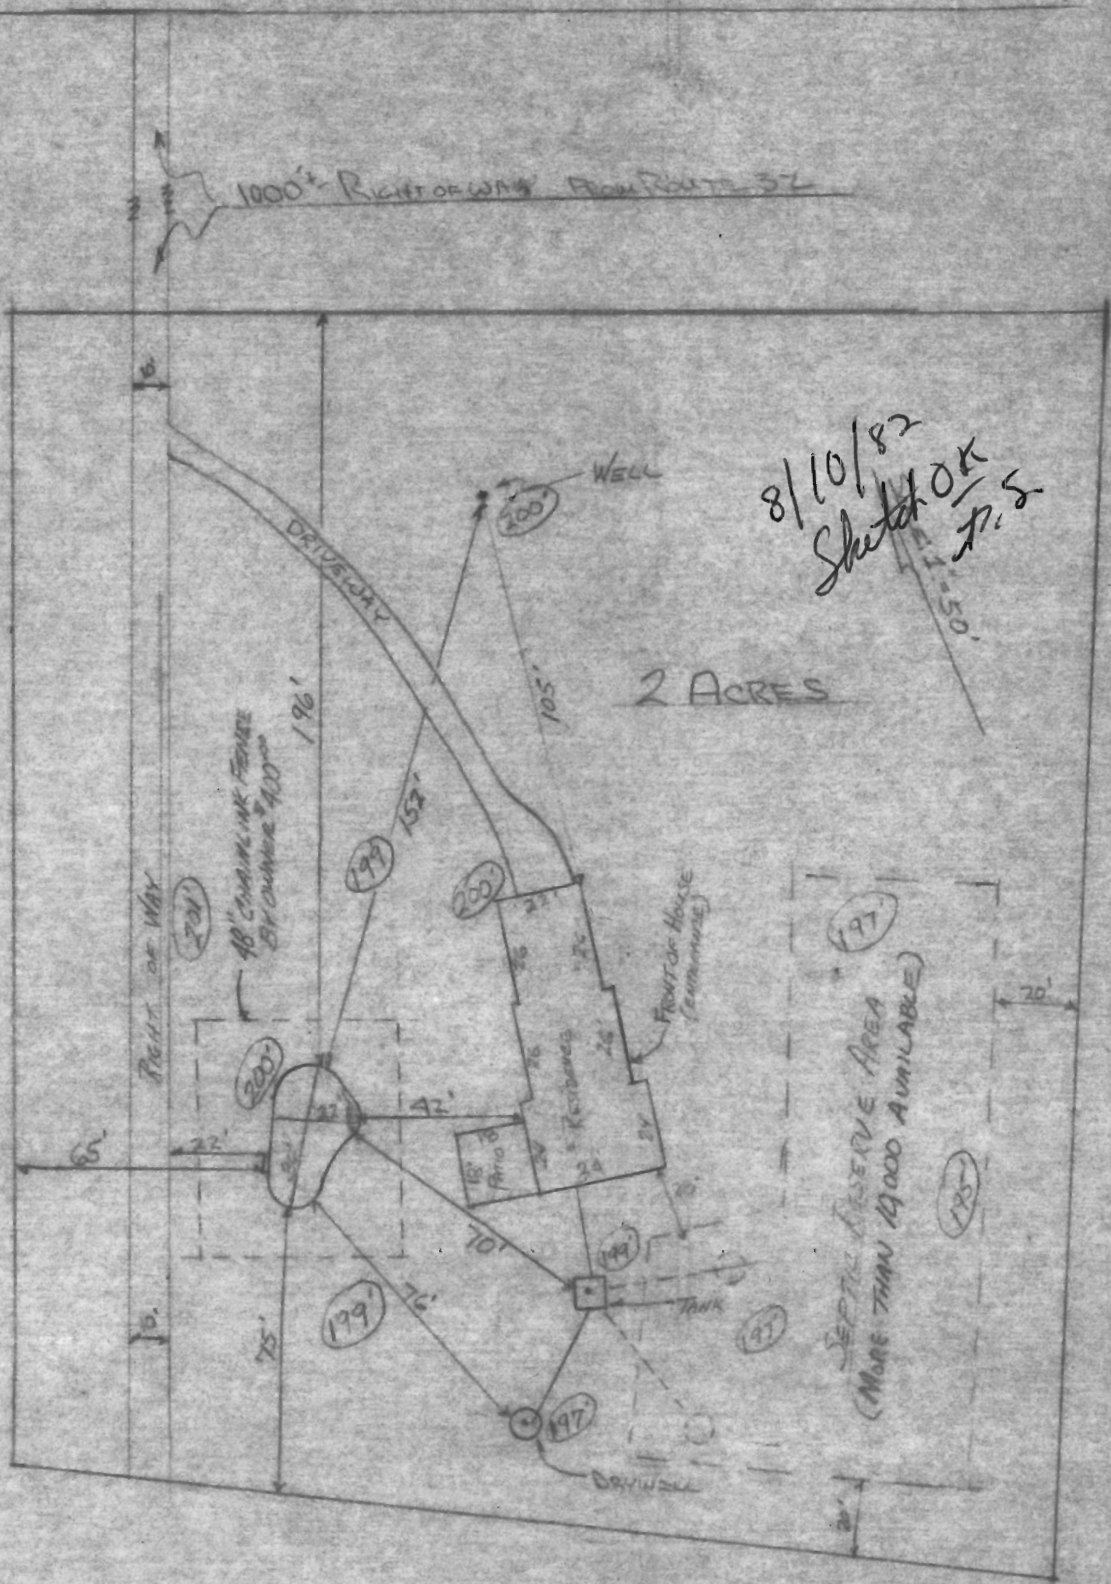

JOSEPH L. AND KAREN A. Lorditch

NORTH ↑

285.74'

142

45'

EXISTING WELL LOCATION

3/21/77
Locations and
elevations of proposed
well.

30' EXISTING RIGHT OF WAY


300.00'

EXIST. ELEV. 203.90

H.I. 20507

*200.40

323.47'

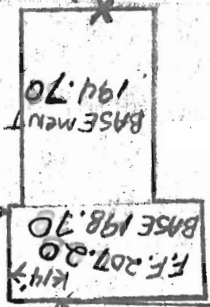

INV. ELEVATION 197.35
GRADE TO 200.35

INV. ELEVATION 196.85
EXISTING ELEVATION 194.50
GRADE TO 200.00

INV. ELEVATION 195.90

EXISTING ELEVATION 198.90

ELEVATION AT TIME OF PERCOLATION TEST

273.86'

110'

125'

71'

45'

