

APPLICATION

FOR PERCOLATION TESTING AND SITE EVALUATION

TEST DATE(S) _____

TEST TIME _____

AP 522987

AGENCY REVIEW: _____

DATE 7/22/05

DO NOT WRITE ABOVE THIS LINE

I HEREBY APPLY FOR THE NECESSARY TESTING/EVALUATION PRIOR TO ISSUANCE OF SEWAGE DISPOSAL SYSTEM PERMIT(S) TO:

CHECK AS NEEDED:

- CONSTRUCT NEW SEPTIC SYSTEM(S)
- REPAIR/ADD TO AN EXISTING SEPTIC SYSTEM
- REPLACE AN EXISTING SEPTIC SYSTEM

CHECK AS NEEDED:

- NEW STRUCTURE(S)
- ADDITION TO AN EXISTING STRUCTURE
- REPLACE AN EXISTING STRUCTURE

CHECK ONE:

- CREATE NEW LOT(S)
- BUILD ON AN EXISTING LOT IN A SUBDIVISION
- BUILD ON AN EXISTING PARCEL OF RECORD

IS THE PROPERTY WITHIN 2500' OF ANY RESERVOIR?

- YES
- NO

THE TYPE OF STRUCTURE IS:

- RESIDENTIAL WITH PROPOSED BEDROOMS IN THE COMPLETED STRUCTURE (NOTE UNKNOWN IF APPROPRIATE)
- COMMERCIAL (PROVIDE DETAIL OF NUMBERS AND TYPES OF EMPLOYEES/CUSTOMERS ON ACCOMPANYING PLAN)
- INSTITUTIONAL/GOVERNMENT (PROVIDE DETAIL OF NUMBERS AND TYPES OF EMPLOYEES/USERS ON ACCOMPANYING PLAN)

PROPERTY OWNER(S) Frances Devlin

DAYTIME PHONE 410-997-4600 Goodier Bldrs. CELL _____ FAX _____

MAILING ADDRESS Echo Farm Route 3, 43 East Litchfield Rd., Litchfield CT 06750

STREET CITY/TOWN STATE ZIP

APPLICANT Heritage Land Development

DAYTIME PHONE 410-489-7900 CELL 410-982-2882 FAX 410-489-9768

MAILING ADDRESS 3060 Washington Road, Suite 220 Glenwood MD 21738

STREET CITY/TOWN STATE ZIP

APPLICANT'S ROLE DEVELOPER BUILDER BUYER RELATIVE/FRIEND REALTOR CONSULTANT

PROPERTY LOCATION

SUBDIVISION NAME Meriweather Farm - Section 3 LOT NO. 80

PROPERTY ADDRESS 14944 Roxbury Road Glenelg

STREET TOWN/POST OFFICE


TAX MAP PAGE(S) 21 GRID 16 PARCEL(S) 28 PROPOSED LOT SIZE 1 Acre

AS APPLICANT, I UNDERSTAND THE FOLLOWING: THE SYSTEM INSTALLED SUBSEQUENT TO THIS APPLICATION IS ACCEPTABLE ONLY UNTIL PUBLIC SEWAGE IS AVAILABLE. THIS APPLICATION IS COMPLETE WHEN ALL APPLICABLE FEES AND A SUITABLE SITE PLAN HAVE BEEN RECEIVED. I ACCEPT THE RESPONSIBILITY FOR COMPLIANCE WITH ALL M.O.S.H.A. AND "MISS UTILITY" REQUIREMENTS. APPROVAL IS BASED UPON SATISFACTORY REVIEW OF A PERC CERTIFICATION PLAN. TEST RESULTS WILL BE MAILED TO APPLICANT.

Jeremy Rutter
SIGNATURE OF APPLICANT

HOWARD COUNTY HEALTH DEPARTMENT, BUREAU OF ENVIRONMENTAL HEALTH, WELL AND SEPTIC PROGRAM
3525-H ELLICOTT MILLS DRIVE, ELLICOTT CITY, MARYLAND 21043-4544 (410) 313-1771 FAX (410) 313-2648
TDD (410) 313-2323 TOLL FREE 1-877-4MD-DHMH

A/P 5054

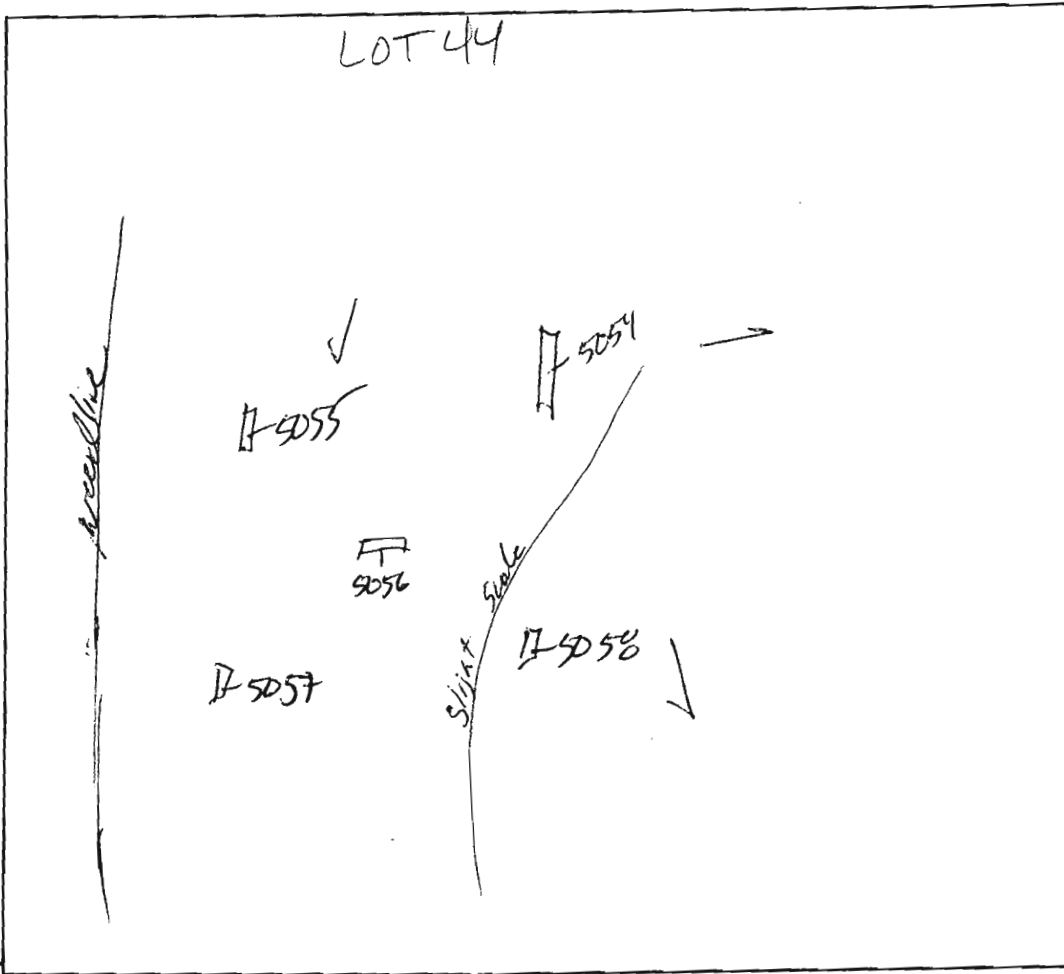

Brown L
 Orange/Brown
 Sol
 Yellow/Brown
 Sol
 Yellow/Brown
 Sol w/
 25%
 cherty
 mass
 HB
 9 1/2'

5058
 Brown L
 Orange/Low
 Brown
 Sol
 2 1/2'

Yellow/Brown
 Sol
 w/ 75%
 Rich
 4 1/2'


5056
 Brown L
 Red/gray
 heavy
 Sol
 Brown/Red
 Sol
 w/ 10%
 platy
 6'
 Gray/Brown
 Sol
 11'

5055
 Brown L
 Red/gray
 Sol
 Gray/iron
 Sol w/
 trace
 Rich
 Yellow/Brown
 Sol
 w/ 10%
 Rich

5057
 Brown L
 Orange/Brown
 Red
 Sol
 Gray/Brown
 Sol w/
 trace
 Rich
 5' of 5%
 Rich

DATE	TEST #	DEPTH	START	BREAK 1" DROP	STOP 2" DROP	TIME OF 2nd INCH	P/F/H
9/14/05	5054	4' / 9 1/2'	2:22	2:24	2:28	2min	P
	5056	4 1/2'	- Visual -			Rich	F
	5056	4' / 11'	2:31	2:34	2:40	6min	P
	5055	3 1/2' / 10'	2:37	2:38	2:40	2min	P
	5057	3' / 10'	2:51	2:53	2:55	2min	P

REMARKS Lot 50 # 5057 Shored LOT 44
 SANITARIAN _____ BACKHOE _____ OTHERS _____
 TEST HOLES USED IN SDA _____ AVG. PERC TIME _____ SQ. FT/BR _____
 TRENCH WIDTH _____ INLET DEPTH _____ MAX. BOT DEPTH _____ EFFECTIVE S/W _____

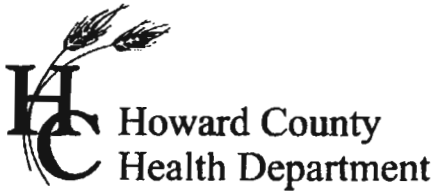

APPLICATION

FOR PERCOLATION TESTING AND SITE EVALUATION

TEST DATE(S) _____

TEST TIME _____

APP-522987

AGENCY REVIEW: _____

DATE 7/22/05

DO NOT WRITE ABOVE THIS LINE

I HEREBY APPLY FOR THE NECESSARY TESTING/EVALUATION PRIOR TO ISSUANCE OF SEWAGE DISPOSAL SYSTEM PERMIT(S) TO:

CHECK AS NEEDED:

- CONSTRUCT NEW SEPTIC SYSTEM(S)
- REPAIR/ADD TO AN EXISTING SEPTIC SYSTEM
- REPLACE AN EXISTING SEPTIC SYSTEM

CHECK AS NEEDED:

- NEW STRUCTURE(S)
- ADDITION TO AN EXISTING STRUCTURE
- REPLACE AN EXISTING STRUCTURE

CHECK ONE:

- CREATE NEW LOT(S)
- BUILD ON AN EXISTING LOT IN A SUBDIVISION
- BUILD ON AN EXISTING PARCEL OF RECORD

IS THE PROPERTY WITHIN 2500' OF ANY RESERVOIR?

- YES
- NO

THE TYPE OF STRUCTURE IS:

- RESIDENTIAL WITH PROPOSED BEDROOMS IN THE COMPLETED STRUCTURE (NOTE UNKNOWN IF APPROPRIATE)
- COMMERCIAL (PROVIDE DETAIL OF NUMBERS AND TYPES OF EMPLOYEES/CUSTOMERS ON ACCOMPANYING PLAN)
- INSTITUTIONAL/GOVERNMENT (PROVIDE DETAIL OF NUMBERS AND TYPES OF EMPLOYEES/USERS ON ACCOMPANYING PLAN)

PROPERTY OWNER(S)	Frances Devlin			
DAYTIME PHONE	410-997-4600	Goodier Bldrs.	CELL	FAX
MAILING ADDRESS	Echo Farm Route 3, 43 East Litchfield Rd.,	Litchfield	CT	06750
	STREET	CITY/TOWN	STATE	ZIP
APPLICANT	Heritage Land Development			
DAYTIME PHONE	410-489-7900	CELL	410-982-2882	FAX 410-489-9768
MAILING ADDRESS	3060 Washington Road, Suite 220	Glenwood	MD	21738
	STREET	CITY/TOWN	STATE	ZIP
APPLICANT'S ROLE	<input checked="" type="checkbox"/> DEVELOPER	<input type="checkbox"/> BUILDER	<input type="checkbox"/> BUYER	<input type="checkbox"/> RELATIVE/FRIEND
	<input type="checkbox"/> REALTOR	<input type="checkbox"/> CONSULTANT		
PROPERTY LOCATION	Meriweather Farm - Section 3			LOT NO. 39
SUBDIVISION NAME				
PROPERTY ADDRESS	14944 Roxbury Road	Gleneig		
	STREET	TOWN/POST OFFICE		
TAX MAP PAGE(S)	21	GRID 16	PARCEL(S) 28	PROPOSED LOT SIZE 1 Acre

AS APPLICANT, I UNDERSTAND THE FOLLOWING: THE SYSTEM INSTALLED SUBSEQUENT TO THIS APPLICATION IS ACCEPTABLE ONLY UNTIL PUBLIC SEWAGE IS AVAILABLE. THIS APPLICATION IS COMPLETE WHEN ALL APPLICABLE FEES AND A SUITABLE SITE PLAN HAVE BEEN RECEIVED. I ACCEPT THE RESPONSIBILITY FOR COMPLIANCE WITH ALL M.O.S.H.A. AND "MISS UTILITY" REQUIREMENTS. APPROVAL IS BASED UPON SATISFACTORY REVIEW OF A PERC CERTIFICATION PLAN. TEST RESULTS WILL BE MAILED TO APPLICANT.


Jeremy Rutter
SIGNATURE OF APPLICANT

HOWARD COUNTY HEALTH DEPARTMENT, BUREAU OF ENVIRONMENTAL HEALTH, WELL AND SEPTIC PROGRAM
3525-H ELLICOTT MILLS DRIVE, ELLICOTT CITY, MARYLAND 21043-4544 (410) 313-1771 FAX (410) 313-2648
TDD (410) 313-2323 TOLL FREE 1-877-4MD-DHMH

A/P 5050
 Browns L
 Orange/Brown Sol
 Yellow/Brown SL
 Yellow/Brown SL w/ trace Rock
 13 1/2'

5049
 Browns L
 Red/Orange heavy Sol
 Yellow/Brown SL w/ trace Rock
 13'

5051
 Browns L
 Yellow/Brown Red Sol
 Yellow/Brown SL w/ trace Rock
 12'

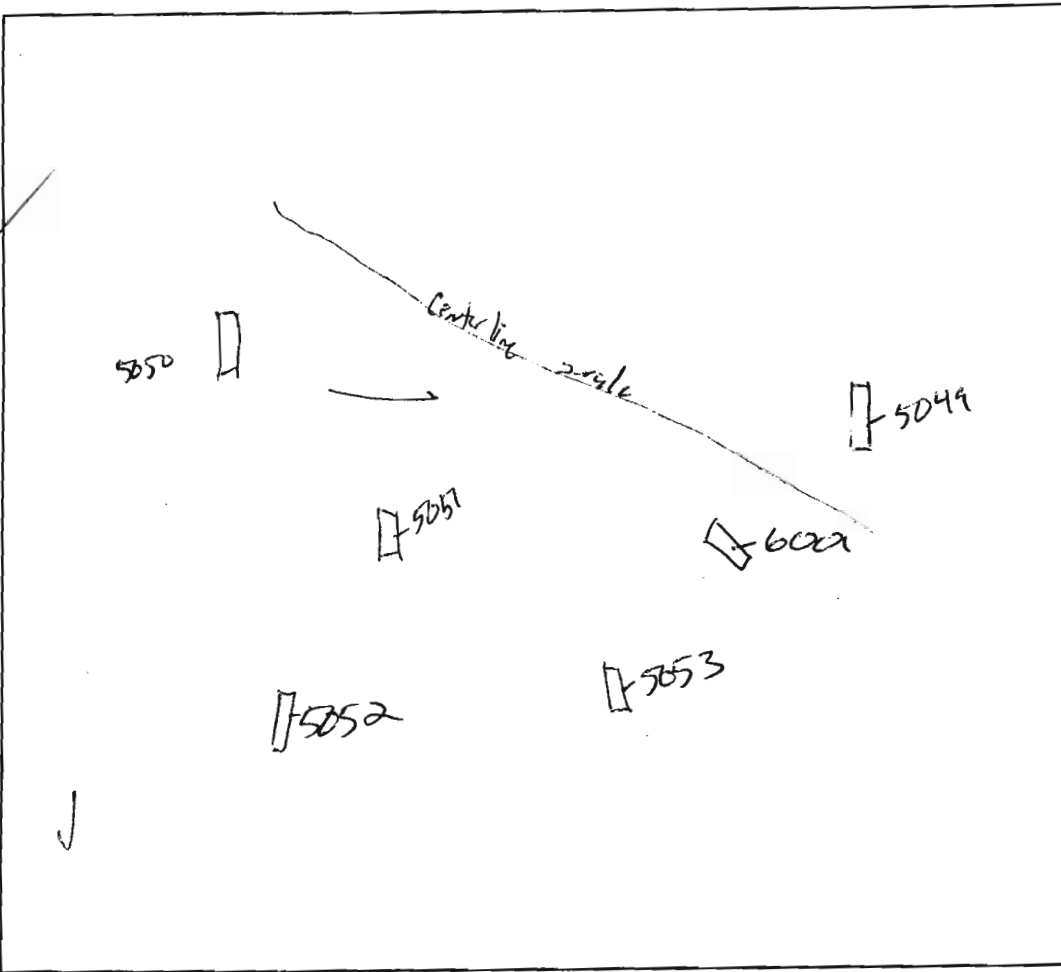

6001
 Browns L
 Red/Orange Browns Sol
 Yellow/Orange SL
 Yellow/Brown SL w/ trace Rock
 16'

5053
 Browns L
 Red/Orange Brown Sol
 Red/Orange Blod Sol
 Yellow/Brown SL w/ trace Rock
 12'

5052
 Browns/Blod L
 Red/Orange Sol
 Yellow/Orange S/SL w/ trace Rock
 12'


DATE	TEST #	DEPTH	START	BREAK 1" DROP	STOP 2" DROP	TIME OF 2nd INCH	P/F/H
9/14/05	5050	9' / 13 1/2'	10:34	10:37	10:40	3min	P
	5049	13'	- Visual -			ok	P
	5051	4' / 12'	1:49	1:52	1:58	6min	P
	6001	4' / 10'	2:01	2:03	2:06	3min	P
	5053	4 1/2' / 12'	2:09	2:12	2:19	7min	P
	5052	4 1/2' / 11'	2:16	2:17	2:19	2min	P

REMARKS: lot 49 - Hole 5049 no gravel on other side of side.

SANITARIAN _____ BACKHOE _____ OTHERS _____

TEST HOLES USED IN SDA _____ AVG. PERC TIME _____ SQ. FT/BR _____

TRENCH WIDTH _____ INLET DEPTH _____ MAX. BOT DEPTH _____ EFFECTIVE S/W _____

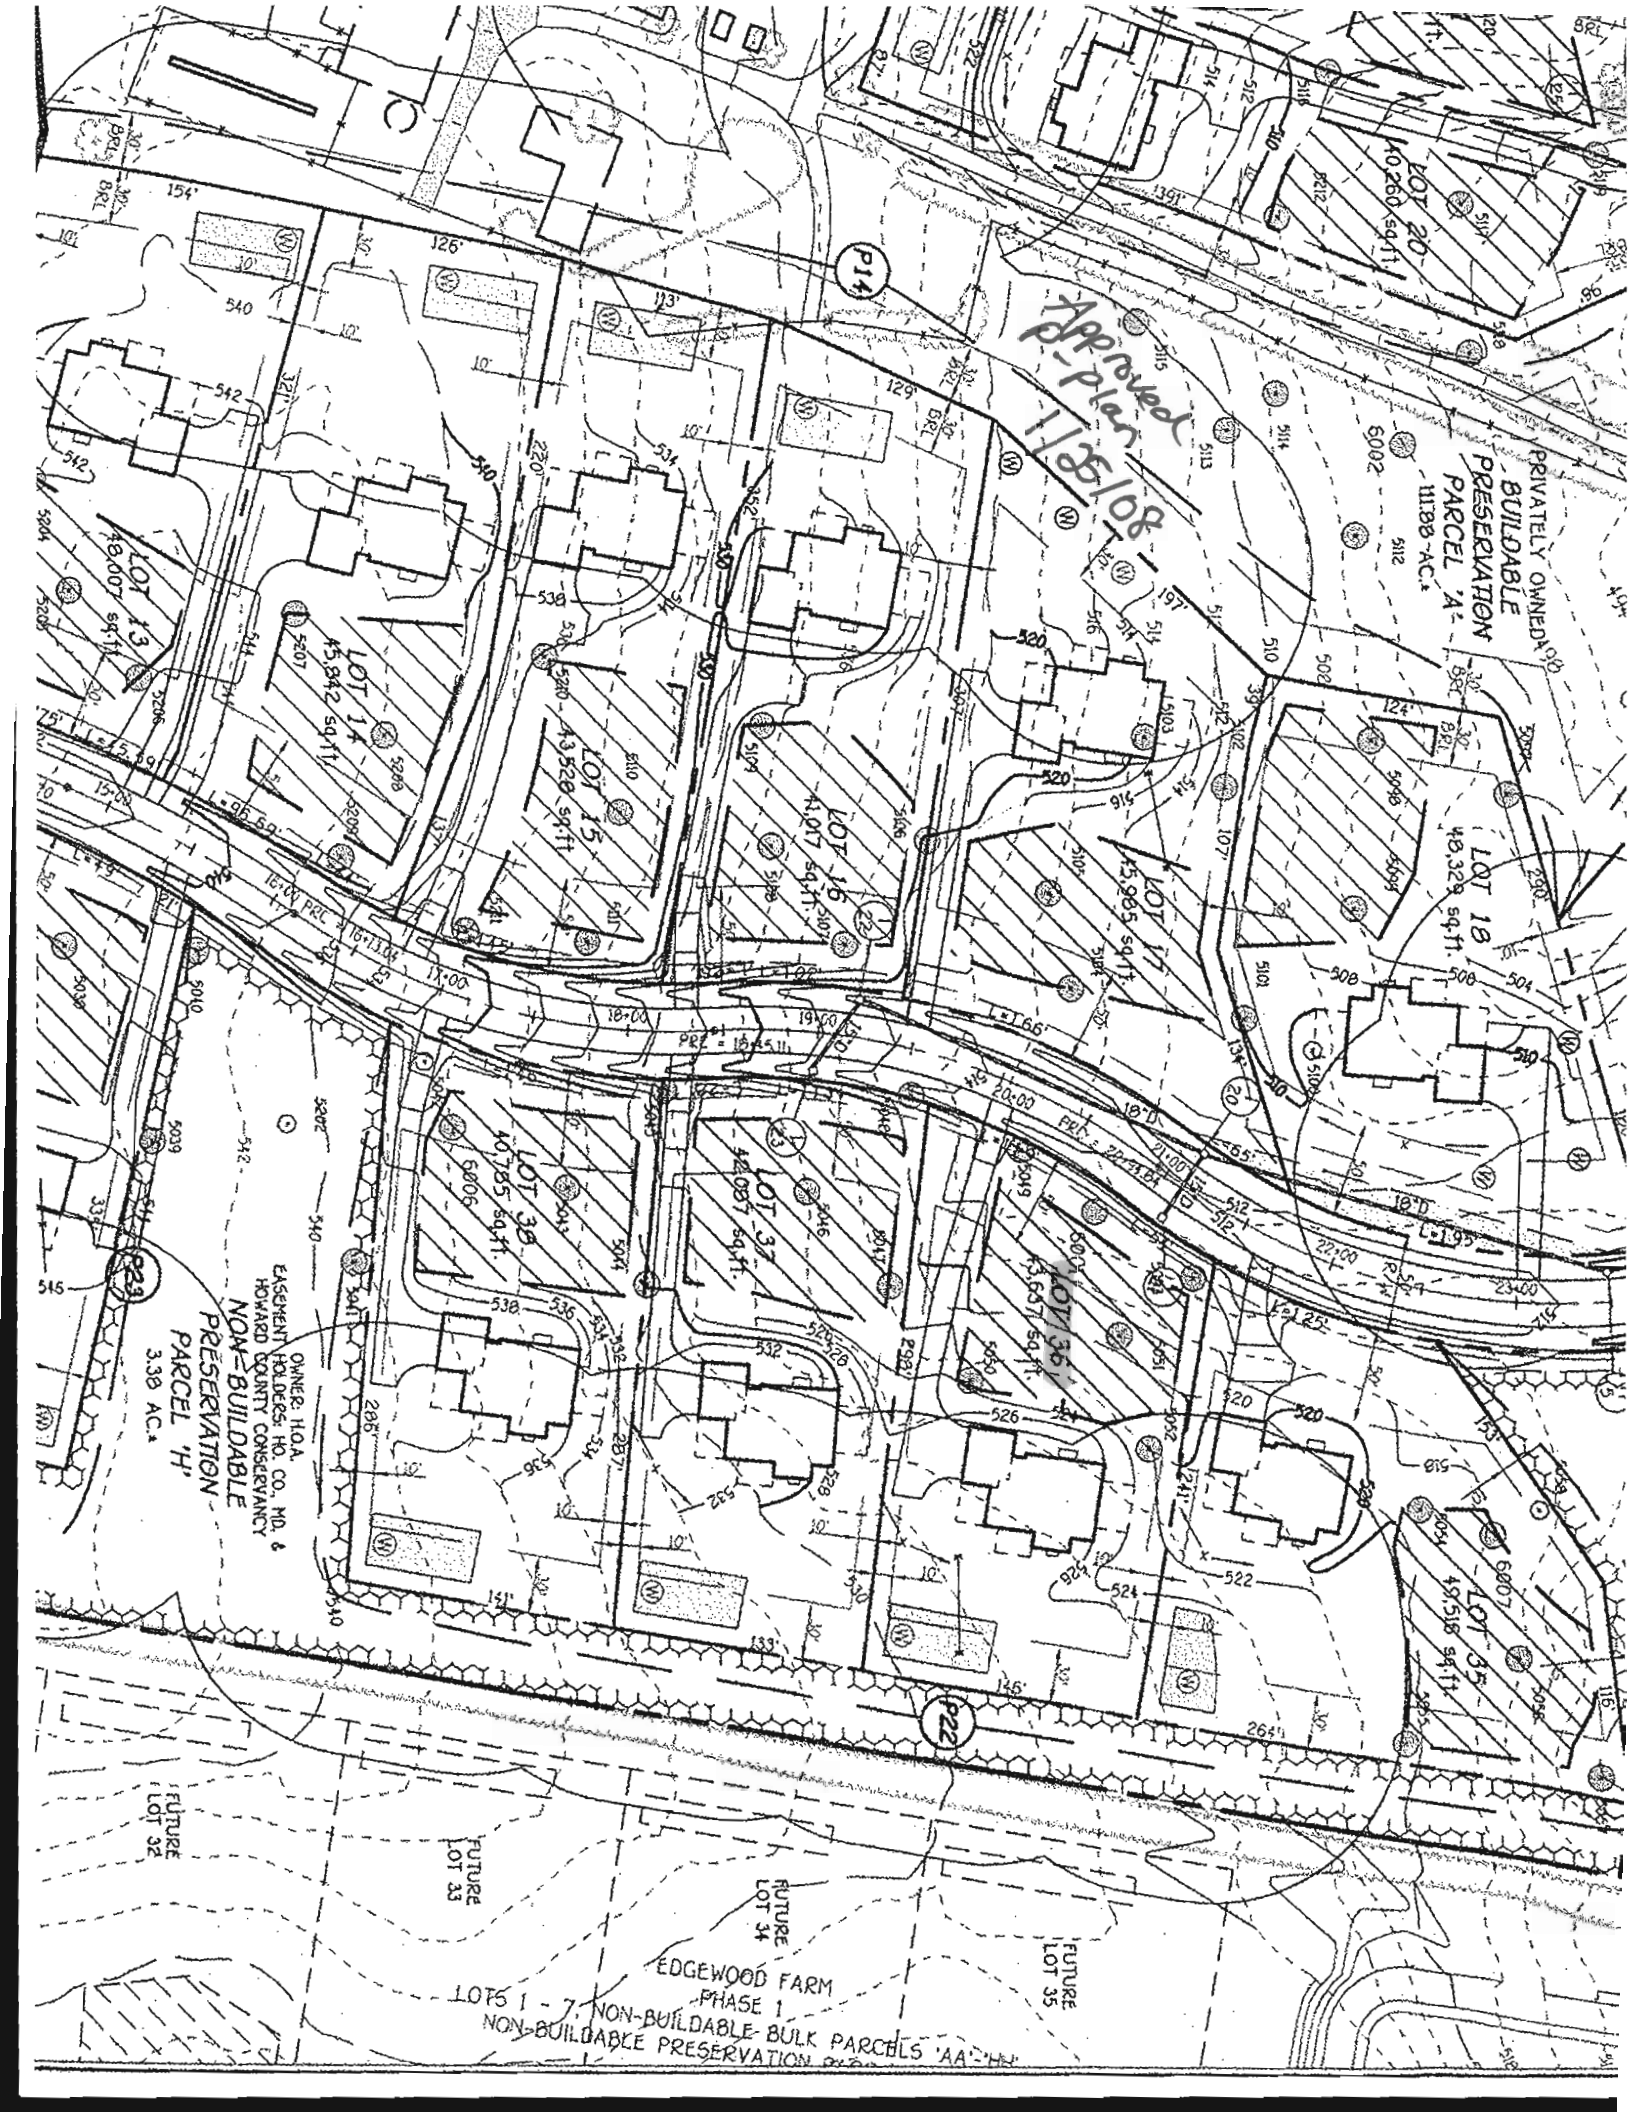

Approved
11/25/08

PRIVATELY OWNED
BUILDABLE
PRESERVATION
PARCEL A -
11.88 AC.

LOT 18
48,328 sq. ft.

LOT 17
45,965 sq. ft.

LOT 16
41,017 sq. ft.

LOT 15
43,528 sq. ft.

LOT 14
45,842 sq. ft.

LOT 13
48,007 sq. ft.

LOT 35
45,518 sq. ft.

LOT 36
43,557 sq. ft.

LOT 37
44,087 sq. ft.

LOT 38
40,785 sq. ft.

NON-BUILDABLE
PRESERVATION
PARCEL H -
3.38 AC.

OWNER: HOA
EASEMENT HOLDERS HO, CO., MD. &
HOWARD COUNTY CONSERVANCY

EDGWOOD FARM
PHASE 1

LOTS 1 - 7, NON-BUILDABLE BULK PARCELS 'AA'
NON-BUILDABLE PRESERVATION

FUTURE
LOT 32

FUTURE
LOT 33

FUTURE
LOT 34

FUTURE
LOT 35