

Fee Paid \$

Receipt #P

SEPTIC SYSTEM REPAIR / UPGRADE / EVALUATION REQUEST

Please fill out this form completely and check off the reason for the request:

Date requested: 4-24-09

Reason for Request

Failing System (includes surface discharge or inadequate treatment zone) _____

Has the contractor verified through excavation/pumping evaluation, that there are no pipe blockages? _____

In support of a building permit. Type of building addition: 009000534 ^{New} Poolhouse being built
for hook in to existing line to septic before distribution box
*System relocation for proposed addition for setback compliance _____

*Verification of adequate system capacity per COMAR 26.04.02.02D (4) _____

To replace collapsed septic tank or upgrade tank capacity _____

To replace collapsed drywell _____

Septic Contractor: _____

Contractor's Address: _____

Contractor's Phone #: _____

Property Address: _____

Property (Subdivision) & Lot # _____

Owner's Name: _____

Is public sewer available/nearby: _____

Names of Any Previous Owners: _____

Year House Built: _____

of Existing Bedrooms: _____

of Bedrooms after completion of addition: _____

Has this request been discussed previously with a Sanitarian, who? _____

If public sewer is close, further research will be performed to verify availability and possible hook up to public sewer.

A Sanitarian will be in contact within three business days depending upon the urgency of the situation to coordinate the scheduling of the repair /upgrade/evaluation. No inspection will be performed without fee collection at the office.

Environmental Sanitarian tentatively assigned _____

FAX TO 410-313-2648

Problems or questions call Tina 443-277-9806 Mac Built Const. Inc.

William E. Doyle


LAND SURVEYOR 8440

8312 EMERALD DRIVE SYKESVILLE, MARYLAND 21784 PHONE (410)-795-2210

820' to
HOBBS
ROAD

GLENWOOD SPRINGS DRIVE

R=2149.58
A=25,00

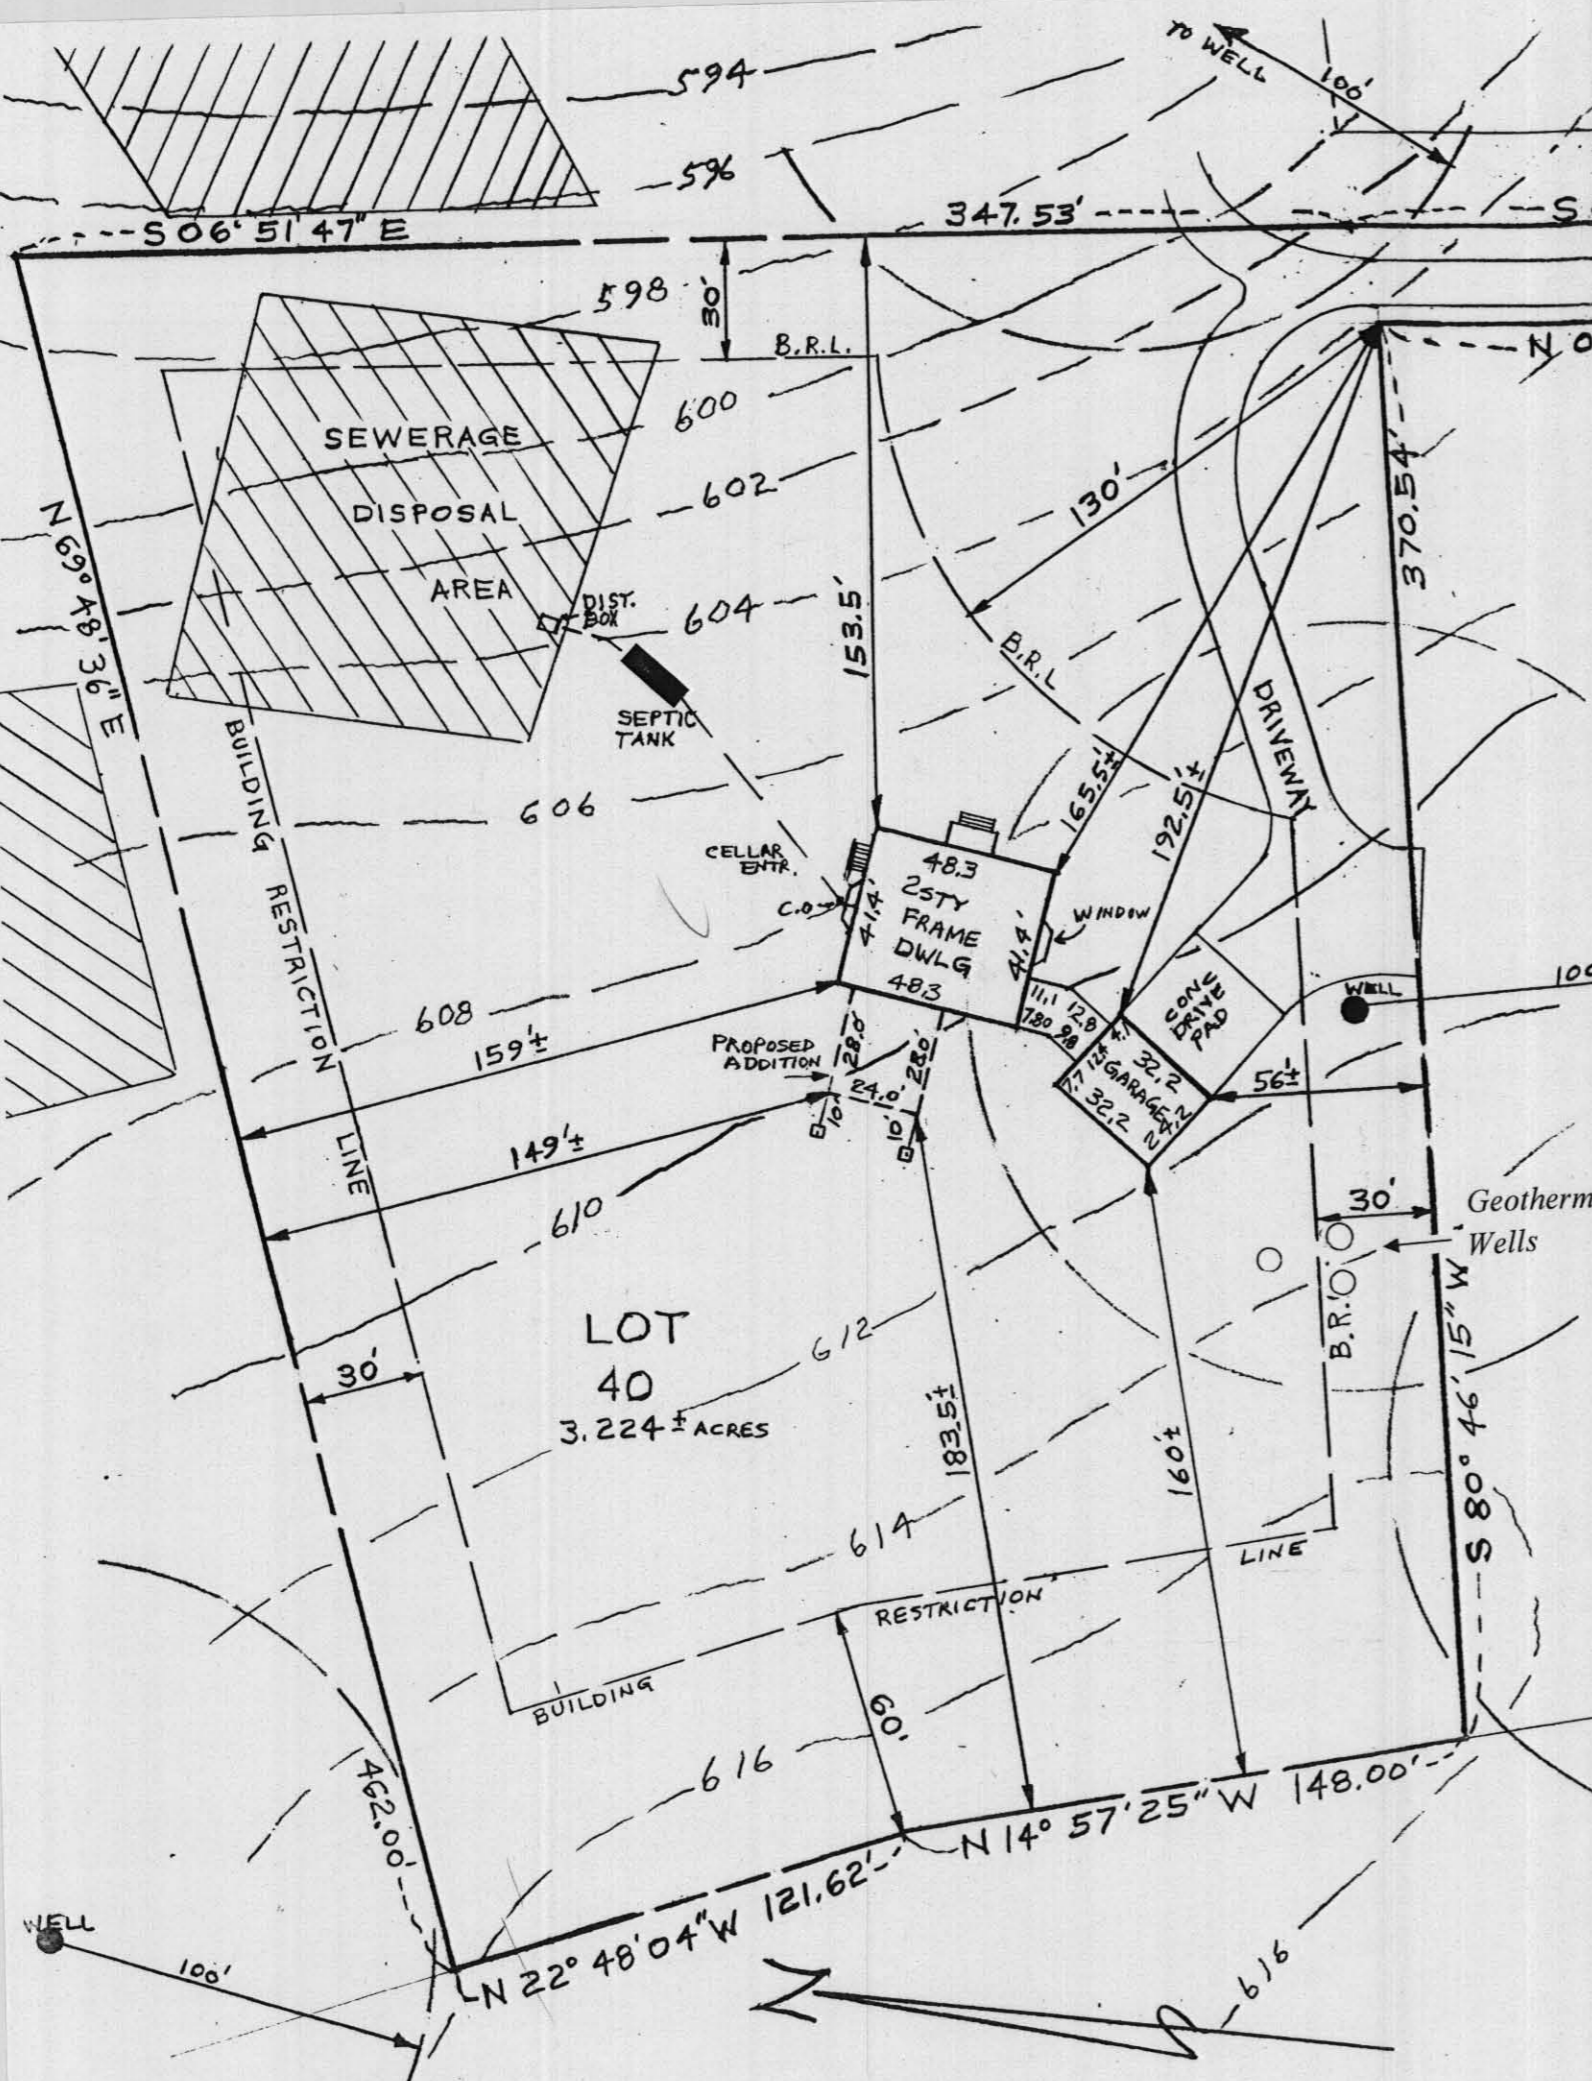

NOTE: THIS IS TO CERTIFY THAT ALL EXISTING WELLS AND SEPTIC SYSTEMS WITHIN 100 FT. OF PROPERTY BOUNDARIES HAVE BEEN SHOWN.



1) THIS AREA DESIGNATES A PRIVATE SEWAGE EASEMENT OF AT LEAST 10,000 SQUARE FEET AS REQUIRED BY THE MARYLAND DEPARTMENT OF ENVIRONMENT FOR INDIVIDUAL SEWAGE DISPOSAL. IMPROVEMENTS OF ANY NATURE IN THIS AREA ARE RESTRICTED. THIS EASEMENT SHALL BECOME NULL AND VOID UPON CONNECTION TO A PUBLIC SEWERAGE SYSTEM. THE COUNTY HEALTH OFFICER SHALL HAVE AUTHORITY TO GRANT ADJUSTMENTS TO THE PRIVATE SEWAGE EASEMENT. RECORDATION OF A REVISED SEWAGE EASEMENT SHALL NOT BE NECESSARY."

3) THIS IS TO CERTIFY THAT THE TOPOGRAPHY SHOWN HEREON IS TAKEN FROM AN APPROVED SURVEY PLAN BY; FISHER, COLLINS AND CARTER


CERTIFIED BY:
WILLIAM E. DOYLE P.L.S. 8440
SIGNED BY, *William E. Doyle*
October 2, 2008

Legend	
	Septic Tank
	Well
	Geothermal Wells
	Building Restriction Line
	Septic Easement (10,000 sq. ft.)
	Topo Lines

PROPOSED BUILDING ADDITION

2818 GLENWOOD SPRINGS DRIVE
PROPERTY OF,
PETER J. BROPHY AND
SUSAN D. BROPHY
LIBER: 6480 FOLIO: 191
LOT 40
SECTION ONE AREA ONE
GLENWOOD SPRINGS
PLAT No. 7685
4TH ELECTION DISTRICT
HOWARD COUNTY, MD
TAX MAP 14 PARCEL 229

SCALE: 1" = 50'
DRAWN: SEPTEMBER 24, 2008
REVISED: OCTOBER 2, 2008

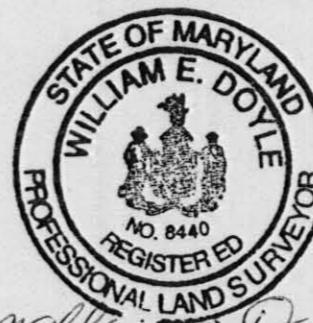

William E. Doyle

APPROVED: FOR PRIVATE WATER AND PRIVATE SEWERAGE SYSTEM

HOWARD COUNTY HEALTH DEPARTMENT

B. W. Jensen
COUNTY HEALTH OFFICER

10/21/2008
DATE

1790