

SITE INSPECTION SHEET

OWNER: \_\_\_\_\_ PHONE #: \_\_\_\_\_


ADDRESS: 12600 Golden Oak Dr. CONTRACTOR: \_\_\_\_\_

\_\_\_\_\_ WELL TAG #: \_\_\_\_\_

SUBDIVISION: \_\_\_\_\_ LOT: \_\_\_\_\_ COUNTY #: \_\_\_\_\_

PROPOSAL: Verify distance between septic tank and existing deck

LOCATION DIAGRAM

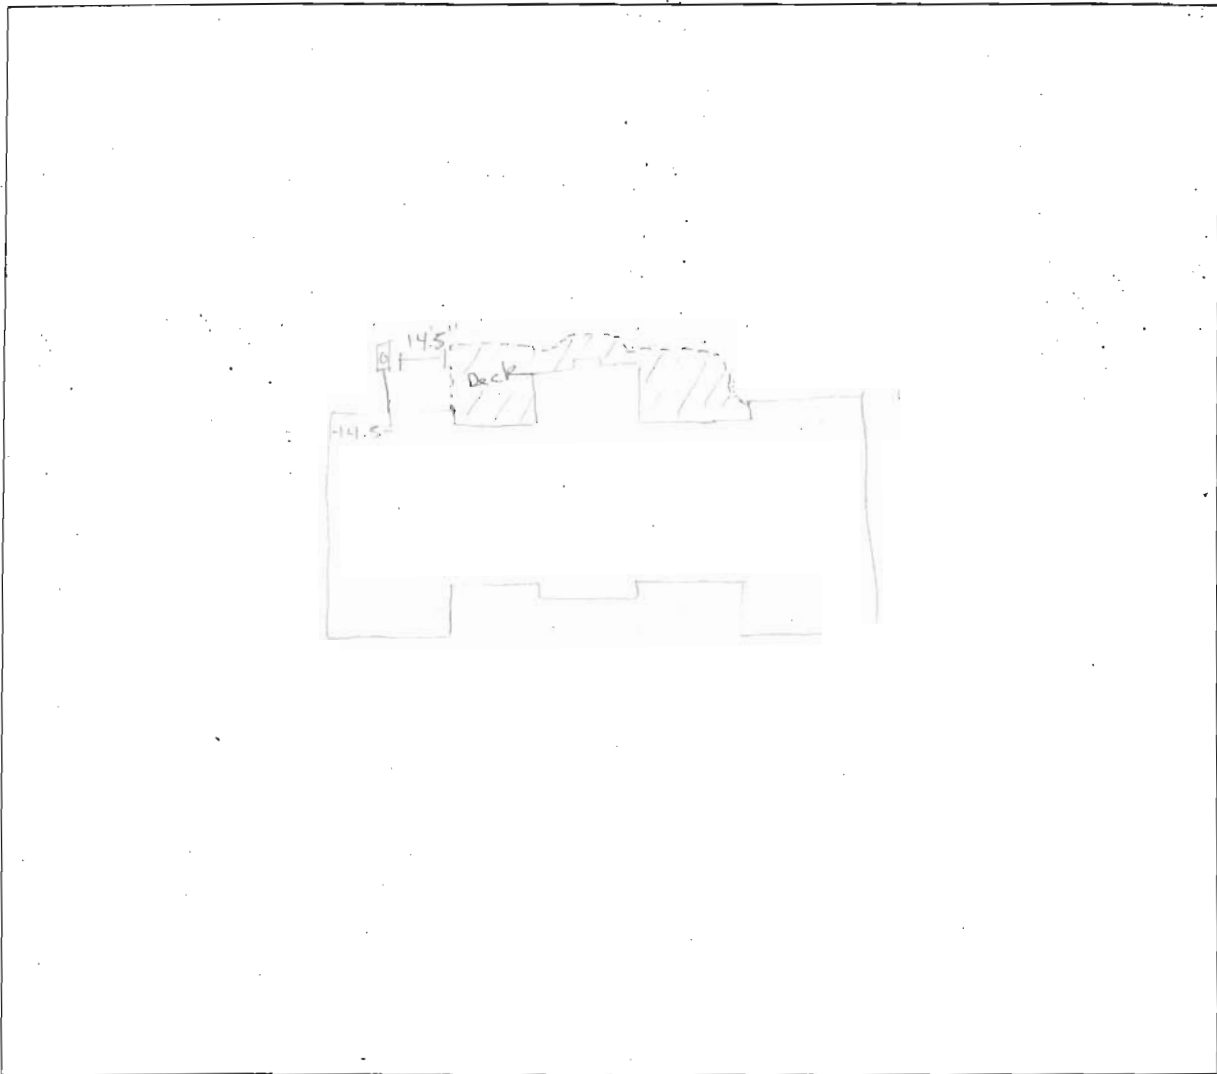

COMMENTS: Septic tank is located 14.5" from existing deck

DATE: 8/15/05 INSPECTOR: SF

1:60  
Scale

APPROVED

WALK-THRU BUILDING PERMIT

BP# 600155520 A# 301AFE PLAN

APP. SAN KJB DATE: 8/17/05

DESC. OF WORK: Deck

