

7/9/71  
between  
9:30 & 11:00 am  
perm.

APP-7-9-71  
DUB

# PERMIT

P. 16098

SEWAGE DISPOSAL SYSTEM

A. \_\_\_\_\_

MARYLAND STATE DEPARTMENT OF HEALTH

HOWARD COUNTY

ELLCOTT CITY

## INDEXED

DISTRICT 6

DATE 7/8/71

Carlo J. Petrucci IS PERMITTED TO INSTALL ALTER  X

ADDRESS 4301 34th Street, Brentwood, Md. PHONE \_\_\_\_\_

A SEWAGE DISPOSAL SYSTEM LOCATED AT \_\_\_\_\_

SUBDIVISION \_\_\_\_\_ ROAD 10621 Gorman Rd. LOT \_\_\_\_\_

PROPERTY OWNER Carlo J. Petrucci 2 bloks. off Rt. 29

ADDRESS \_\_\_\_\_

### SPECIFICATIONS

DRAIN FIELD \_\_\_\_\_ DEPTH \_\_\_\_\_ FEET. BOTTOM AREA \_\_\_\_\_ SQ. FT.

SEEPAGE PITS \_\_\_\_\_ ABSORBENT SIDE-WALL AREA \_\_\_\_\_ SQ. FT.

SEPTIC TANK CAPACITY \_\_\_\_\_ GALLONS

FOR GARBAGE GRINDER, INCREASE DISPOSAL AREA 22% & TANK CAPACITY 50%.

OTHER REPAIR - Call for inspection when ground is opened up and Sanitarian  
will recommend repair system.


7-9-71 trench 30ft long 8ft deep 6ft gravel

PLANS APPROVED BY Palmer F. Wine DATE 7/8/71

FILL SEPTIC TANK AND DISTRIBUTION BOX WITH WATER BEFORE CALLING FOR AN INSPECTION. COVER NO WORK UNTIL INSPECTED AND APPROVED.

NEITHER THE HOWARD COUNTY COMMISSIONERS NOR THE HEALTH DEPARTMENT IS RESPONSIBLE FOR THE SUCCESSFUL OPERATION OF ANY SYSTEM.

16098

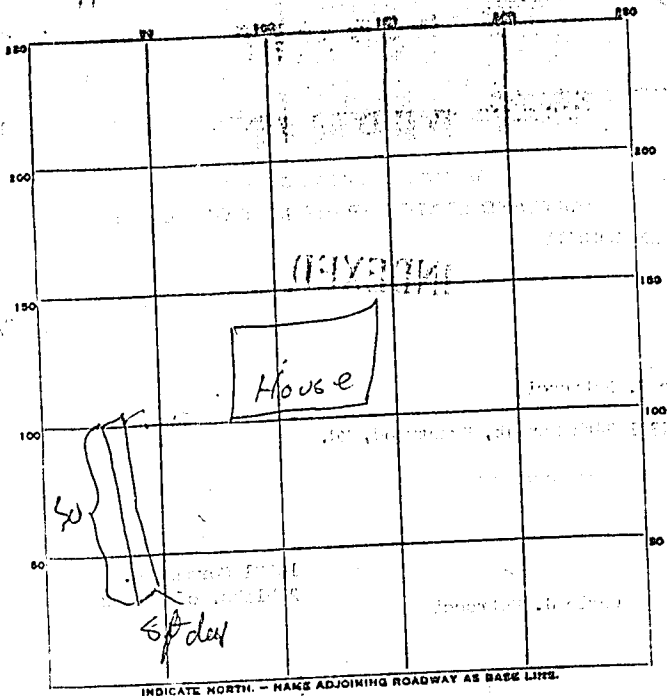

INDICATE NORTH - MAKE ADJOINING ROADWAY AS BASE LINE.

PERMIT CARD 012

SEPTIC TANK, LEVEL \_\_\_\_\_ CLEANOUTS \_\_\_\_\_

DISTRIBUTION BOX, LEVEL \_\_\_\_\_

TILE FIELD, DEPTH 4 FT. TRENCH WIDTH 2 FT.

GRAVEL DEPTH 25 IN. TOTAL LENGTH 30 FT.

NUMBER OF TRENCHES 1 TOTAL BOTTOM AREA 60

SEEPAGE PITS, INSIDE DIAMETER \_\_\_\_\_ FT. DEPTH BELOW INLET \_\_\_\_\_ FT.

ABSORBENT AREA 360 SQ. FT.

REMARKS 7-9-71 12 PM - OK to put gravel in

7-9-71 12 PM - gravel to top of gravel

DATE SYSTEM APPROVED 7-9-71 INSPECTOR Jim Monaghan