

LAYOUT _____ INSP 4 _____
INSP 2 _____ INSP 5 _____
INSP 3 _____ INSP 6 _____

ISSUE DATE: _____

PERMIT

P 516447-A

APPROVAL DATE: _____

RE-INDEX

A _____

ON-SITE SEWAGE DISPOSAL SYSTEM HOWARD COUNTY HEALTH DEPARTMENT BUREAU OF ENVIRONMENTAL HEALTH

03-298191

IS PERMITTED TO INSTALL ALTER

ADDRESS: _____ PHONE NUMBER: _____

SUBDIVISION: _____ LOT NUMBER: _____

ADDRESS: 13235 Old Frederick Road PROPERTY OWNER: Warfield

SEPTIC TANK CAPACITY (GALLONS): _____ OUTLET BAFFLE FILTER REQUIRED

PUMP CHAMBER CAPACITY (GALLONS): _____ COMPARTMENTED TANK REQUIRED

NUMBER OF BEDROOMS: _____

SQUARE FEET PER BEDROOM: _____

LINEAR FEET OF TRENCH REQUIRED: _____

TRENCHES:	Trench to be _____ feet wide. Inlet _____ feet below original grade. Bottom maximum depth _____ feet below original grade. Effective area begins at _____ feet below original grade. _____ feet of stone below distribution pipe.
LOCATION:	
NOTES:	

PLANS APPROVED: _____ DATE: _____

- NOTE: PERMIT VOID AFTER 2 YEARS
- NOTE: CONTRACTOR RESPONSIBLE FOR SCHEDULING A PRE-CONSTRUCTION INSPECTION FOR ALL INSTALLATIONS
- NOTE: WATERTIGHT SEPTIC TANKS REQUIRED
- NOTE: ALL PARTS OF SEPTIC SYSTEM SHALL BE 100 FEET FROM ANY WATER WELL
- NOTE: MANHOLE RISERS REQUIRED ON ALL SEPTIC TANKS AND PUMP CHAMBERS UNLESS SPECIFICALLY AUTHORIZED

NEITHER THE HOWARD COUNTY COUNCIL NOR THE HEALTH DEPARTMENT IS RESPONSIBLE FOR THE SUCCESSFUL OPERATION OF ANY SYSTEM PERMITTEE RESPONSIBLE FOR OBTAINING FINAL APPROVAL ON THIS PERMIT CALL 410-313-2640 FOR INSPECTION OF SEPTIC SYSTEM

516447-A

PERMIT

SEWAGE DISPOSAL SYSTEM

MARYLAND STATE DEPARTMENT OF HEALTH

17313

ELLICOTT CITY

DISTRICT 3rd

DATE 10/4/72

INDEXED

*10/10/72 At 10 o'clock
one trench has to be
completed same another
can be started due to
the stress. have permission
to install one stone
R.T.*

10/11/72

Liberty Backhoe Service

IS PERMITTED TO INSTALL & ALTER

ADDRESS Brangles Road, Box 23A, Harriottsville, Md.

PHONE 795-2642

A SEWAGE DISPOSAL SYSTEM LOCATED AT

SUBDIVISION

ROAD Old Frederick Road LOT 1

PROPERTY OWNER

Julia D. Warfield

ADDRESS P.O. Box 173, Sykesville, Maryland 21784

SPECIFICATIONS

3 bedrooms

DRAIN FIELD DEPTH FEET. BOTTOM AREA SQ. FT.

SEEPAGE PITS ABSORBENT SIDEWALL AREA SQ. FT.

SEPTIC TANK CAPACITY 1000 GALLONS

FOR GARBAGE GRINDER, INCREASE DISPOSAL AREA 22% & TANK CAPACITY 50%

OTHER TWO DEEP TRENCHES - Each trench to be 5 1/2 ft. deep - 40 ft. long with a minimum of 4 1/2 ft. of stone. Locate trenches 30 and 50 ft. from right side line and 100 to 150 ft. from rear property line as seen from Route 99.

NOTE: ALL PIPE FROM HOUSE TO SEPTIC TANK MUST BE CAST IRON.

PERMIT VOID AFTER THREE YEARS.

NOTE: INSTALL STAND PIPE ON SEPTIC TANK AND DRY WELL.

PLANS APPROVED BY Robert V. Torre


DATE 8/16/72

FILL SEPTIC TANK AND DISTRIBUTION BOX WITH WATER BEFORE CALLING FOR AN INSPECTION. COVER NO WORK UNTIL INSPECTED AND APPROVED.

NEITHER THE HOWARD COUNTY COMMISSIONERS NOR THE HEALTH DEPARTMENT IS RESPONSIBLE FOR THE SUCCESSFUL OPERATION OF ANY SYSTEM.

A 17313

DATE SYSTEM REMOVED

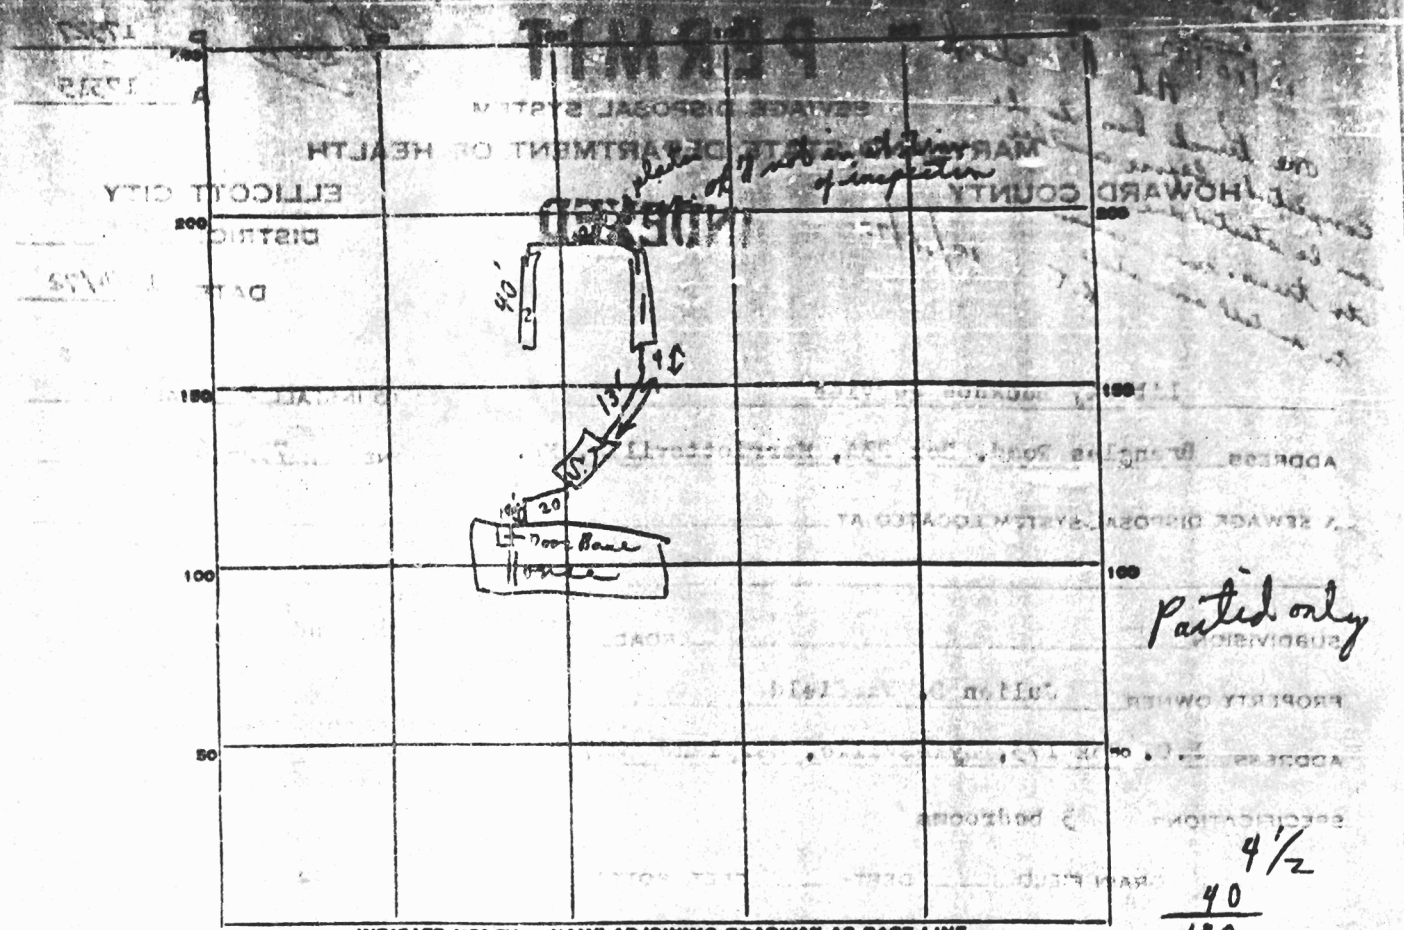

Partial only
 4 1/2
 40
 180
 110

PERMIT CARD OK Partial
 SEPTIC TANK, LEVEL OK CLEANOUTS OK Trench
 DISTRIBUTION BOX, LEVEL _____
 TILE FIELD, DEPTH _____ FT. TRENCH WIDTH _____ FT.
 GRAVEL DEPTH #1 45" TOTAL LENGTH _____ FT.
#2 8 1/2' deep 360'
 NUMBER OF TRENCHES _____ TOTAL BOTTOM AREA _____
 SEEPAGE PITS, INSIDE DIAMETER _____ FT. DEPTH BELOW INLET _____ FT.
 ABSORBENT AREA _____ SQ. FT.

REMARKS 10/10/72 S.T. not hooked up to either S.T. or #1
 Trench. Trench gravel in to 4" from top #1
 only C.B.D. { check with supervisor about outlet from
 house only F.F. #2 inspection pipes in from House to
 septic tank + from septic tank thru #1 trench only.
 #2 trench dug down to 8 1/2' 40' long. C.B.D. (2' dia)
 Topsoil gravel in + pipe. C.B.S.
 DATE SYSTEM APPROVED 12/11/72 INSPECTOR Or Monaghan

17315
APPLICATION

SEWAGE DISPOSAL TESTING

MARYLAND STATE DEPARTMENT OF HEALTH

HOWARD COUNTY SEPTIC TANK - 1000 gal. ELLICOTT CITY

8/16/72
9:30

Two Deep Trenches - EACH TRENCH TO BE 5 1/2 ft. deep - 40 ft. long
WITH A MINIMUM OF 4 ft. of cover. DISTRICT 3
DATE 8/9/72

LOCATE TRENCHES 30 and 50 ft from
right side line and 100 - 150 ft from
rear property line, as seen from RT. 99

TO: THE COUNTY HEALTH OFFICER
ELLICOTT CITY, MARYLAND

I, HEREBY, APPLY FOR THE NECESSARY TESTS IN ORDER TO CONSTRUCT (OR RECONSTRUCT) A SEWAGE
DISPOSAL SYSTEM.

PROPERTY OWNER Julian D. Warfield

ADDRESS P. O. Box 173, Sykesville, Maryland 21784 PHONE _____

PROPERTY LOCATION:

SUBDIVISION _____ LOT NO. 1

ROAD AND DESCRIPTION Old Frederick Rd. (Rt. 99 - 1 1/4 miles West of Rt. 32 on left)

OCCUPANT _____ PHONE _____

PERSON TO CONSTRUCT SYSTEM _____

ADDRESS _____ PHONE _____

SIZE OF LOT 1.0 acres (343' x 130') TYPE BLDG. 3

IF NOT SINGLE RESIDENCE DESCRIBE _____
(Single Fmly. Dwllg.)

SIGNATURE OF APPLICANT /s/ Bennett Linton

APPROVED BY Robert V. Tone FOR Deep Trenches DATE 8/16/72
(KIND OF SYSTEM)

REJECTED BY _____ FOR _____ DATE _____
(OF SYSTEM)

HOLD PENDING FURTHER TESTS _____ DATE _____

REASONS FOR REJECTION OR HOLDING _____

THIS IS NOT A PERMIT