


ATTN TIM BURGESS

8/5/93 HOKU, CO. HEALTH.

5095 1/4  
GARDEN BRIDGE RD.  
FILES A 10868  
36  
52

MARYLAND COUNTY  
WARD 001  
1000 - of  
1000  
below the  
property  
line as  
shown

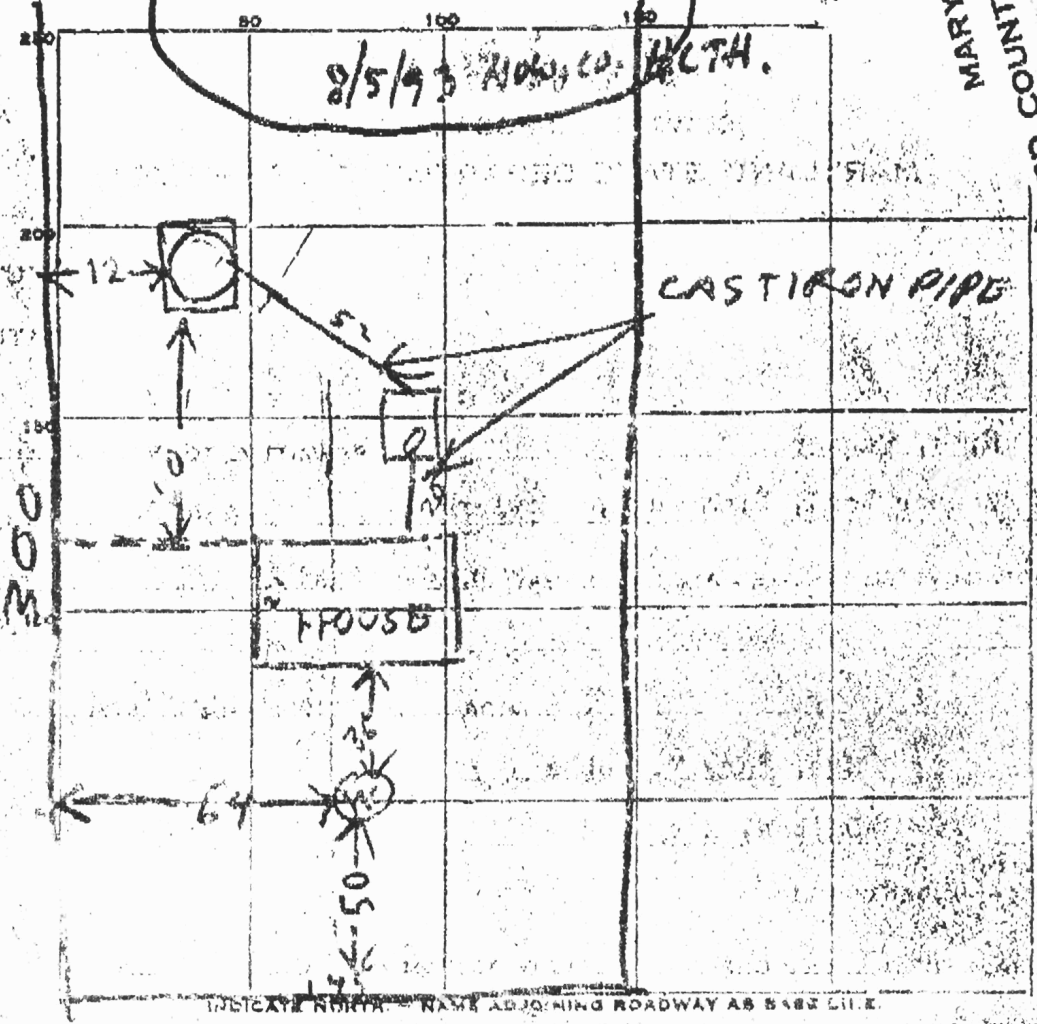

PERMIT CARD

SEPTIC TANK LEVEL at 1000 feet CLEANOUTS OK

Top as 1 FT below grade

DISTRIBUTION BOX, LEVEL \_\_\_\_\_

TILE FIELD, DEPTH \_\_\_\_\_ FT. TRENCH WIDTH \_\_\_\_\_ FT.

GRAVEL DEPTH \_\_\_\_\_ IN. TOTAL LENGTH \_\_\_\_\_ FT.


NUMBER OF TRENCHES \_\_\_\_\_ TOTAL BOTTOM AREA \_\_\_\_\_

SEEPAGE FITS, INSIDE DIAMETER 10 FT. DEPTH BELOW INLET 10 FT.

ABSORBENT AREA 520 sq. ft. counting stone

REMARKS MAR 66 - Dry Well inlet is 2 1/2 FT below grade  
Perimeter of Dry Well = 52  
52 x 10 = 520 sq ft in wall area  
counting stone

PETITIONER, TIM BURGESS PO BOX 38 DAYTON MD 21036  
 OWNER

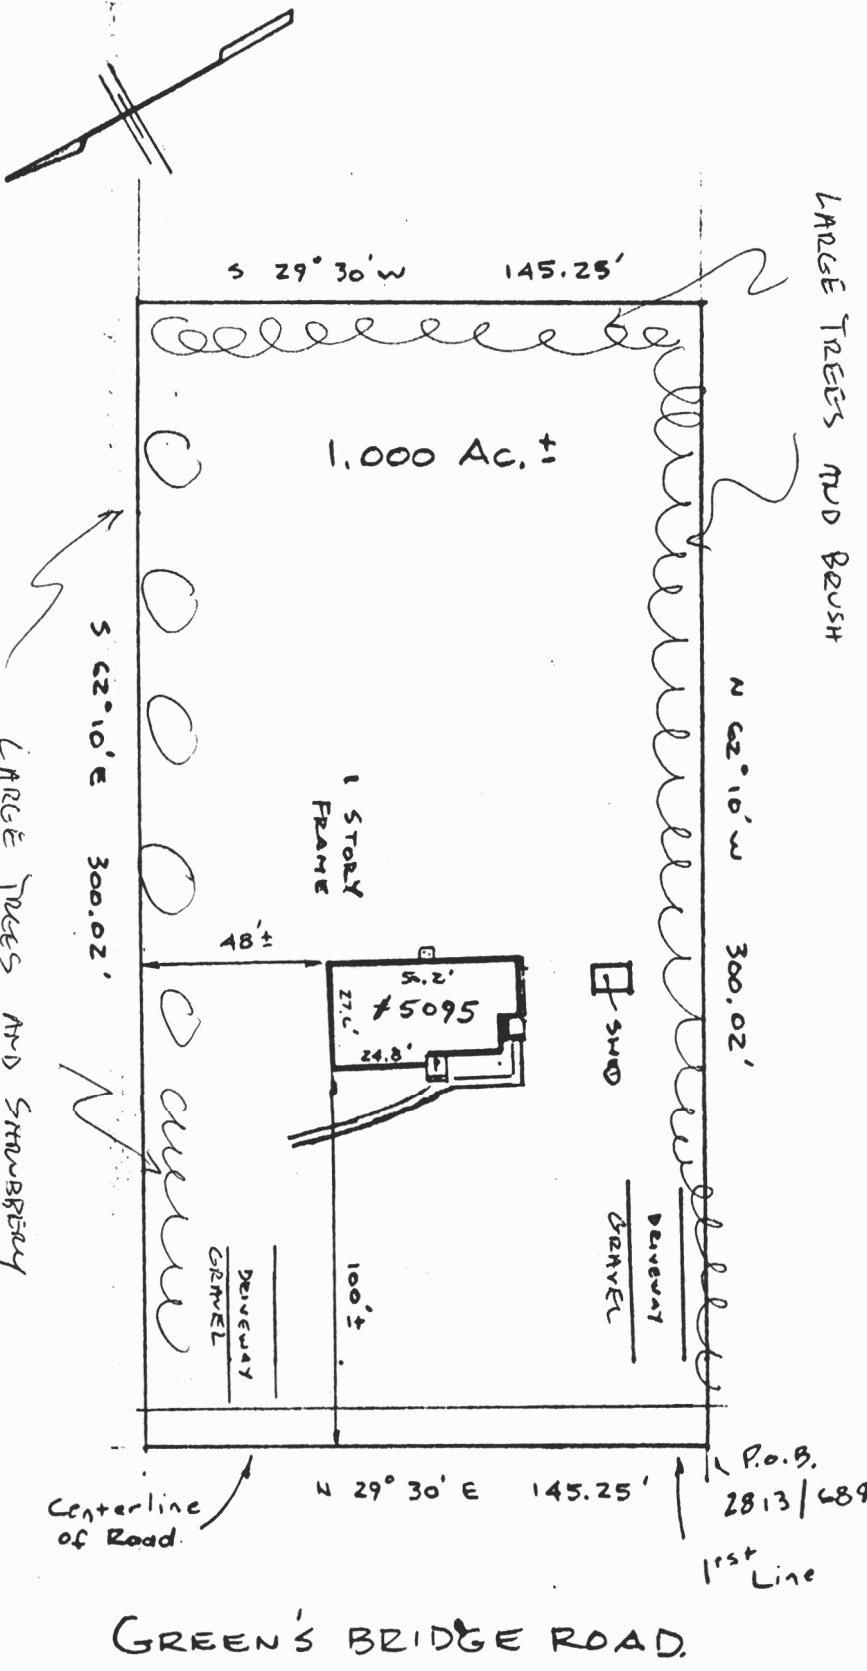

Subject property is shown in Zone C on the National Flood Insurance Program Flood Insurance Rate Map of HOWARD County, Maryland, Panel # Z4-EE-45 Community Panel # Z4D-044-0024-B Effective Date: DEC. 4, 1986

EXISTING USE: SINGLE FAMILY DWELLING 1350 S.F.  
 PROPOSED USE: MUD FARMING DWELLING 1350 S.F.

This is to certify that I have surveyed the property known as 5095 GREEN'S BRIDGE ROAD sheet of recorded 2813/689 among the Land Records of HOWARD County, Maryland for the purpose of locating the improvements thereon.

THIS PLAT SHOWS ONLY THAT THE IMPROVEMENTS ARE CONTAINED WITHIN THE OUTLINES OF THE LOT AND IS NOT TO BE USED TO ESTABLISH PROPERTY LINES.

TAK MAP 28  
 PARCEL # 56  
 ZONING PD  
 DISTRICT # 5

LOCATION SURVEY	
5095 GREEN'S BRIDGE ROAD	
HOWARD COUNTY, MD.	
NTT ASSOCIATES, INC.	
16205 Old Frederick Road	
Mt. Airy, Maryland 21771	
Phone 442-2031	
Scale	1" = 50'
Date	Aug. 28, 1993
Field By	LM
Drawn By	LM
Drawing #	EC 2577

1/2 MILE FROM INTERSECTION OF GREENBRIDGE AND TEN OAKS ROADS