


DATE	TEST NO.	DEPTH	PRE-WET		TEST - 1" DROP		TIME
			START	STOP	START	STOP	
8/22/73	1	10	1007	1003	1003	110	2
	2	5	1008	1009	1009	111	2
	3	9	1115	1113	1118	127	9
	4	5	1116	1113	1118	120	2
1/21/73	5	12"	1017	1025	1025	1035	10
1/24/73		6	1019	1019	1019	1070	1
	7	6	1023	1025	1025	1031	6
	8	13	SAME PLACE AS 7				
			ALL SAND				

4 min out for lot size & dry well say
 Max Depth 12.5 FT

SOIL AUGER FINDING

TESTED BY: R.H.
 REMARKS: Could not find 5.0 ft line. Max depth 12.5 ft or less to be cut. 3/21/73 measurement made later.

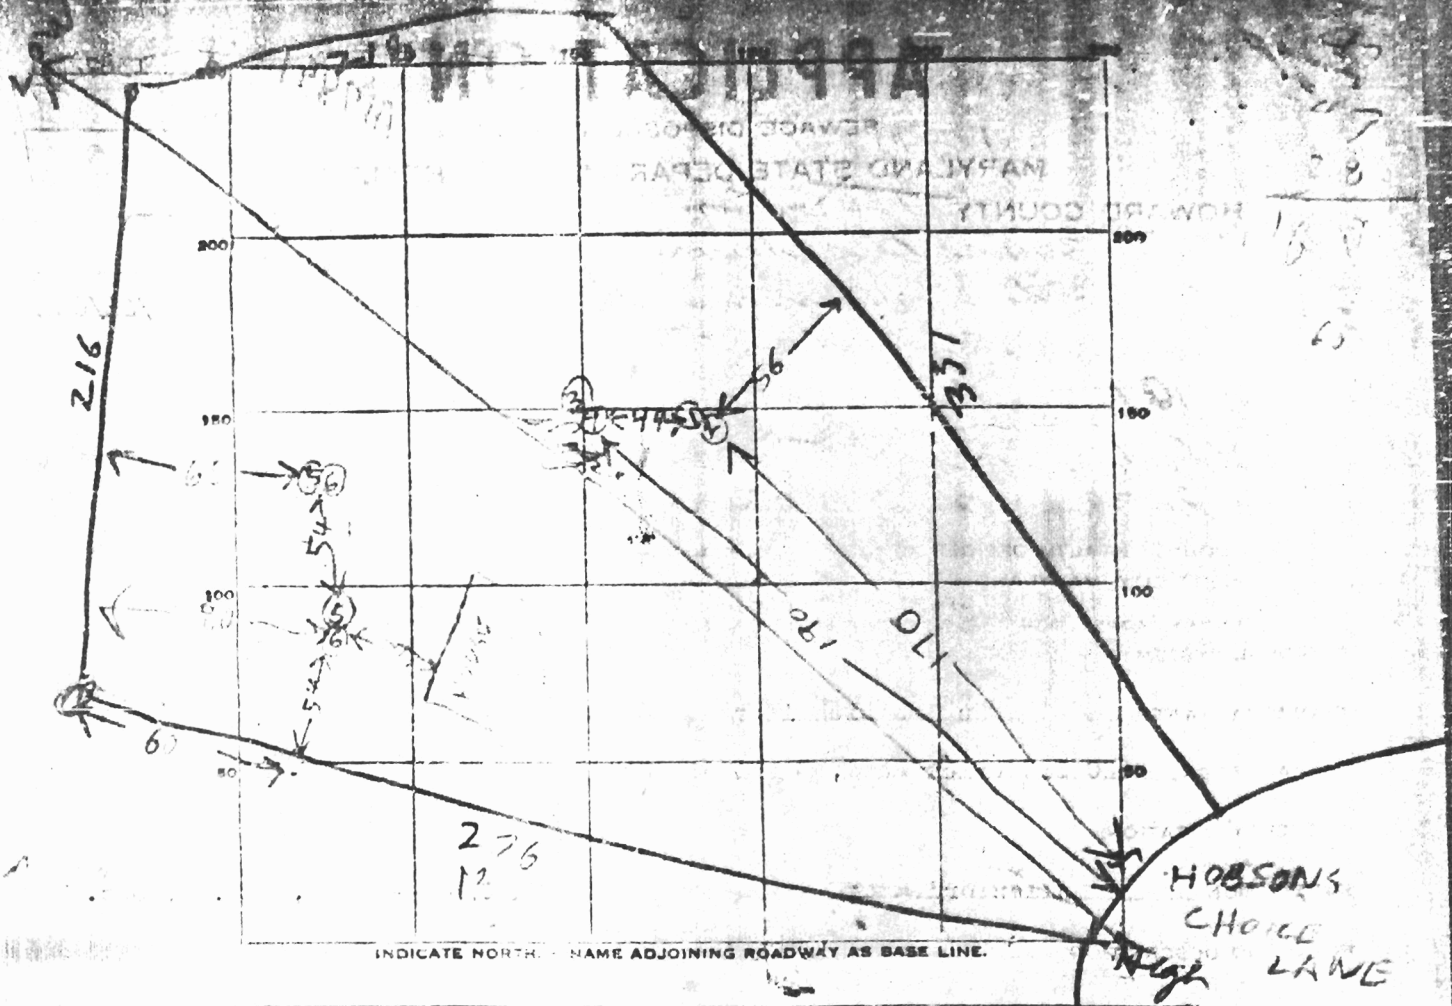

DATE	TEST NO.	DEPTH	PRE-WET		TEST - 1" DROP		TIME
			START	STOP	START	STOP	
9/28/73	1	10	1027	103	103	110	2
	2	5	108	109	109	111	2
	3	9	115	118	118	127	9
	4	5	116	113	118	120	2
11/10/73	5	12	1017	1025	1025	1035	10
1/24/73		8	1018	1019	1019	1020	1
			1023	1025	1025	1031	6
		13	SAME PLACE AS 5				
			ALL SAND				

4 min per
for bot aug
& dry soil
Max Depth
12.5 FT

SOIL AUGER FINDING

TESTED BY

REMARKS: 1 3/4" roller on ground
so to be cut 8 3/4" out 4

See original Perc Sheet				

INDICATE NORTH - NAME ADJOINING ROADWAY AS BASE LINE

DATE	TEST NO.	DEPTH	PRE-WET		TEST - 1" DROP		TIME
			START	STOP	START	STOP	
1/24/72	5	12	1017	1025	1025	1035	10
	6	6	1019	1019	1019	1020	1
	7	6	1023	1025	1025	1031	6
	8	13	SAME PLACE AS ②		ALL SAME? Roof		

REMARKS _____

TYPE OF SOIL _____

TESTED BY _____ ALSO PRESENT: _____