

# APPLICATION

SEWAGE DISPOSAL TESTING

STATE OF MARYLAND - DEPARTMENT OF HEALTH AND MENTAL HYGIENE

A 33938

P \_\_\_\_\_

HOWARD COUNTY HEALTH DEPARTMENT  
ENVIRONMENTAL HEALTH SERVICES

P. O. BOX 476 ELLICOTT CITY, MARYLAND 21043  
TELEPHONE: 992-2330

DISTRICT 5<sup>th</sup>

DATE 5-31-84

TO: THE COUNTY HEALTH OFFICER  
ELLICOTT CITY, MARYLAND

I, HEREBY, APPLY FOR THE NECESSARY TEST IN ORDER TO CONSTRUCT (OR RECONSTRUCT) A SEWAGE DISPOSAL SYSTEM

PROPERTY OWNER DAVID N. ELLIOTT

ADDRESS 6581 COL. PIK. COL PHONE 997-5833  
531-5118

PROPERTY LOCATION:

SUBDIVISION FOXHALL VILLAS LOT NO. 5

ROAD AND DESCRIPTION TRIADELPHIA MILL Rd, CLARKSVILLE

SIZE OF LOT 3 ac TYPE BLDG. RESIDENCE 3,4  
(NUMBER OF BEDROOMS)

THE SYSTEM INSTALLED UNDER THIS APPLICATION IS ACCEPTABLE ONLY UNTIL PUBLIC FACILITIES BECOME AVAILABLE. I FULLY UNDERSTAND THE FEE CONNECTED WITH THE FILING OF THIS PERC TEST APPLICATION IS NON-REFUNDABLE UNDER ANY CIRCUMSTANCES. I ALSO AGREE TO COMPLY WITH ALL M.O.S.H.A. REQUIREMENTS IN TESTING THIS LOT.

David N. Elliott  
(SIGNATURE OF APPLICANT)

APPROVED BY [Signature] FOR Shallow Test Field DATE 9/2/85

REJECTED BY \_\_\_\_\_ FOR \_\_\_\_\_ DATE \_\_\_\_\_

HOLD PENDING FURTHER TESTS \_\_\_\_\_ DATE \_\_\_\_\_

REASONS FOR REJECTION OR HOLDING 6/1/84 Hold for Review  
Water & slow flow possible wet season test  
4/25/85 DECIDED MORE HOLES WET SEASON RHOCH  
6/25/85 CW DECIDED WET SEASON NOT NEEDED. PERC OK TODAY

## THIS IS NOT A PERMIT

ALTHOUGH SOME WATER FLOW HOLD FOR PLAT  
MUST WRITE LETTER  
9/2/85 SPECS ABANDONED



# APPLICATION

SEWAGE DISPOSAL TESTING

STATE OF MARYLAND - DEPARTMENT OF HEALTH AND MENTAL HYGIENE

HOWARD COUNTY HEALTH DEPARTMENT  
ENVIRONMENTAL HEALTH SERVICES

P. O. BOX 476 ELLICOTT CITY, MARYLAND 21043  
TELEPHONE: 992-2330

A 33938

P \_\_\_\_\_

DISTRICT 5<sup>th</sup>

DATE 5-31-8

TO: THE COUNTY HEALTH OFFICER  
ELLICOTT CITY, MARYLAND

I, HEREBY, APPLY FOR THE NECESSARY TEST IN ORDER TO CONSTRUCT (OR RECONSTRUCT) A SEWAGE DISPOSAL SYSTEM

PROPERTY OWNER DAVID N. ELLIOTT

ADDRESS 6581 COL. PK. COL PHONE 997-5833  
531-51

PROPERTY LOCATION:

SUBDIVISION FOXHALL VILLAGES LOT NO. 5

ROAD AND DESCRIPTION TRIADELPHIA MILL RD, CLARKSVILLE

SIZE OF LOT 3 ac TYPE BLDG. RESIDENCE 3,4  
(NUMBER OF BEDROOMS)

THE SYSTEM INSTALLED UNDER THIS APPLICATION IS ACCEPTABLE ONLY UNTIL PUBLIC FACILITIES BECOME AVAILABLE. I FULLY UNDERSTAND THE FEE CONNECTED WITH THE FILING OF THIS PERC TEST APPLICATION IS NON-REFUNDABLE UNDER ANY CIRCUMSTANCES. I ALSO AGREE TO COMPLY WITH ALL M.O.S.H.A. REQUIREMENTS IN TESTING THIS LOT.

David N. Elliott  
(SIGNATURE OF APPLICANT)


APPROVED BY \_\_\_\_\_ FOR \_\_\_\_\_ DATE \_\_\_\_\_

REJECTED BY \_\_\_\_\_ FOR \_\_\_\_\_ DATE \_\_\_\_\_

HOLD PENDING FURTHER TESTS \_\_\_\_\_ DATE \_\_\_\_\_

REASONS FOR REJECTION OR HOLDING \_\_\_\_\_

# THIS IS NOT A PERMIT

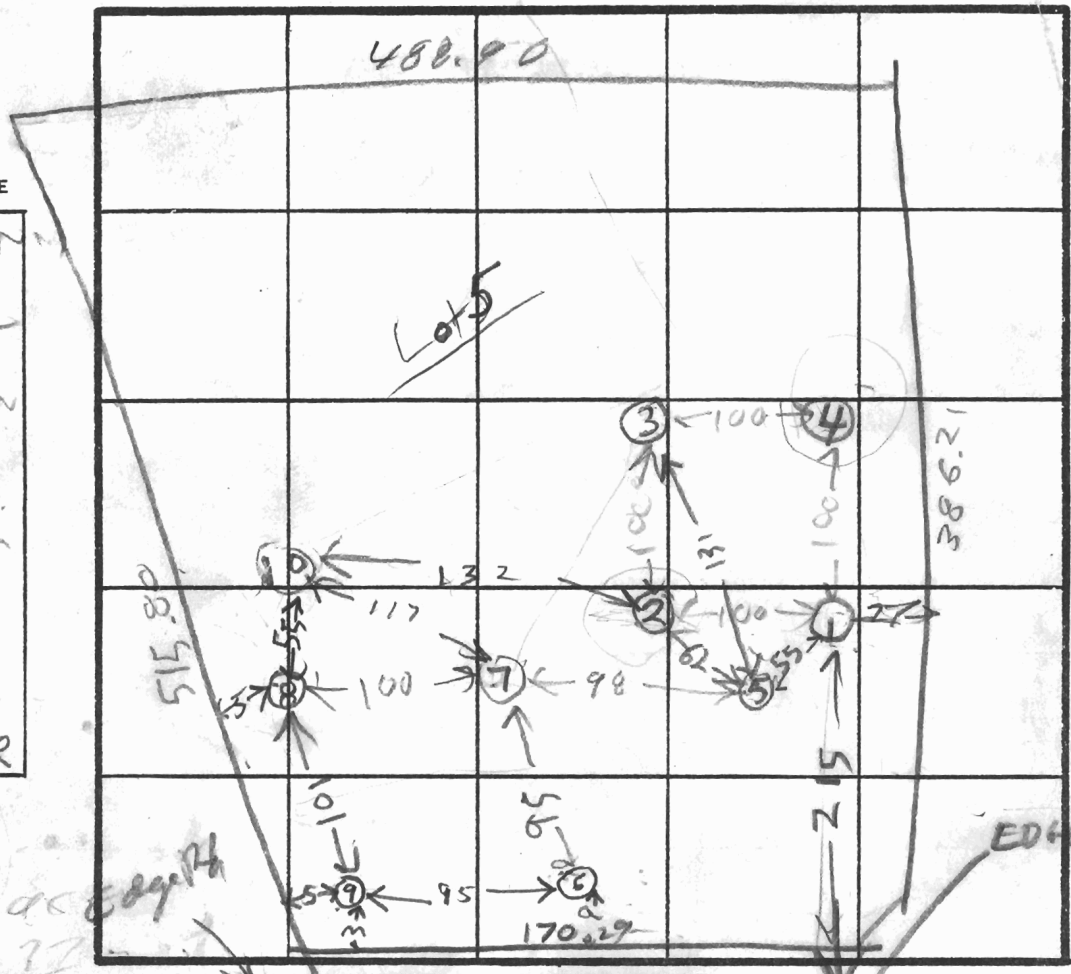

HOLE ELEV  
 ①④ HIGH  
 ②③ LOW

⑩  
 RED CLAY  
 4  
 PINK BROWN SAND LOAM  
 13

① SOIL PROFILE  
 BROWN CLAY  
 BROWN SAND LOAM  
 WATER

②  
 BROWN CLAY  
 PINK BROWN SAND LOAM  
 WATER

③  
 BROWN SAND LOAM  
 BROWN SAND LOAM

④  
 BROWN CLAY  
 BROWN SAND LOAM  
 WATER  
 ⑤  
 CLAY & TOPSOIL  
 PINK BROWN SAND

INDICATE NORTH NAME ADJOINING ROADWAY AS BASE LINE

TRIDELPHIA MILL RD

DATE	TEST NO.	DEPTH	PRE-WET		TEST - 1" DROP		TIME
			START	STOP	START	STOP	
6/1/84	1S	3 1/2	150	158	158	207	9
	1V	11	WATER		11		
	2S	4	200	232	little pin		
	2V	12	WATER		12		
	3S	3 1/2	209	217	217	230	13
6/1/84	3V	10 1/2	DRY				
	4S	3 1/2	218	227	227	235	8
	4V	10 1/2	WATER		10FT		
6/21/85	5S	3 1/2	237	341	341	348	7
	5V	12	LOOKS OK				
	6S	6	1117	1123	1123	1128	5
	6V	14	LOOKS OK				
	7S	4 1/2	1117	1122	1122	1130	00
	7V	14	LOOKS OK				
	8S	5	1120	1121	1121	1124	3
	8V	14	LOOKS OK				
	9S	4 1/2	1125	1126	1126	1130	4
	9V	13 1/2	LOOKS OK				
	10V	13	LOOKS OK		SEE PROFILE		

REMARKS HOLE (SHALLOW SYSTEM ONLY)

$\bar{x} = 5$   
 180°  
 4-6

TYPE OF SOIL  
 TESTED BY R HODGES

owner D ELLIOT, Souther Bank

Area as required by the Maryland Department of Health and Mental Hygiene.



TOTAL NUMBER OF LOTS TO BE RECORDED: 16  
 TOTAL AREA OF LOTS: 49.951 AC.±  
 TOTAL AREA OF ROADWAY TO BE RECORDED: 3.224 AC.±  
 TOTAL AREA OF SUBDIVISION: 53.155 AC.±

TOTAL SHEETS 142	SHEET 1
16	7
49.951 AC.±	21.581 AC.±
3.224 AC.±	1.585 AC.±
53.155 AC.±	23.166 AC.±


APPROVED: For Private Water and Private Sewerage Systems.

*John Bedus* 12-11-86  
 COUNTY HEALTH OFFICER DATE

APPROVED: Howard County Office of Planning and Zoning.

OWNER'S CERTIFICATE

We, David N. Elliott and Suzanne described hereon adopt this plan of Final Plat by the Office of Planning and Lines and grant unto Howard County to lay, construct and maintain sewerage and services in and under all Roadway areas shown hereon, (2) the right to use and/or roads and flood plains and of valuable consideration, hereby grant Fee Simple Title to the streets and/or Open Space where applicable and (3)

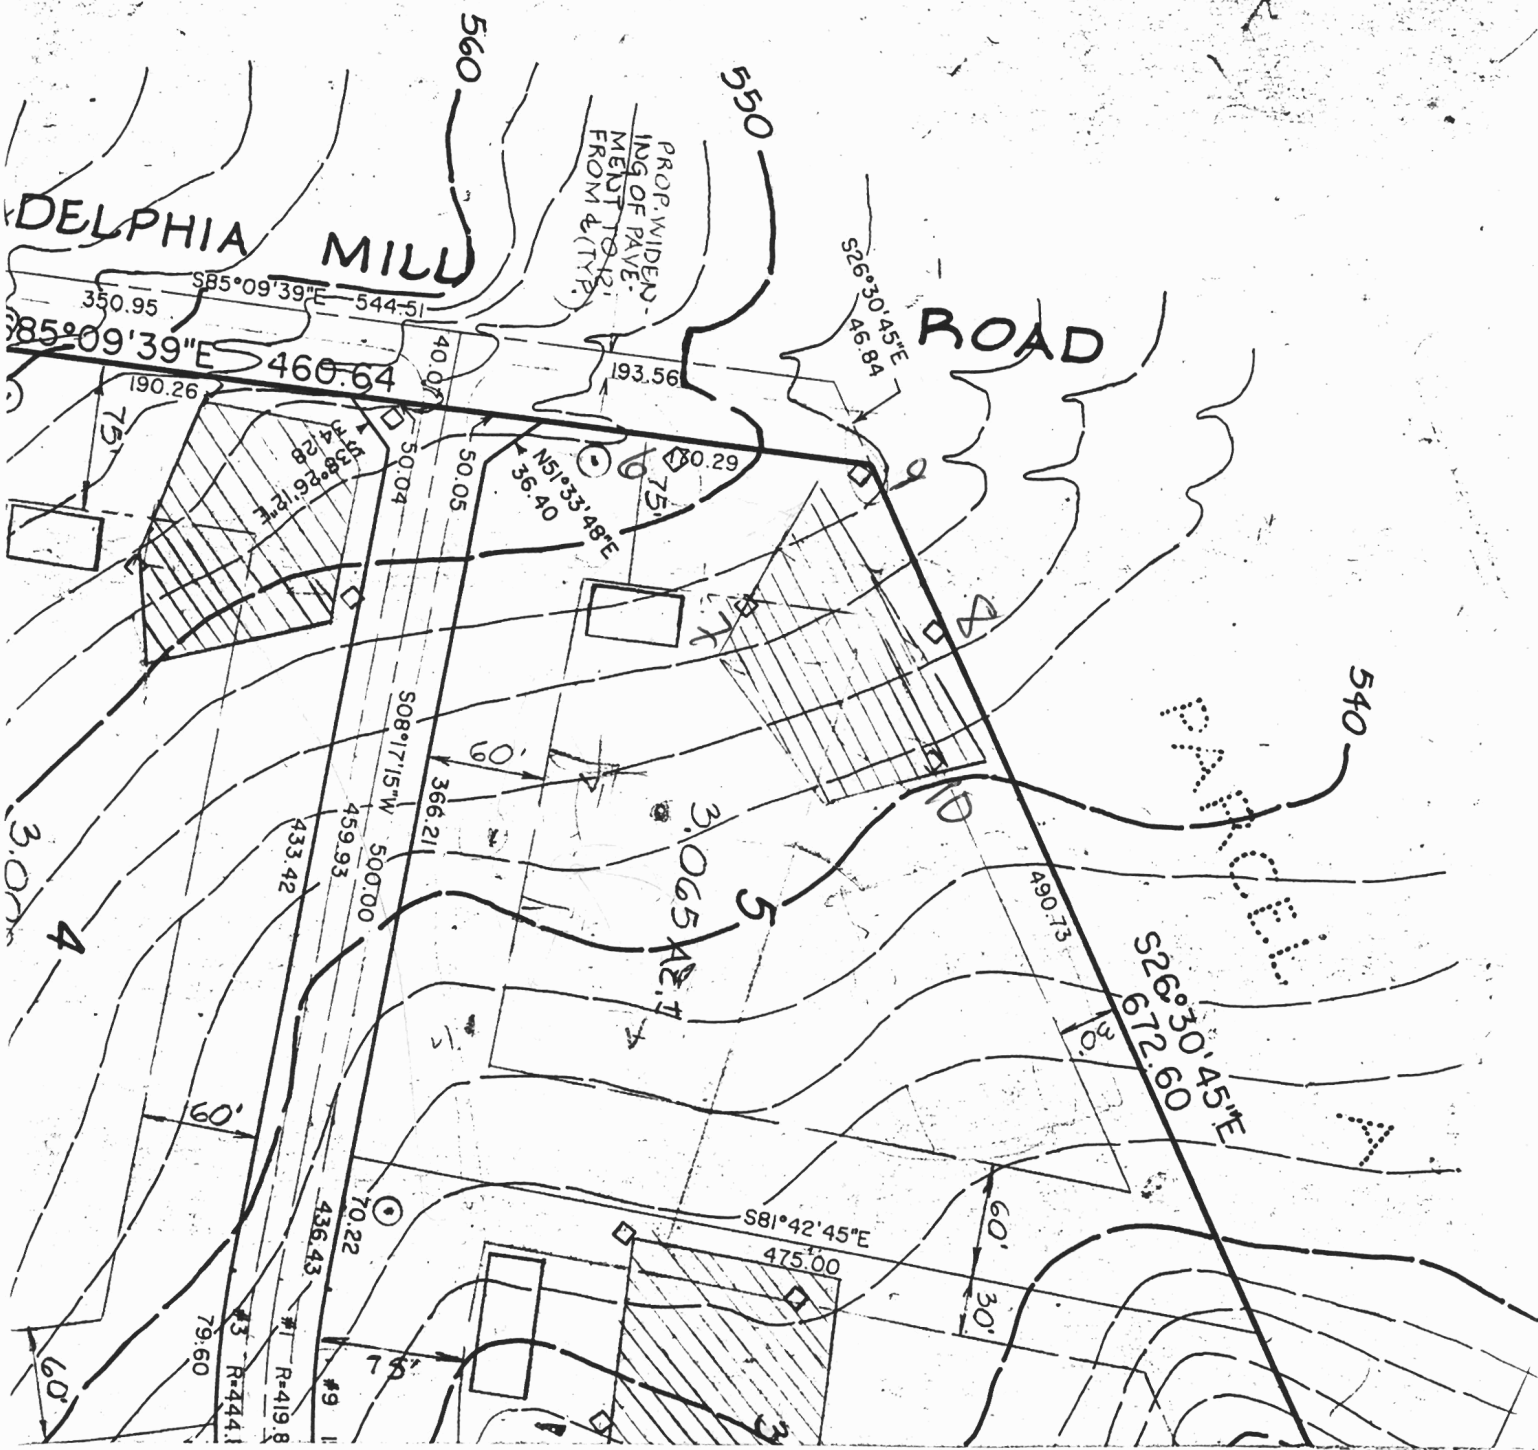

DELPHIA MILL

ROAD

DANGER

PROF. WIDENING OF PAVEMENT TO 12' FROM E (TYP.)

