

EMERGENCY/TEMP NO. IF ANY

B 1 **074**
(THIS NUMBER IS TO BE PUNCHED
IN COLS. 3-6 ON ALL CARDS)

SEQUENCE NO.
(DP USE ONLY)

STATE OF MARYLAND
APPLICATION FOR PERMIT TO DRILL WELL
please print or type

STATE PERMIT NUMBER

HD-94-V206
70 fill in this form completely 79

Date Received (APA)

061797

OWNER INFORMATION

GRENELG MAMOR ASSOC
15 Last Name Owner First Name 34
12789 FOLLY QUARTER RD
36 Street or RFD 55
WALKERVILLE CITY MD 21082
57 Town 70 State 72 Zip 76

B 3

LOCATION OF WELL


HOWARD
18 COUNTY 21
MOBEK PROPERTY
23 SUBDIVISION 42
SECTION **44** 46 LOT **7** 50
WALKERVILLE
52 NEAREST TOWN 71
MILES FROM TOWN (enter 0 if in town) **4** 73 76 77 78

DRILLER INFORMATION

Derry HARLEY
Driller's Name
HARLEY DRILLING
Firm Name
Box 160 WALKERVILLE MD 21082
Address
Derry Harley
Signature Date **6-6-97**

MSD/MCD/MWD
 MSD
77 License No. 80

B 4

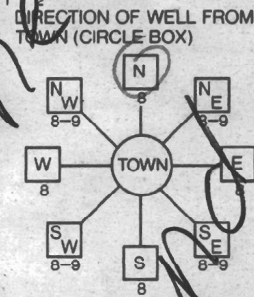

Folly Quarter rd
11 NEAR WHAT ROAD 30
ON WHICH SIDE OF ROAD
(CIRCLE APPROPRIATE BOX)
NORTH
WEST EAST
SOUTH
34 **1000** 37
DISTANCE FROM ROAD
ENTER FT OR MI **FT**
38 39

B 2 WELL INFORMATION

APPROX. PUMPING RATE (GAL. PER MIN.) **3** 8 12
AVERAGE DAILY QUANTITY NEEDED
(GAL. PER DAY) **600** 14 20


USE FOR WATER (CIRCLE APPROPRIATE BOX)

- HOME (SINGLE OR DOUBLE HOUSEHOLD UNIT ONLY)
- FARMING (LIVESTOCK WATERING & AGRICULTURAL IRRIGATION)
- INDUSTRIAL, COMMERCIAL, STATE AND FEDERAL GOV. OTHER (REQUIRES APPROPRIATION PERMIT)
- PUBLIC OR PRIVATE WATER COMPANY (REQUIRES APPROPRIATION PERMIT AND STATE HEALTH DEPARTMENT APPROVAL)
- TEST, OBSERVATION, MONITORING (MAY REQUIRE APPROPRIATION PERMIT)

NOT TO BE FILLED IN BY DRILLER
HEALTH DEPARTMENT APPROVAL

Howard CO **A56380B**
COUNTY NAME COUNTY NO.
STATE SIGNATURE _____ INSERT S 41
DATE ISSUED **6/20/97**
43 CO SIGNATURE **A M Miller** 48 EXP. DATE
NORTH GRID **510000** 50 55 EAST GRID **0810000** 57 63

APPROXIMATE DEPTH OF WELL **300** 24 FEET 28
APPROXIMATE DIAMETER OF WELL **6"** NEAREST INCH

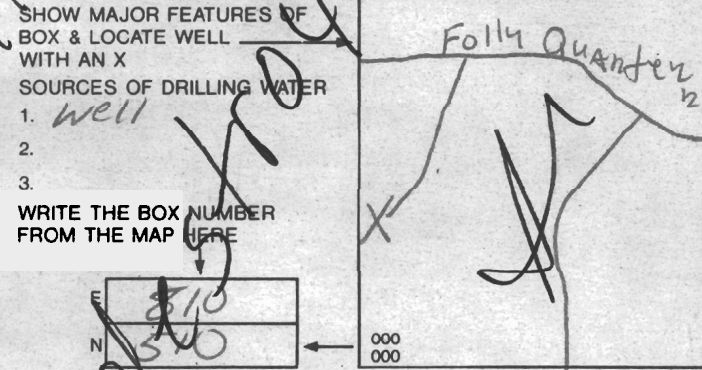

METHOD OF DRILLING (circle one)

BORED (or Augered) JETTED Jetted & DRIVEN
30 AIR-ROtary AIR-PERcussion ROTARY (Hydraulic Rotary)
37 CABLE REVerse-ROtary Drive-POINT
other _____

SHOW MAJOR FEATURES OF BOX & LOCATE WELL WITH AN X
SOURCES OF DRILLING WATER
1. **well**
2.
3.
WRITE THE BOX NUMBER FROM THE MAP HERE

REPLACEMENT OR DEEPEMED WELLS
(CIRCLE APPROPRIATE BOX)

- N THIS WELL WILL NOT REPLACE AN EXISTING WELL
 - Y THIS WELL WILL REPLACE A WELL THAT WILL BE ABANDONED AND SEALED.
 - 39 THIS WELL WILL REPLACE A WELL THAT WILL BE USED AS A STANDBY-CONTACT LOCAL APPROVING AUTHORITY FOR POLICY ON STANDBY WELLS
 - D THIS WELL WILL DEEPEM AN EXISTING WELL
- PERMIT NUMBER OF WELL TO BE REPLACED OR DEEPEMED (IF AVAILABLE) 41 _____ 52

DRAW A SKETCH BELOW SHOWING LOCATION OF WELL IN RELATION TO NEARBY TOWNS AND ROADS AND GIVE DISTANCE FROM WELL TO NEAREST ROAD JUNCTION

Folly Quarter rd
DRIVEWAY

Not to be filled in by driller (OEP USE ONLY)

APPROX. PERMIT NUMBER _____ 54 GAP _____ 63
FORCE **AM** WRITE INITIALS IN BOX 67 68 PERMIT No. **HD-94-V206** 70 71 72 73 74 75 76 77 78 79

SPECIAL CONDITIONS NOTE = APPROVING AUTHORITIES SHOULD USE SEPARATE SHEET IF NEEDED =

GLENEELG MANOR FARMS
LOT 53


EX. SEPTIC

6/20/97
Well site OK
as staked
Aut

100' 100'
S37°35'30"W

889.70'

NON-BUILDABLE
PRESERVATION PARCEL A
7.10 AC ±
TO BE DEDICATED TO H.O.A.

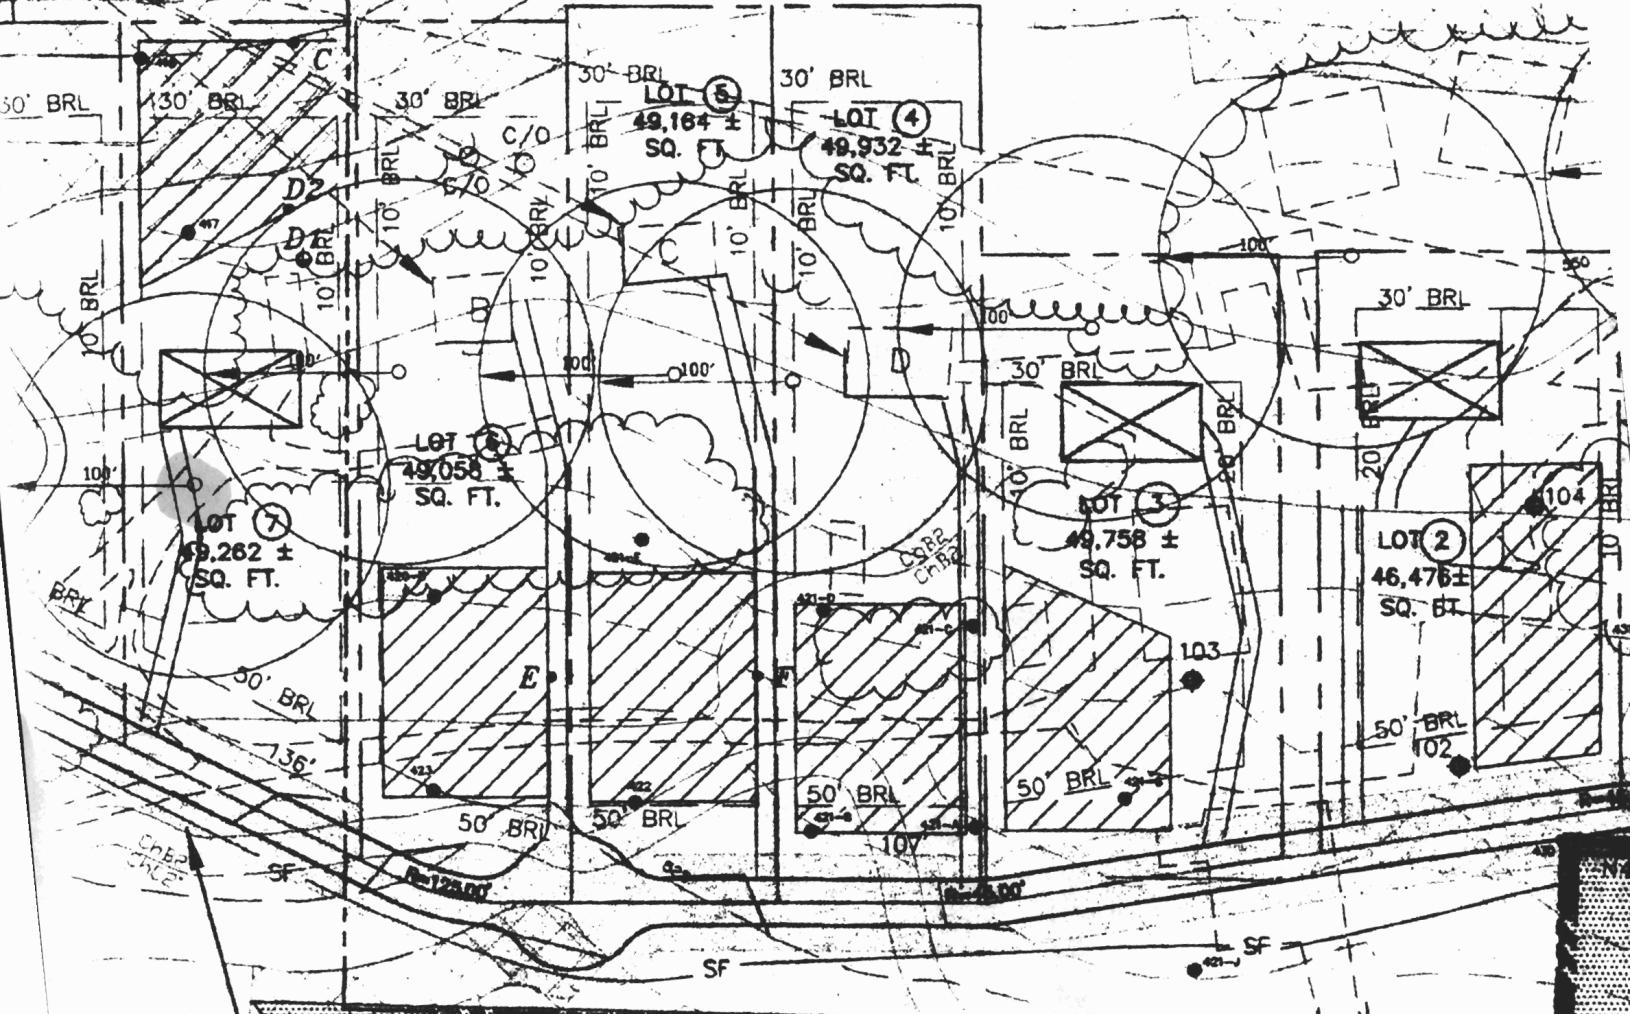

PROPOSED USE-IN-COMMON DRIVEWAY EASEMENT
FOR LOTS 1-8, PRESERVATION PARCEL A,
PARCELS 354, 356, AND 380.
(SEE NOTE 29)

