

APPLICATION

SEWAGE DISPOSAL TESTING

STATE OF MARYLAND - DEPARTMENT OF HEALTH AND MENTAL HYGIENE

HOWARD COUNTY HEALTH DEPARTMENT
ENVIRONMENTAL HEALTH SERVICES

DISTRICT 2

P. O. BOX 476, ELLICOTT CITY, MARYLAND 21043
TELEPHONE: 488-5000, EXT. 300

3BR 4BR.

DATE 3/21/74

S.T.: 1000 gal S.T.: 1250 gal.

2/22/74
9:30

The D.W. will be located 10 ft in from the left property line as seen from Henryton Rd. and will for the rear property corner measured along that line. The inlet will be 8" dia. with a max depth of 4' or less. It is believed there will be at least 300 sq ft of absorbent sidewall area in the D.W. There will be at least 500 sq ft absorbent sidewall area in the D.W.

3BR 4BR D.W.

TO: THE COUNTY HEALTH OFFICER
ELLICOTT CITY, MARYLAND

I, HEREBY, APPLY FOR THE NECESSARY TEST IN ORDER TO CONSTRUCT (OR RECONSTRUCT) A SEWAGE DISPOSAL SYSTEM.

4/9/75 Rm.
fund 600 sq ft - call for inspection of 11' man
fund after grant is installed

PROPERTY OWNER Everett L. Benschury (John 397 / John 512 / 3/2/74)

ADDRESS 1450 Henryton Road, Harriottsville, Md. PHONE 328-2696

PROPERTY LOCATION:

SUBDIVISION UNSUBD. Parcel 6

ROAD AND DESCRIPTION 1673 Henryton Road

SIZE OF LOT 5,000 sq ft TYPE BLDG. 1 OF 1

IF NOT SINGLE RESIDENCE DESCRIBE NUMBER OF BEDROOMS (Single Fmly. Bldg.)

THE SYSTEM INSTALLED UNDER THIS APPLICATION IS ACCEPTABLE ONLY UNTIL PUBLIC FACILITIES BECOME AVAILABLE.

SIGNATURE OF APPLICANT /s/ Everett Benschury


APPROVED BY [Signature] FOR Day Well DATE 4/2/75
(KIND OF SYSTEM)

REJECTED BY _____ FOR _____ DATE _____
(KIND OF SYSTEM)

HOLD PENDING FURTHER TESTS _____ DATE _____

REASONS FOR REJECTION OR HOLDING _____

THIS IS NOT A PERMIT

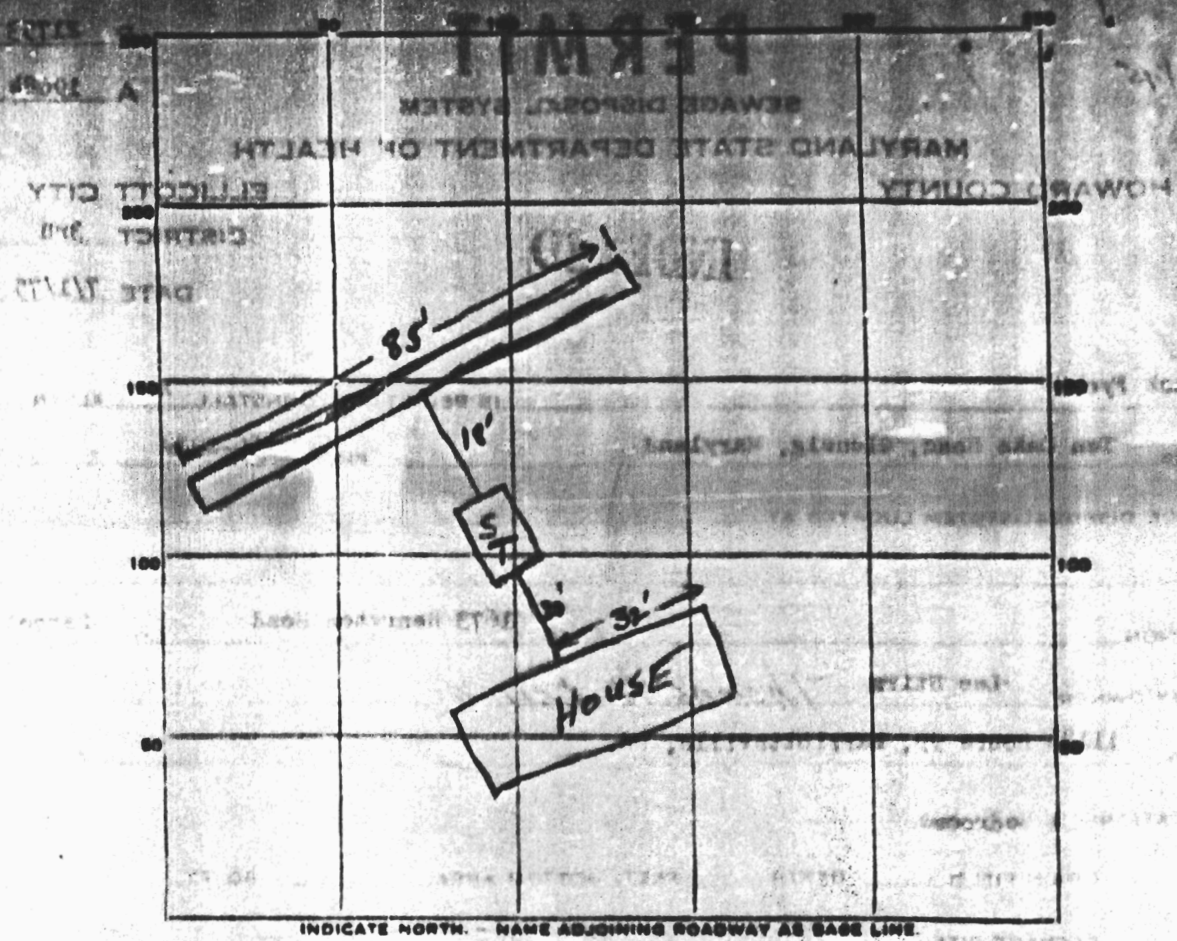

PERMIT CARD _____

SEPTIC TANK, LEVEL 1250 OK CLEANOUTS

DISTRIBUTION BOX, LEVEL _____

TILE FIELD, DEPTH _____ FT. TRENCH WIDTH 2' FT.

GRAVEL DEPTH 7 FT. TOTAL LENGTH 85 FT.

NUMBER OF TRENCHES 1 SIDEWALL TOTAL BOTTOM AREA 595

SEEPAGE PITS, INSIDE DIAMETER _____ FT. DEPTH BELOW INLET _____ FT.

ABSORBENT AREA 595 SQ. FT.

REMARKS 7/7/75 system put in uphill fr. prev area. DWM
approved this. Excellent soil. www

DATE SYSTEM APPROVED 7/7/75 INSPECTOR H. K. Fapp, 709