


PLAT PLAN SCALE: 1" = 40'-0" DATE: 3/27/02

11377 OLD HOPKINS ROAD
 CLARKSVILLE, MD. 21029
 TAX PARCEL NO.:

NOTE: KNOWN AS LOT 13 AS SHOWN ON PLAT ENTITLED "FLAMEWOOD SECTION 1" & RECORDED IN PLAT BOOK 30

301-604-1514 Rhody = last name

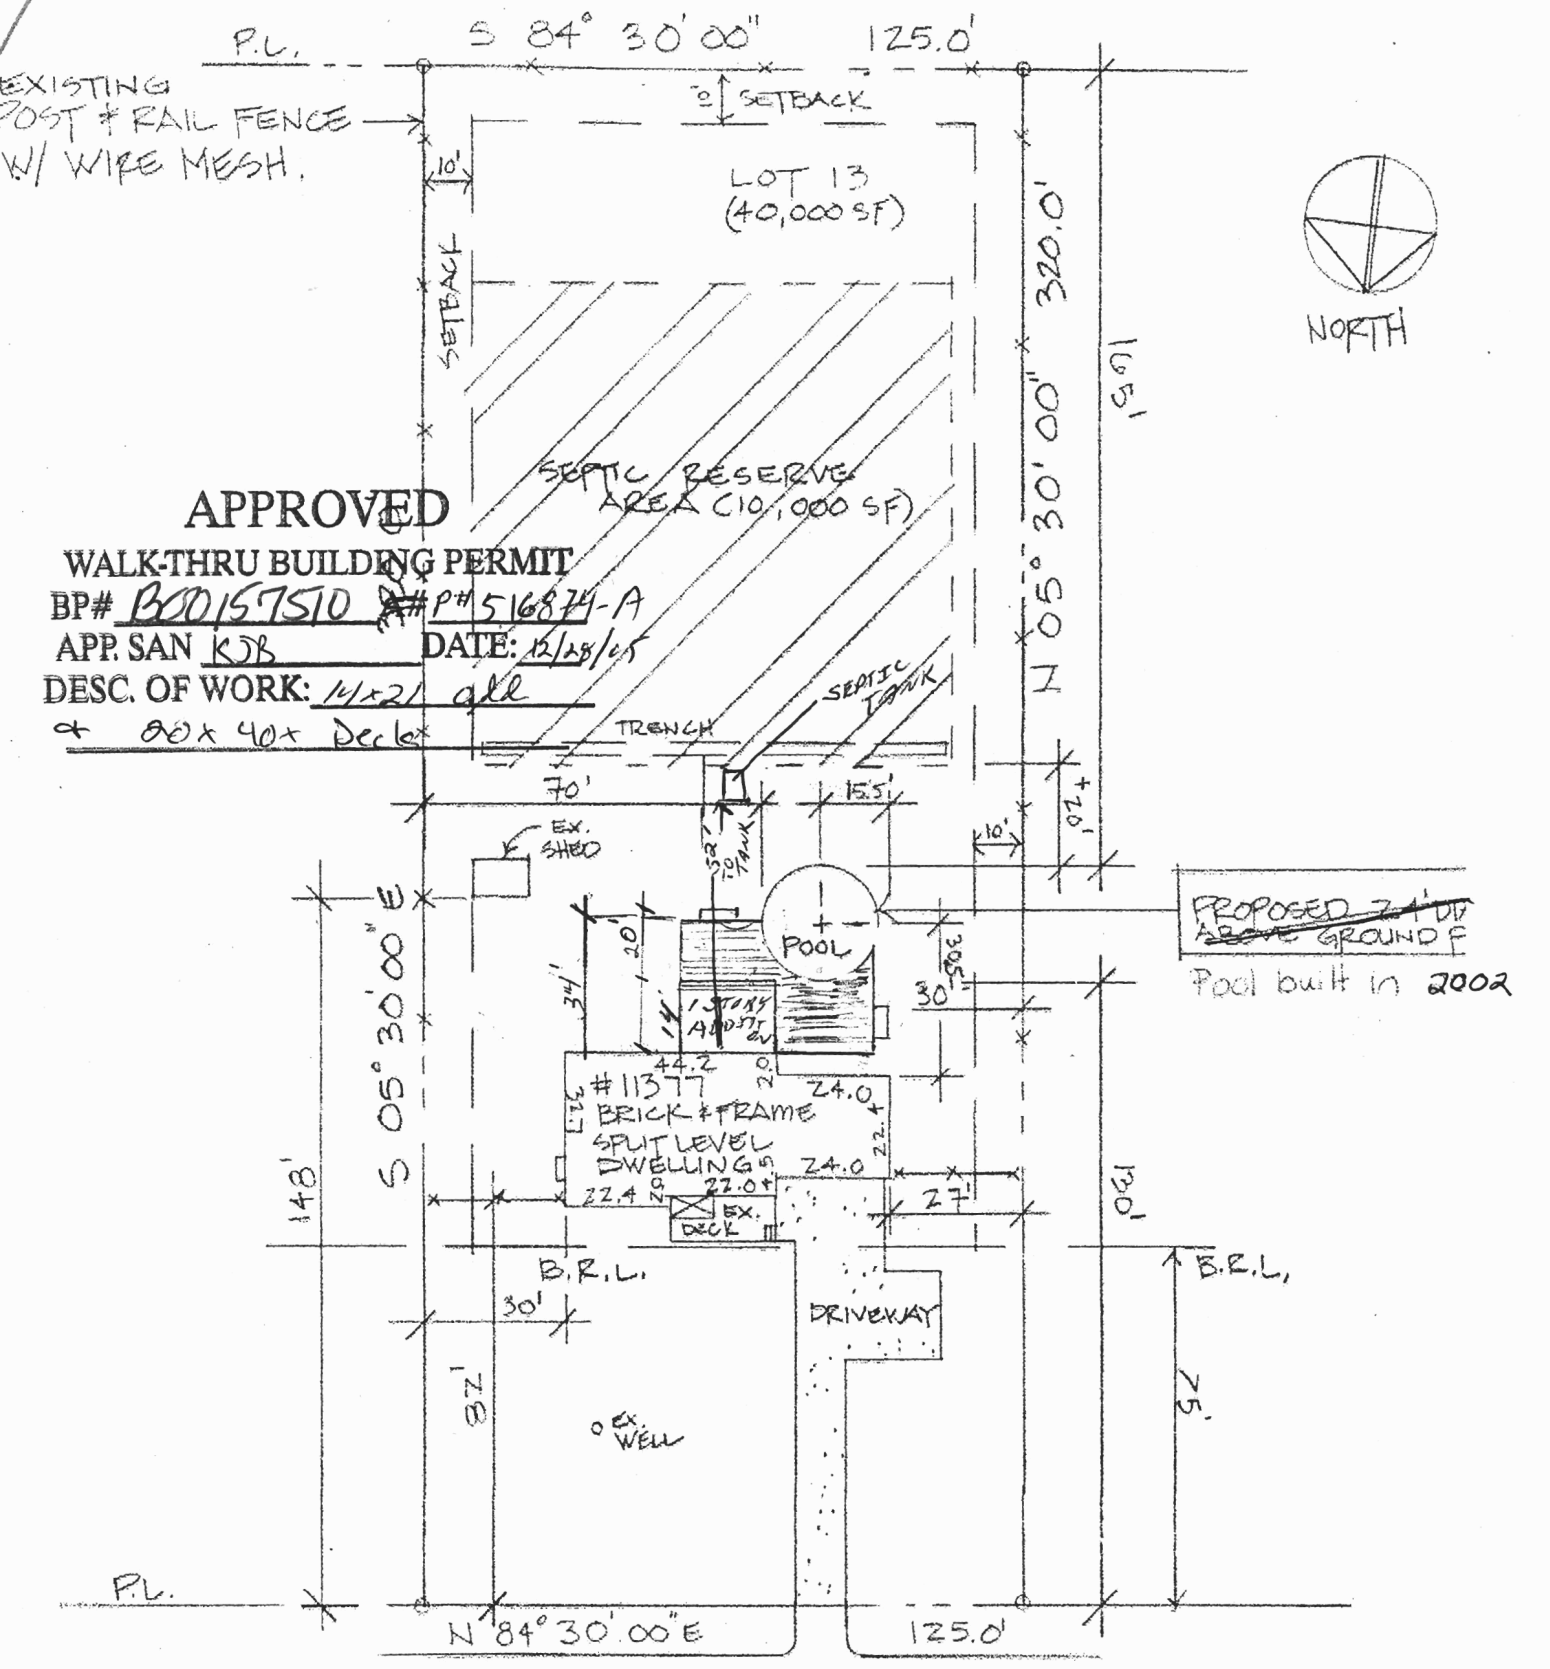

APPROVED

WALK-THRU BUILDING PERMIT

BP# B00157510 P# 516874-A

APP. SAN KJB DATE: 12/28/05

DESC. OF WORK: 14x21 all

80x40x Deck

LOT PLAN SCALE: 1" = 40'-0" DATE: 3/27/02

PROPOSED ADDITION + DECK