

*Not fields*

*file  
4/8/76  
WINT*

# PERMIT

P 2282  
A 1389

SEWAGE DISPOSAL SYSTEM

MARYLAND STATE DEPARTMENT OF HEALTH

HOWARD COUNTY

ELLICOTT CITY

DISTRICT 3rd

## INDEXED

DATE 2/18/76

Jim Brittingham IS PERMITTED TO INSTALL X ALTER

ADDRESS 3004 N. Rogers Avenue, Ellicott City, Md. PHONE 461-1870

A SEWAGE DISPOSAL SYSTEM LOCATED AT \_\_\_\_\_

SUBDIVISION Kingston ROAD 3578 Conchita Drive LOT 6, Blk. B

PROPERTY OWNER James W. King, Sr. Ms. Marcie Nuenke

ADDRESS 304 Preston Road, Simpsonville, Md.

SPECIFICATIONS 3 bedrooms

DRAIN FIELD \_\_\_\_\_ DEPTH \_\_\_\_\_ FEET, BOTTOM AREA \_\_\_\_\_ SQ. FT.

SEEPAGE PITS \_\_\_\_\_ ABSORBENT SIDE-WALL AREA \_\_\_\_\_ SQ. FT.

SEPTIC TANK CAPACITY 1000 GALLONS

FOR GARBAGE GRINDER, INCREASE DISPOSAL AREA 25% & TANK CAPACITY 50%.

OTHER DRY WELL - 350 sq. ft. absorbent sidewall area below the first 4 ft. of non-absorbent ground. Maximum depth permitted for dry well is 10 ft. below original grade. Place dry well 66 ft. from front lot line and 18 ft. from right side line as seen when facing the lot from Conchita Drive.

NOTE: ALL PIPE FROM HOUSE TO DISPOSAL AREA MUST BE CAST IRON.


PERMIT VOID AFTER THREE YEARS.

NOTE: INSTALL STAND PIPE ON SEPTIC TANK AND DRY WELL. STAND PIPES MUST BE 6 INCH IN DIAMETER. CAST IRON, CONCRETE OR TERRA COTTA ACCEPTED.

PLANS APPROVED BY Donald W. Monaghan DATE 11/26/71

FILL SEPTIC TANK AND DISTRIBUTION BOX WITH WATER BEFORE CALLING FOR AN INSPECTION. COVER NO WORK UNTIL INSPECTED AND APPROVED.

NEITHER THE HOWARD COUNTY COMMISSIONERS NOR THE HEALTH DEPARTMENT IS RESPONSIBLE FOR SUCCESSFUL OPERATION OF ANY SYSTEM.

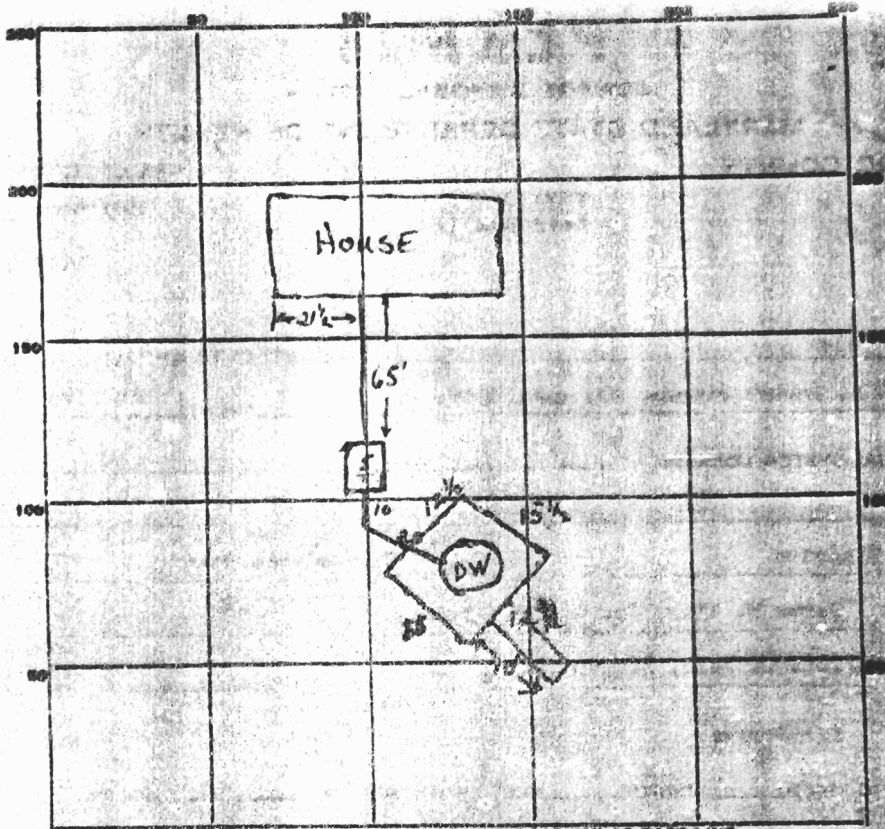

27  
5/13  
530

PERMIT CARD  \_\_\_\_\_

SEPTIC TANK, LEVEL 1500 gal ✓ CLEANOUTS ST / DW ✓

DISTRIBUTION BOX, LEVEL \_\_\_\_\_

TILE FIELD, DEPTH \_\_\_\_\_ FT. TRENCH WIDTH 2 FT.

GRAVEL DEPTH 6 FT. TOTAL LENGTH 10 FT.

NUMBER OF TRENCHES 1 TOTAL SIDEWALL BOTTOM AREA 60 sq ft

SEEPAGE PITS, INSIDE DIAMETER outside perimeter 55 FT. DEPTH BELOW INLET 0 FT.

ABSORBENT AREA 330 SQ. FT. in DW ; TOTAL 4 = 390 sq ft

REMARKS 4/13/76 AM third manhole on ST. 35" dia start in DW - dig trench off DW, 10' deep, 10' long, no pipe needed.

Re-check 4/13 PM. WWZ & HB.

PM No change WWZ & HB

4/14/76 All OK WWZ, HB

DATE SYSTEM APPROVED 4/14/76 INSPECTOR William H. Zapp