

THIS REPORT MUST BE SUBMITTED WITHIN 30 DAYS AFTER WELL COMPLETION
FILL IN THIS FORM COMPLETELY
 COUNTY NUMBER **A13389**
 PERMIT NO. FROM "PERMIT TO DRILL WELL"
41-19-193
 20 25 30 31 32 33 34 35 36 37
 209

DATE RECEIVED **3/11/76**
 DATE WELL COMPLETED _____
 DEPTH OF WELL **200**
 22 (TO NEAREST FOOT) 24
 DRILLER'S IDENTIFICATION NO. _____
 OWNER **ORALTON** FIRST NAME **Floyd**
 STREET OR RD. **541 Longlook Lane** POST OFFICE **Columbia, Md. 21043**

WELL LOG		WELL DESCRIPTION	
STATE THE KIND OF FORMATIONS PENETRATED, THEIR COLOR, DEPTH, THICKNESS AND IF WATER BEARING			
DESCRIPTION (USE APPROPRIATE LETTERS IF NECESSARY)	FEET		WELL ID
	FROM	TO	
High Sand	0	40	I
High Rock	40	200	

GRouting RECORD
 WILL HAS BEEN GROUTED (CIRCLE APPROPRIATE BOX)
 Y N
 TYPE OF GROUTING MATERIAL (CIRCLE BOX)
 CEMENT CM BENTONITE CLAY BC
 NO. OF BAGS **13** NO. OF POUNDS **1170**
 BALLONS OF WATER **130**
 DEPTH OF GROUT SEAL (TO NEAREST FOOT)
 FROM **0** FT. TO **20** FT.
 (ENTER 0 IF FROM SURFACE)

CASING RECORD
 INSERT APPROPRIATE CODE BELOW
 BY STEEL CO CONCRETE
 PL PLASTIC OY OTHER
 MAIN CASING TYPE S T
 NOMINAL DIAMETER TOP (MAIN) CASING (NEAREST INCH) **6**
 TOTAL LENGTH OF MAIN CASING (NEAREST FOOT) **20**

OTHER CASING (IF USED)
 DIAMETER (INCH) _____ DEPTH (FEET) FROM _____ TO _____


SCREEN RECORD
 INSERT APPROPRIATE CODE BELOW
 ST STEEL BR BRASS HO LEAD OPEN HOLE
 PL PLASTIC OY OTHER

DEPTH (NEAREST WHOLE FOOT)
 FROM **0** TO **200**
 1 2 3 4 5 6 7 8 9 10 11 12 13 14 15 16 17 18 19 20 21 22 23 24 25 26 27 28 29 30 31 32 33 34 35 36 37 38 39 40 41 42 43 44 45 46 47 48 49 50 51
 SLOT SIZE 1. _____ 2. _____ 3. _____

DIAMETER OF SCREEN **58** (NEAREST INCH) FROM _____ TO _____
 GRAVEL PACK _____
 IF WELL DRILLED WAS A FLOWING WELL, CIRCLE BOX F
 WRA USE ONLY (NOT TO BE FILLED IN BY DRILLER) (E.A.D.S.)
 TELESCOPE CASING LOG INDICATOR W 9 74 75 TO OTHER DATA AVAILABLE

PUMPING TEST
 HOURS PUMPED (TO NEAREST HOUR) **6**
 PUMPING RATE (BALLONS PER MINUTE TO NEAREST GALLON) **3**
 METHOD USED TO MEASURE PUMPING RATE **TIME**
 WATER LEVEL (DISTANCE FROM LAND SURFACE) BEFORE PUMPING **40** (NEAREST FOOT)
 WHEN PUMPING **130** (NEAREST FOOT)
 TYPE OF PUMPED USED (CIRCLE APPROPRIATE BOX) FOR PUMPING TEST)
 A AIR B PISTON Y TURBINE
 C CENTRIFUGAL R ROTARY O OTHER (DESCRIBE BELOW)
 J JET S SUBMERSIBLE

PUMP INSTALLED
 TYPE OF PUMP (CIRCLE APPROPRIATE LETTERS IN BOX - SEE ABOVE: A, C, J, P, R, S, T, O)
 DRILLER WILL INSTALL PUMP (CIRCLE APPROPRIATE BOX) Y N
 CAPACITY: GALLONS PER MINUTE (TO NEAREST GALLON) _____
 PUMP HORSE POWER _____
 PUMP COLUMN LENGTH (NEAREST FOOT) **20**

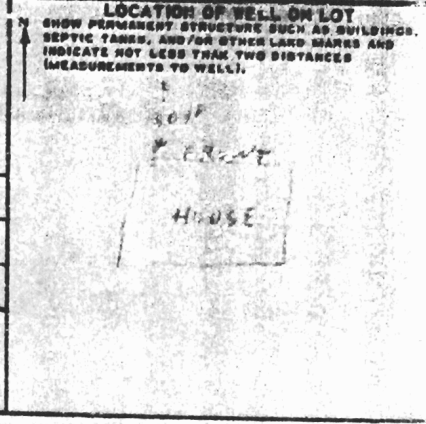

CIRCLE APPROPRIATE BOXES
 A A WELL WAS ABANDONED AND SEALED WHEN THIS WELL WAS COMPLETED
 B ELECTRIC LOG OBTAINED
 P TEST WELL CONVERTED TO PRODUCTION WELL
 I HEREBY CERTIFY THAT I HAVE COMPLIED WITH ALL CONDITIONS STATED ON THE ABOVE-CAPTIONED "PERMIT TO DRILL WELL", AND THAT INFORMATION CONTAINED IN THIS REPORT IS TRUE, ACCURATE, AND COMPLETE TO THE BEST OF MY KNOWLEDGE, INFORMATION AND BELIEF.
 DRILLER'S NAME
 (PRINT) **Howard Dillon**
 SIGNATURE _____