

PRELIMINARY

# APPLICATION

A 26616

P \_\_\_\_\_

## SEWAGE DISPOSAL TESTING

STATE OF MARYLAND - DEPARTMENT OF HEALTH AND MENTAL HYGIENE

HOWARD COUNTY HEALTH DEPARTMENT  
ENVIRONMENTAL HEALTH SERVICES

P. O. BOX 476, ELLICOTT CITY, MARYLAND 21043  
TELEPHONE: 465-5000, EXT. 356

DISTRICT 5TH

DATE 8/16/77

TO: THE COUNTY HEALTH OFFICER  
ELLICOTT CITY, MARYLAND

I, HEREBY, APPLY FOR THE NECESSARY TEST IN ORDER TO CONSTRUCT (OR RECONSTRUCT) A SEWAGE DISPOSAL SYSTEM.

PROPERTY OWNER William Mitchell

ADDRESS \_\_\_\_\_ PHONE Paul Kottis  
421-9433

PROPERTY LOCATION:

SUBDIVISION Dayton Meadows LOT NO. NEW LOT 3  
~~9, Block A~~

ROAD AND DESCRIPTION Green Bridge Road

SIZE OF LOT 40,000 sq. ft. TYPE BLDG. 3 or 4 bedrooms  
NUMBER OF BEDROOMS

IF NOT SINGLE RESIDENCE DESCRIBE \_\_\_\_\_

THE SYSTEM INSTALLED UNDER THIS APPLICATION IS ACCEPTABLE ONLY UNTIL PUBLIC FACILITIES BECOME AVAILABLE.

SIGNATURE OF APPLICANT /s/ Paul Kottis


APPROVED BY \_\_\_\_\_ FOR DW & Trend DATE \_\_\_\_\_  
(KIND OF SYSTEM)

REJECTED BY \_\_\_\_\_ FOR \_\_\_\_\_ DATE \_\_\_\_\_  
(KIND OF SYSTEM)

HOLD PENDING FURTHER TESTS \_\_\_\_\_ DATE \_\_\_\_\_

REASONS FOR REJECTION OR HOLDING \_\_\_\_\_

# THIS IS NOT A PERMIT

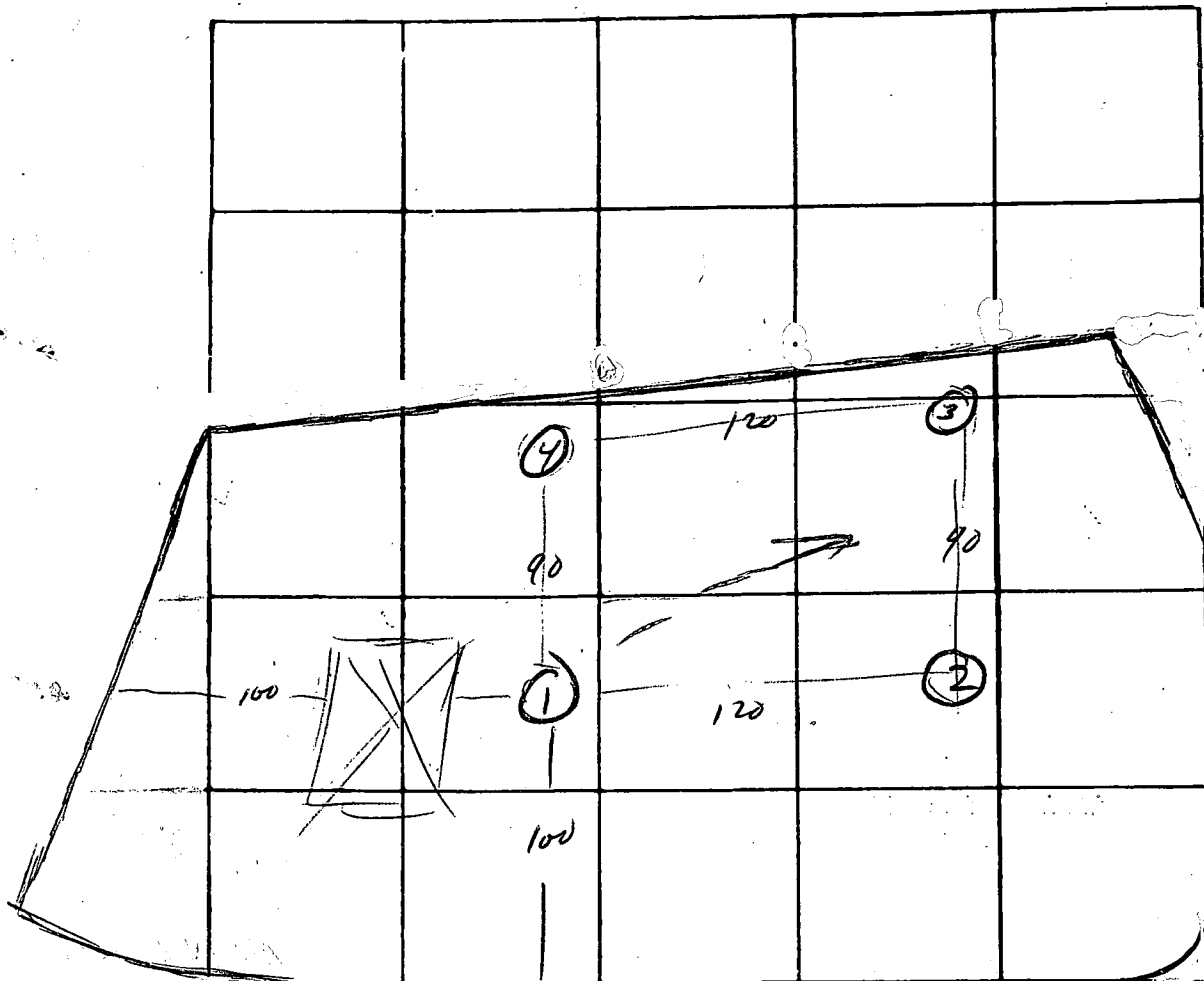

INDICATE NORTH. - NAME ADJOINING ROADWAY AS BASE LINE

← RW →

DATE	TEST NO.	DEPTH	PRE-WET		TEST - 1" DROP		TIME
			START	STOP	START	STOP	
23 Aug 77	1	3½	120	122	122	134	7
		14	120	132	132	205	28
	2	3½	115	120	120	122	7
		14	115	122	122	152	25
	<del>4</del>	3¾	125	130	130	137	7
		14½	130	150	150	216	26
	<del>5</del>	<del>13</del>	<del>115</del>	<del>120</del>	<del>120</del>	<del>122</del>	
	3	3½	230	231	231	237	6
		14	"	"	"	237	6

REMARKS \_\_\_\_\_

TYPE OF SOIL \_\_\_\_\_

TESTED BY W ALSO PRESENT P. Roth