

PERMIT

SEWAGE DISPOSAL SYSTEM

MARYLAND STATE DEPARTMENT OF HEALTH*

HOWARD COUNTY
BUREAU OF ENVIRONMENTAL HEALTH

~~992-2330~~
461-9933

05-399767

INDEXED

ELLICOTT CITY

DISTRICT 5th

DATE 7/02/86

APPROVED
11/21/86
RH

P 37324
A 26616

William Lee Wertz, Inc. IS PERMITTED TO INSTALL ALTER

ADDRESS 2517 North Rolling Road, Baltimore, Maryland 21207 PHONE 265-5259

SUBDIVISION Dayton Meadows ROAD 4868 Greenbridge Rd LOT 3

PROPERTY OWNER William V. Wertz, Inc.

ADDRESS _____

IF GARBAGE GRINDER IS USED INCREASE SEPTIC TANK CAPACITY BY 50% AND ABSORPTION AREA BY 22%.

GARBAGE GRINDER? YES NO

SEPTIC TANK CAPACITY 1250 GALLONS NUMBER OF BEDROOMS 4

5.5' 1800'
32'
25'
22'

TRENCHES - 200 sq. ft. per bedroom. Trench to be 2 feet wide. Inlet 3½ feet below original grade. Bottom maximum depth 9 feet below original grade. Effective area begins at 3½ feet below original grade. 5½ feet of stone below distribution pipe.

LOCATION - Start the first trench 320 feet from the rear lot line and 35 feet from the left lot line as seen when facing the property from Greenbridge Road. Run trench(s) along contour toward right side of property.

NOTE - No trench to exceed 100 feet in length. If more than one trench used, a distribution box is required. Call for inspection of trench(s) before and after gravel is installed. Provide 6" - 8" diameter cleanout and cap to grade or above on septic tank. OK/CW

**BUILDING PERMIT SIGNED
AND RETURNED**

324104 BDD146994 - PATIO

PLANS APPROVED BY C. Williams DATE 6/11/86

COVER NO WORK UNTIL INSPECTED AND APPROVED.

NEITHER THE HOWARD COUNTY COUNCIL NOR THE HEALTH DEPARTMENT IS RESPONSIBLE FOR THE SUCCESSFUL OPERATION OF ANY SYSTEM.

NOTE: IF TRENCH IS USED CALL FOR INSPECTION BEFORE AND AFTER PLACING GRAVEL IN TRENCH.

NOTE: NO DRY WELL SHALL EXCEED 15 FOOT IN DIAMETER. NO ABSORPTION TRENCH TO EXCEED 100 FEET IN LENGTH.

NOTE: ALL PIPE FROM HOUSE TO SEPTIC TANK MUST BE CAST IRON OR SCHEDULE 40 PVC OR ABS.

PERMIT VOID AFTER THREE YEARS.


NOTE: INSTALL STAND PIPE ON SEPTIC TANK AND DRY WELL. STAND PIPES MUST BE 6 INCHES IN DIAMETER. CAST IRON, CONCRETE OR TERRA COTTA, OR PVC OR ABS ACCEPTED. IF TOP OF SEPTIC TANK IS DEEPER THAN 3 FEET MANHOLE TO GRADE REQUIRED.

***INSTALLER IS RESPONSIBLE FOR OBTAINING FINAL APPROVAL ON THIS PERMIT**

*CALL 992-2330 FOR INSPECTION OF SEPTIC SYSTEMS.

EH - 2-1082

A 26616

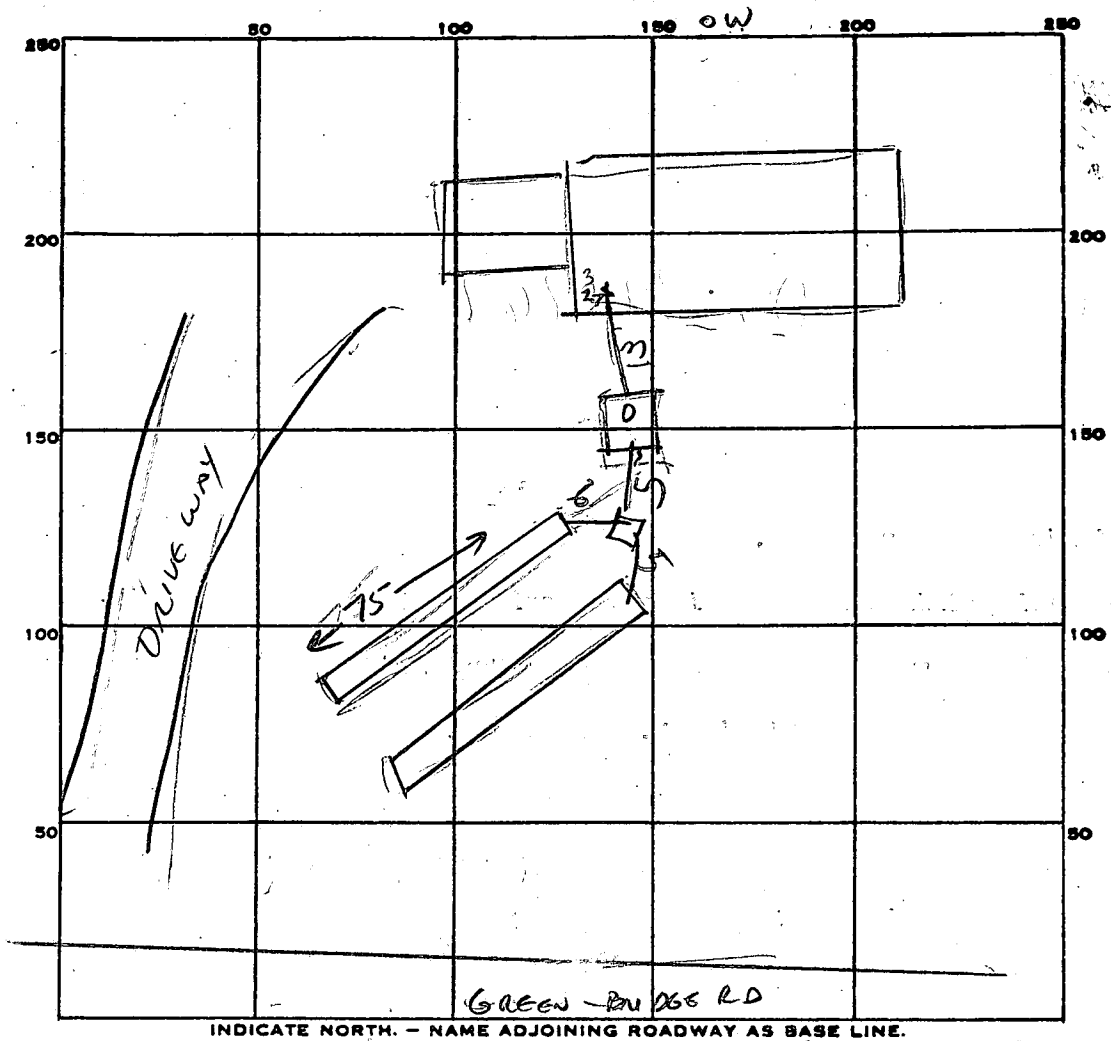

PERMIT CARD _____

SEPTIC TANK, LEVEL 150.0

CLEANOUTS ST
OK

DISTRIBUTION BOX, LEVEL _____

TILE FIELD, DEPTH 9 FT. TRENCH WIDTH 2 FT.

GRAVEL DEPTH _____ IN. TOTAL LENGTH 150 FT.

NUMBER OF TRENCHES 2 (75+75) TOTAL BOTTOM AREA 929

BUILDING PERMITS SIGNED
AND RETURNED

(E007001001)
FOR 3 BR

SEEPAGE PITS, INSIDE DIAMETER _____ FT. DEPTH BELOW INLET _____ FT.

ABSORBENT AREA _____ SQ. FT.

REMARKS 11/20/86 TWO TRENCHES TO CONNECT DEPTH - WEATHER THREATENING

CONTRACTOR INFORMED TO GRAVEL AND COVER. CHILLER

11/21/88 - JOB FINISHED R1

DATE SYSTEM APPROVED 11/21/86

INSPECTOR Raymond Hodges

