


Kavita Mester
 Pradeep Goel
 301-497-4398

S 85° 37' 18" W 235.39'

N 16° 43' 27" W 283.20'

S 15° 04' 10" W 274.58'

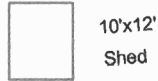

LOT 3
 42431 sq ft

Dry Well

New Saniatic Tank
 10' x 8' x 10'

C.O.

Layout #4

24' +/-

75' BRL

Well

83' +/-



12/18/03
 Spoke to
 owner.
 NEEDS to
 submit
 perc app
 For upgrade
 (KN)

No ~~perm~~
 permit filed
 for add-on
 yet.

Print scale: 1" : 360"


1:30

Print date: December 16, 2003

A = 85.41' R = 445.00'

pcgoel@yahoo.com

APPLICATION

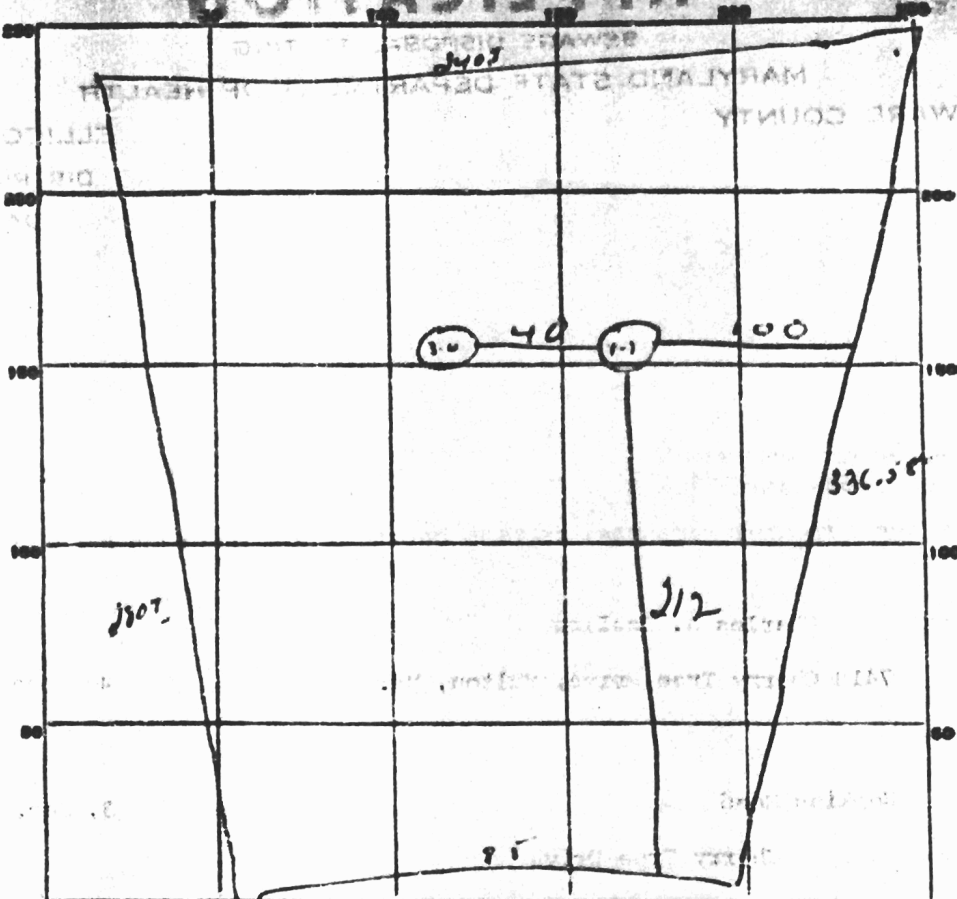

INDICATE NORTH - NAME ADJOINING ROADWAY AS BASE LINE.

Cherry tree drive

DATE	TEST NO.	DEPTH	PRE-WET		TEST - 1" DROP		TIME
			START	STOP	START	STOP	
2-16-72	1	12ft	11 05	11 07	11 07	11 12	6 min
	2	5ft	11 05	slow pace			
	3	6ft	11 12	11 16	11 15	11 22	8 min
	4	12ft	11 14	11 17	11 17	11 22	5 min

4.9
13 min
20

SOIL AUGER FINDING _____

TESTED BY _____

REMARKS *not necessary to edge of base layer system below for 5' top*