


20604

Flat of
Part of Parcels No. 1 and 2 Combined
HALLOWELL'S ADDITION
Fifth Election District
Howard County, Maryland.

Dated October 1974
Scale 1" = 100'
By: R. . . Maddox, Surveyor
Rockville, Maryland.

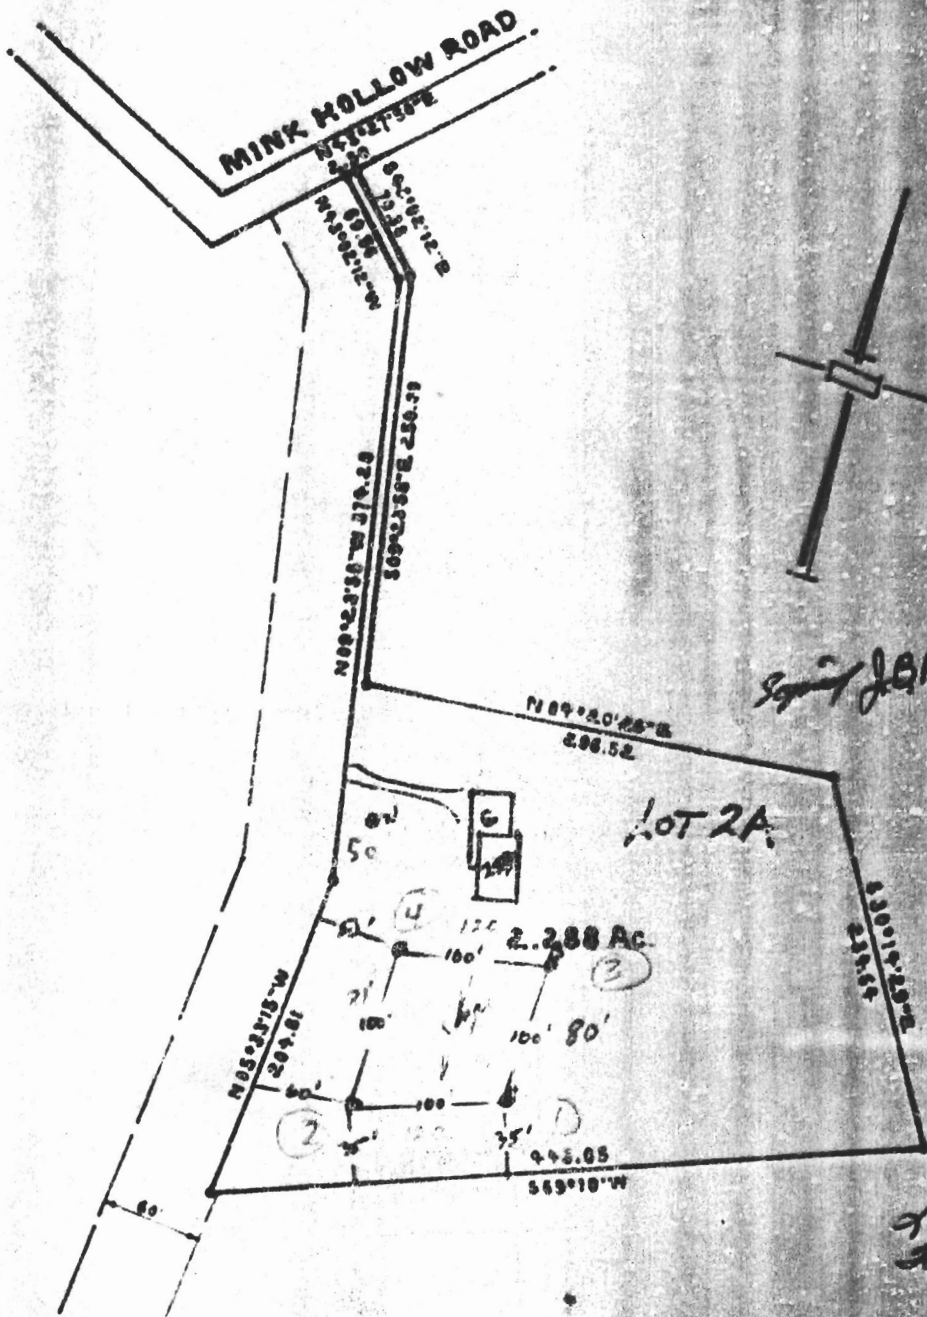

Hollowell
Kennedy
Wright
et al, partners
 678
 581 774
 1974 965