

LAYOUT _____ INSP 4 _____
INSP 2 _____ INSP 5 _____
INSP 3 _____ INSP 6 _____

ISSUE DATE: 2/20/75
APPROVAL DATE: _____

PERMIT
VOIDED

P 516890-A
A _____

**ON-SITE SEWAGE DISPOSAL SYSTEM
HOWARD COUNTY HEALTH DEPARTMENT
BUREAU OF ENVIRONMENTAL HEALTH**

05-372429

IS PERMITTED TO INSTALL ALTER

ADDRESS: _____ PHONE NUMBER: _____

SUBDIVISION: _____ LOT NUMBER: 5

ADDRESS: 7017 Mink Hollow Road PROPERTY OWNER: Marie Lindung

SEPTIC TANK CAPACITY (GALLONS): _____ OUTLET BAFFLE FILTER REQUIRED

PUMP CHAMBER CAPACITY (GALLONS): _____ COMPARTMENTED TANK REQUIRED

NUMBER OF BEDROOMS: _____

SQUARE FEET PER BEDROOM: _____

LINEAR FEET OF TRENCH REQUIRED: _____

TRENCHES:	Trench to be _____ feet wide. Inlet _____ feet below original grade. Bottom maximum depth _____ feet below original grade. Effective area begins at _____ feet below original grade. _____ feet of stone below distribution pipe.
LOCATION:	
NOTES:	

PLANS APPROVED: _____ DATE: 4/3/02

- NOTE: PERMIT VOID AFTER 2 YEARS
- NOTE: CONTRACTOR RESPONSIBLE FOR SCHEDULING A PRE-CONSTRUCTION INSPECTION FOR ALL INSTALLATIONS
- NOTE: WATERTIGHT SEPTIC TANKS REQUIRED
- NOTE: ALL PARTS OF SEPTIC SYSTEM SHALL BE 100 FEET FROM ANY WATER WELL
- NOTE: MANHOLE RISERS REQUIRED ON ALL SEPTIC TANKS AND PUMP CHAMBERS UNLESS SPECIFICALLY AUTHORIZED

**NEITHER THE HOWARD COUNTY COUNCIL NOR THE HEALTH DEPARTMENT IS
RESPONSIBLE FOR THE SUCCESSFUL OPERATION OF ANY SYSTEM
PERMITTEE RESPONSIBLE FOR OBTAINING FINAL APPROVAL ON THIS PERMIT
CALL 410-313-2640 FOR INSPECTION OF SEPTIC SYSTEM**

516890-A

P516890A

5/14/75
after 1 PM

PERMIT

SEWAGE DISPOSAL SYSTEM

MARYLAND STATE DEPARTMENT OF HEALTH

HOWARD COUNTY

ELLICOTT CITY

DISTRICT 3B

DATE 5/20/75

INDEXED

Jack F. York
State C. Wilson

IS PERMITTED TO INSTALL ALTER

ADDRESS 14907 Gilpin Road, Silver Spring, Md. 20906

PHONE 771-8000

SEWAGE DISPOSAL SYSTEM LOCATED AT

SUBDIVISION

ROAD

King Hollow Road

LOT Parcel 2-A

PROPERTY OWNER

Kimberly Wilson

ADDRESS

same as above

SPECIFICATIONS

4 bedrooms

DRAIN FIELD _____ DEPTH _____ FEET, BOTTOM AREA _____ SQ. FT.

SEEPAGE PITS _____ ABSORBENT SIDE-WALL AREA _____ SQ. FT.

SEPTIC TANK CAPACITY 1690 GALLONS

FOR GARBAGE GRINDER, INCREASE DISPOSAL AREA 25% & TANK CAPACITY 50%

A Location
5/20/75
JWS

NOTE: DRY WELL(S) - 180 sq. ft. effective absorption area per bedroom. The first 3 ft. of the absorption ground is considered unusable. Minimum depth of dry well to be 11 ft. Locate dry well(s) approximately 100 ft. from the edge of the property line and 145 ft. from the 149.75 ft. property line. If a trench is to be used in lieu of one dry well, call this office for permission and recommendations.

NOTE: ALL PIPE FROM HOUSE TO DISPOSAL AREA MUST BE CAST IRON.

NOTE: PERMIT VOID AFTER THREE YEARS.

NOTE: INSTALL STAND PIPE TO SEPTIC TANK AND DRY WELL. STAND PIPES MUST BE 6 INCHES IN DIAMETER. CAST IRON, CONCRETE OR TERRAZO COVER ACCEPTED.

PLANS APPROVED BY

William W. York

DATE

11/13/74

FILL SEPTIC TANK AND DISTRIBUTION BOX WITH WATER BEFORE CALLING FOR AN INSPECTION. COVER NO WORK UNTIL INSPECTED AND APPROVED.


NEITHER THE HOWARD COUNTY COMMISSIONERS NOR THE HEALTH DEPARTMENT IS RESPONSIBLE FOR THE SUCCESSFUL OPERATION OF ANY SYSTEM.

OLIVE PERMITS SECTION
AND RETURNED 5/25/75

BOO 135167
ENCLOSED AREA

A 20131

A516890-A

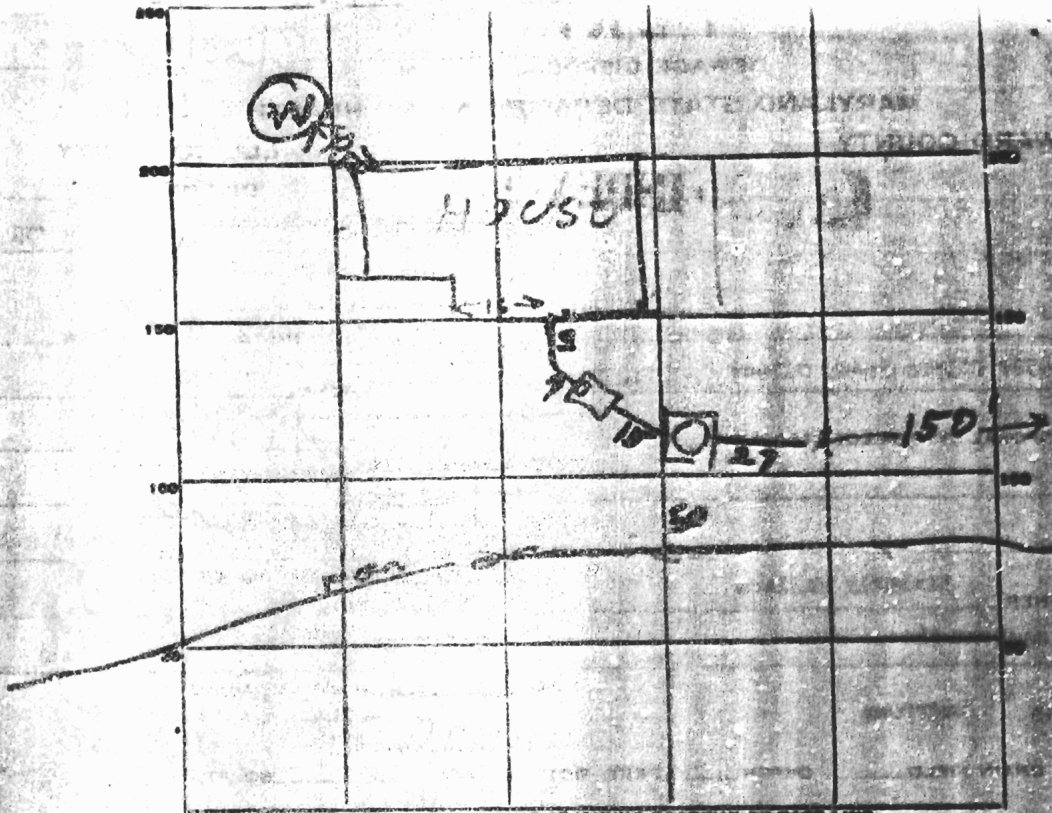

INDICATE NORTH - NAME ADJACENT ROADWAY AS BASE LINE.

PERMIT CARD _____
 SEPTIC TANK, LEVEL OK 1250 CONCRETE CLEANOUTS OR WELLS RINGS

DISTRIBUTION BOX, LEVEL _____

TRENCH DEPTH 11 FT. TRENCH WIDTH 2 FT.

GRAVEL DEPTH 8 FT IN. TOTAL LENGTH 216 FT.

NUMBER OF TRENCHES 1 TOTAL COVERED AREA ONSITE

SEEPAGE PITS, INSIDE DIAMETER _____ FT. DEPTH BELOW GLEET 7 FT.

ABSORBENT AREA _____ SQ. FT.

REMARKS 5/14/75 DRYWELL INLET 4 FT
BELOW GROUND PERIMETER IS 4 FT
INLET TO DITCH IS 3 FT DEEP

DATE SYSTEM APPROVED 5/14/75 INSPECTOR Raymond Hodges