

PUB. SEWER STATUS VERIFIED BY \_\_\_\_\_

ISSUE DATE: \_\_\_\_\_

# PERMIT

P 516464

APPROVAL DATE: 11/8/04

A REPAIR

## ON-SITE SEWAGE DISPOSAL SYSTEM HOWARD COUNTY HEALTH DEPARTMENT BUREAU OF ENVIRONMENTAL HEALTH

03-279804

Fogles Septic Clean, Inc IS PERMITTED TO INSTALL  ALTER

ADDRESS: 580 Obrecht Road PHONE NUMBER: 410-795-5670

SUBDIVISION: Indian Hills LOT NUMBER: 39

ADDRESS: ~~12531~~ 12351 Howard Lodge Drive PROPERTY OWNER: HARRY BALLANTINE

SEPTIC TANK CAPACITY (GALLONS): \_\_\_\_\_

PUMP CHAMBER CAPACITY (GALLONS): \_\_\_\_\_

NUMBER OF BEDROOMS: \_\_\_\_\_

SQUARE FEET PER BEDROOM: \_\_\_\_\_

LINEAR FEET OF TRENCH REQUIRED: \_\_\_\_\_

TRENCHES:	Trench to be _____ feet wide. Inlet _____ feet below original grade. Bottom maximum depth _____ feet below original grade. Effective area begins at _____ feet below original grade. _____ feet of stone below distribution pipe.
LOCATION:	
PURPOSE:	Existing septic system has failed. Call for inspection when ground is opened so sanitarian can recommend repair.


PLANS APPROVED: \_\_\_\_\_ DATE: \_\_\_\_\_

- NOTE: PERMIT VOID AFTER 2 YEARS
- NOTE: CONTRACTOR RESPONSIBLE FOR SCHEDULING A PRE-CONSTRUCTION INSPECTION FOR ALL INSTALLATIONS
- NOTE: WATERTIGHT SEPTIC TANKS REQUIRED
- NOTE: ALL PARTS OF SEPTIC SYSTEM SHALL BE 100 FEET FROM ANY WATER WELL
- NOTE: MANHOLE RISERS REQUIRED ON ALL SEPTIC TANKS AND PUMP CHAMBERS

**NEITHER THE HOWARD COUNTY COUNCIL OR THE HEALTH DEPARTMENT IS RESPONSIBLE FOR THE SUCCESSFUL OPERATION OF ANY SYSTEM PERMITTEE RESPONSIBLE FOR OBTAINING FINAL APPROVAL ON THIS PERMIT CALL 410-313-2640 FOR INSPECTION OF SEPTIC SYSTEM**

P 516464

NOT TO SCALE

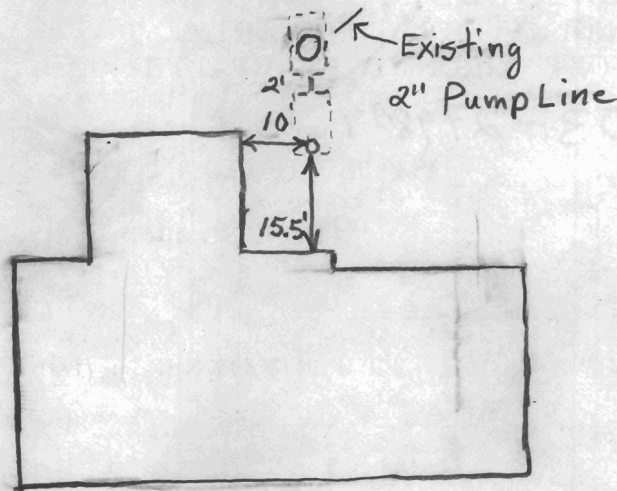

**TRENCH/DRAINFIELD DATA**  
 WIDTH                  INLET                  BOTTOM

NUMBER OF TRENCHES \_\_\_\_\_  
 TOTAL LENGTH \_\_\_\_\_  
 ABSORPTION AREA \_\_\_\_\_  
 DISTRIBUTION BOX LEVEL \_\_\_\_\_  
 DISTRIBUTION BOX BAFFLE \_\_\_\_\_  
 DISTRIBUTION BOX PORT \_\_\_\_\_

**SEPTIC TANK DATA**

SEPTIC TANK 1 LEVEL \_\_\_\_\_  
 CAPACITY Existing GAL  
 SEAM LOC Midseam  
 TANK LID DEPTH 6'  
 BAFFLES Rear Oak  
 BAFFLE FILTER No  
 MANHOLE LOC None  
 6" PORT LOC Front  
 WATERTIGHT TEST No  
 SEPTIC TANK 2 LEVEL ✓  
 CAPACITY 1000 GAL  
 SEAM LOC Top  
 TANK LID DEPTH 5'  
 BAFFLES Ice  
 BAFFLE FILTER No  
 MANHOLE LOC Middle  
 6" PORT LOC None  
 WATERTIGHT TEST No

Howard Lodge Drive

ROAD

2-Lids

PRE-CONSTRUCTION \_\_\_\_\_

INSTALLATION 11/8/04 Pump chamber replaced. Had installer put second lid on tank because tank is about 5' below grade. Pump to be installed. Could not get any info. on existing system, computers not working. Don't know where well is, probably buried pit well somewhere. (BB)

FINAL INSPECTOR B. Baker

DATE OF APPROVAL 11/8/04