

# APPLICATION

SEWAGE DISPOSAL TESTING

A 35667

STATE OF MARYLAND - DEPARTMENT OF HEALTH AND MENTAL HYGIENE

P \_\_\_\_\_

HOWARD COUNTY HEALTH DEPARTMENT  
ENVIRONMENTAL HEALTH SERVICES

P. O. BOX 476 ELLICOTT CITY, MARYLAND 21043  
TELEPHONE: 992-2330

DISTRICT \_\_\_\_\_

DATE 6/18/85

TO: THE COUNTY HEALTH OFFICER  
ELLICOTT CITY, MARYLAND

I, HEREBY, APPLY FOR THE NECESSARY TEST IN ORDER TO CONSTRUCT (OR RECONSTRUCT) A SEWAGE DISPOSAL SYSTEM.

PROPERTY OWNER CARMAN Associates

ADDRESS Box 122, ELLICOTT City Md PHONE 301-854-0498

PROPERTY LOCATION: see I Area B

SUBDIVISION Dayton Meadows LOT NO. NINE (9)

ROAD AND DESCRIPTION 4904 Green Bridge Rd, Dayton, Md

SIZE OF LOT 3 AC + TYPE BLDG. Three  
(NUMBER OF BEDROOMS)

THE SYSTEM INSTALLED UNDER THIS APPLICATION IS ACCEPTABLE ONLY UNTIL PUBLIC FACILITIES BECOME AVAILABLE. I FULLY UNDERSTAND THE FEE CONNECTED WITH THE FILING OF THIS PERC TEST APPLICATION IS NON-REFUNDABLE UNDER ANY CIRCUMSTANCES. I ALSO AGREE TO COMPLY WITH ALL M.O.S.H.A. REQUIREMENTS IN TESTING THIS LOT.

Philip Mangit  
(SIGNATURE OF APPLICANT)

APPROVED BY \_\_\_\_\_ FOR \_\_\_\_\_ DATE \_\_\_\_\_


REJECTED BY \_\_\_\_\_ FOR \_\_\_\_\_ DATE \_\_\_\_\_

HOLD PENDING FURTHER TESTS \_\_\_\_\_ DATE \_\_\_\_\_

REASONS FOR REJECTION OR HOLDING 7-15-85 Perc. Results SATISFACTORY, hold for Certified Subdivision  
PLAT 5 Abel. BLDG. PERMIT SIGNED AND RETURNED 6-18-85

# THIS IS NOT A PERMIT



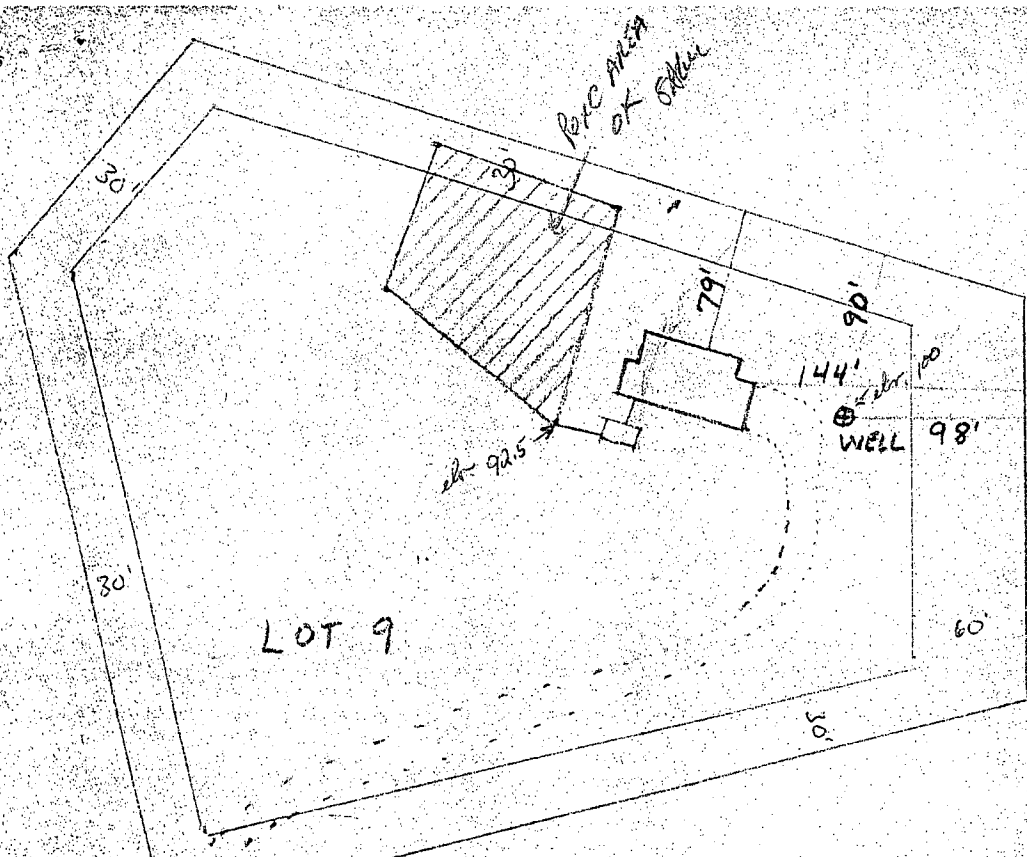

#  
B.P. 70915  
NICKEL

- Elevation of well 100' ✓
- Elevation of grade at house 97'5" ✓
- Elevation of 1st floor 99'5" ✓
- Elevation of perc hole 1 92'5" ✓
- Invert out of house 90'8" ✓
- Invert into tank 90'3" ✓
- Invert out of tank 90'0" ✓
- Invert into distribution box perc hole 1 89'5" ✓
- Grade at house where invert leaves house 94'0"

I certify the above relative elevations are true and correct for this property.

*Daniel Ostericher*  
 Daniel Ostericher  
 627-1789

4 BR HOUSE 3-9  
 158 Φ/BR

NEED (1) 106 FT TRENCH

GREEN BRIDGE RD.