

LAYOUT ~~12/17/2002~~ 1/14/03 INSP 4 3:30 PM *Didn't make*
 INSP 2 12-23-02 10-11 AM INSP 5 1/15/03 2 PM
 INSP 3 1-13-03 11 AM INSP 6 1/16/03 10 AM

ISSUE DATE: 11/25/02
 APPROVAL DATE: 1/6/03

**PERMIT
INDEXED**

P 518009
 A 516462

**ON-SITE SEWAGE DISPOSAL SYSTEM
 HOWARD COUNTY HEALTH DEPARTMENT
 BUREAU OF ENVIRONMENTAL HEALTH
 03-282503**

Fogles Septic Clean, Inc IS PERMITTED TO INSTALL ALTER

ADDRESS: 580 Obrecht Road, Sykesville PHONE NUMBER: 410-795-5670

SUBDIVISION: _____ LOT NUMBER: _____

ADDRESS: 12260 Howard Lodge Road PROPERTY OWNER: Robert Woodward

SEPTIC TANK CAPACITY (GALLONS): 1250 OUTLET BAFFLE FILTER REQUIRED

PUMP CHAMBER CAPACITY (GALLONS): N/A COMPARTMENTED TANK REQUIRED

NUMBER OF BEDROOMS: 4

SQUARE FEET PER BEDROOM: 210

LINEAR FEET OF TRENCH REQUIRED: 280 HOUSE SERVED BY PUBLIC WATER

TRENCHES:	Trench to be 3.0 feet wide. Inlet 2.5 feet below original grade. Bottom maximum depth 4.5 feet below original grade. Effective area begins at 2.5 feet below original grade. 2.0 feet of stone below distribution pipe.
LOCATION:	Start the first trench 220 feet from front lot line and 135 feet from the leftside line as seen facing the lot from Howard Lodge Road.
NOTES:	


PLANS APPROVED: Frank Skinner BK MR DATE: 9/10/2002

NOTES: PERMIT VOID AFTER 2 YEARS
 CONTRACTOR IS RESPONSIBLE FOR SCHEDULING A PRE-CONSTRUCTION INSPECTION FOR ALL INSTALLATIONS
 WATERTIGHT SEPTIC TANKS REQUIRED
 ALL PARTS OF SEPTIC SYSTEM SHALL BE 100 FEET FROM ANY WATER WELL UNLESS SPECIFICALLY AUTHORIZED
 MANHOLE RISERS REQUIRED ON ALL SEPTIC TANKS AND PUMP CHAMBERS UNLESS SPECIFICALLY AUTHORIZED
 CONTRACTOR RESPONSIBLE FOR COMPLIANCE WITH APPLICABLE REGULATIONS, GUIDELINES AND THE TERMS OF THIS PERMIT

**NEITHER THE HOWARD COUNTY COUNCIL NOR THE HEALTH DEPARTMENT IS
 RESPONSIBLE FOR THE SUCCESSFUL OPERATION OF ANY SYSTEM
 PERMITTEE RESPONSIBLE FOR OBTAINING FINAL APPROVAL ON THIS PERMIT
 ALL 410-313-2640 FOR INSPECTION OF SEPTIC SYSTEM**

A510462

NOT TO SCALE

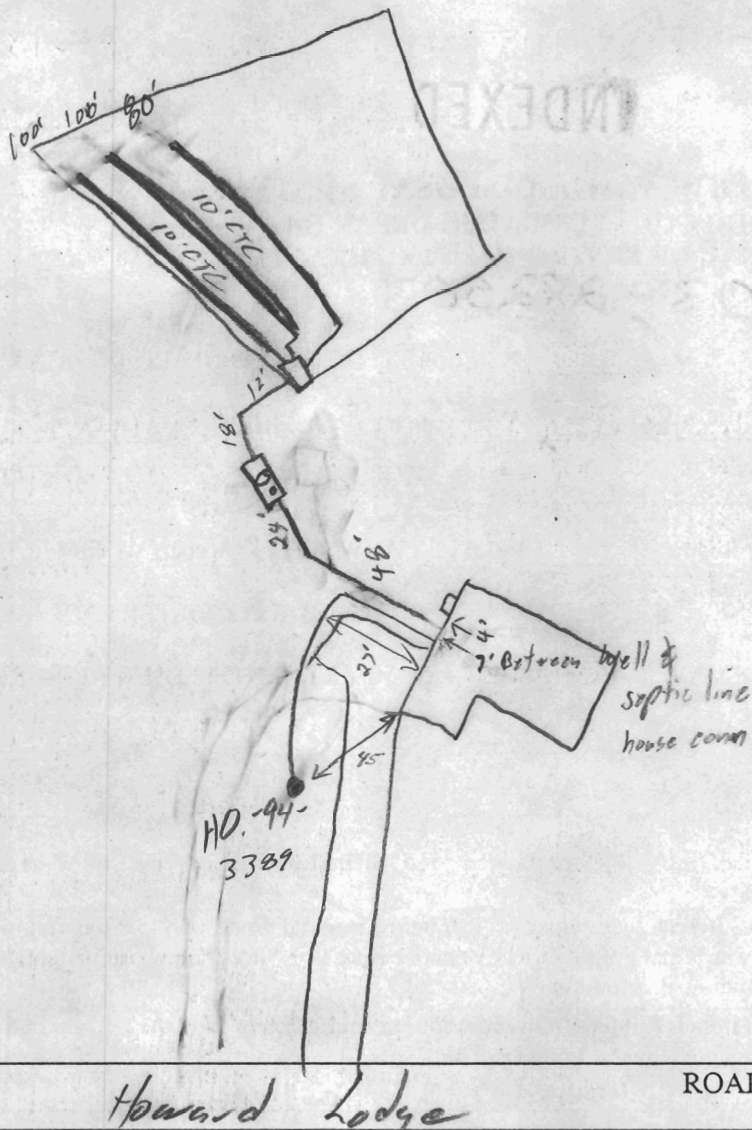

TRENCH/DRAINFIELD DATA		
WIDTH	INLET	BOTTOM
<u>3</u>	<u>2.5</u>	<u>4.5</u>
NUMBER OF TRENCHES		<u>3</u>
TOTAL LENGTH		<u>280'</u>
ABSORPTION AREA		<u>840 sq'</u>
DISTRIBUTION BOX LEVEL		<input checked="" type="checkbox"/>
DISTRIBUTION BOX BAFFLE		<input checked="" type="checkbox"/>
DISTRIBUTION BOX PORT		<input type="checkbox"/>

SEPTIC TANK DATA	
SEPTIC TANK 1 LEVEL	<input checked="" type="checkbox"/>
CAPACITY	<u>1650</u> GAL
SEAM LOC	<u>Top</u>
TANK LID DEPTH	<u>1'</u>
BAFFLES	<input checked="" type="checkbox"/>
BAFFLE FILTER	<input checked="" type="checkbox"/>
MANHOLE LOC	<u>Center</u>
6" PORT LOC	<u>Front</u>
WATERTIGHT TEST	<input type="checkbox"/>
SEPTIC TANK 2 LEVEL	<input type="checkbox"/>
CAPACITY	<u> </u> GAL
SEAM LOC	<u> </u>
TANK LID DEPTH	<u> </u>
BAFFLES	<input checked="" type="checkbox"/>
BAFFLE FILTER	<input checked="" type="checkbox"/>
MANHOLE LOC	<u> </u>
6" PORT LOC	<u> </u>
WATERTIGHT TEST	<input type="checkbox"/>


PRE CONSTRUCTION 12/23/02 No one here. Called contractor (SD)

1/13/03 Lot staked, contours off a small amount. Install (2) 100' & (1) 80'

INSTALLATION trench, 10' CTC (SD) 1/15/03 OK to cover all work,


needs house connection (SD) 1/16/03 House conn completed (SD)

FINAL INSPECTOR [Signature] DATE OF APPROVAL 1/16/03

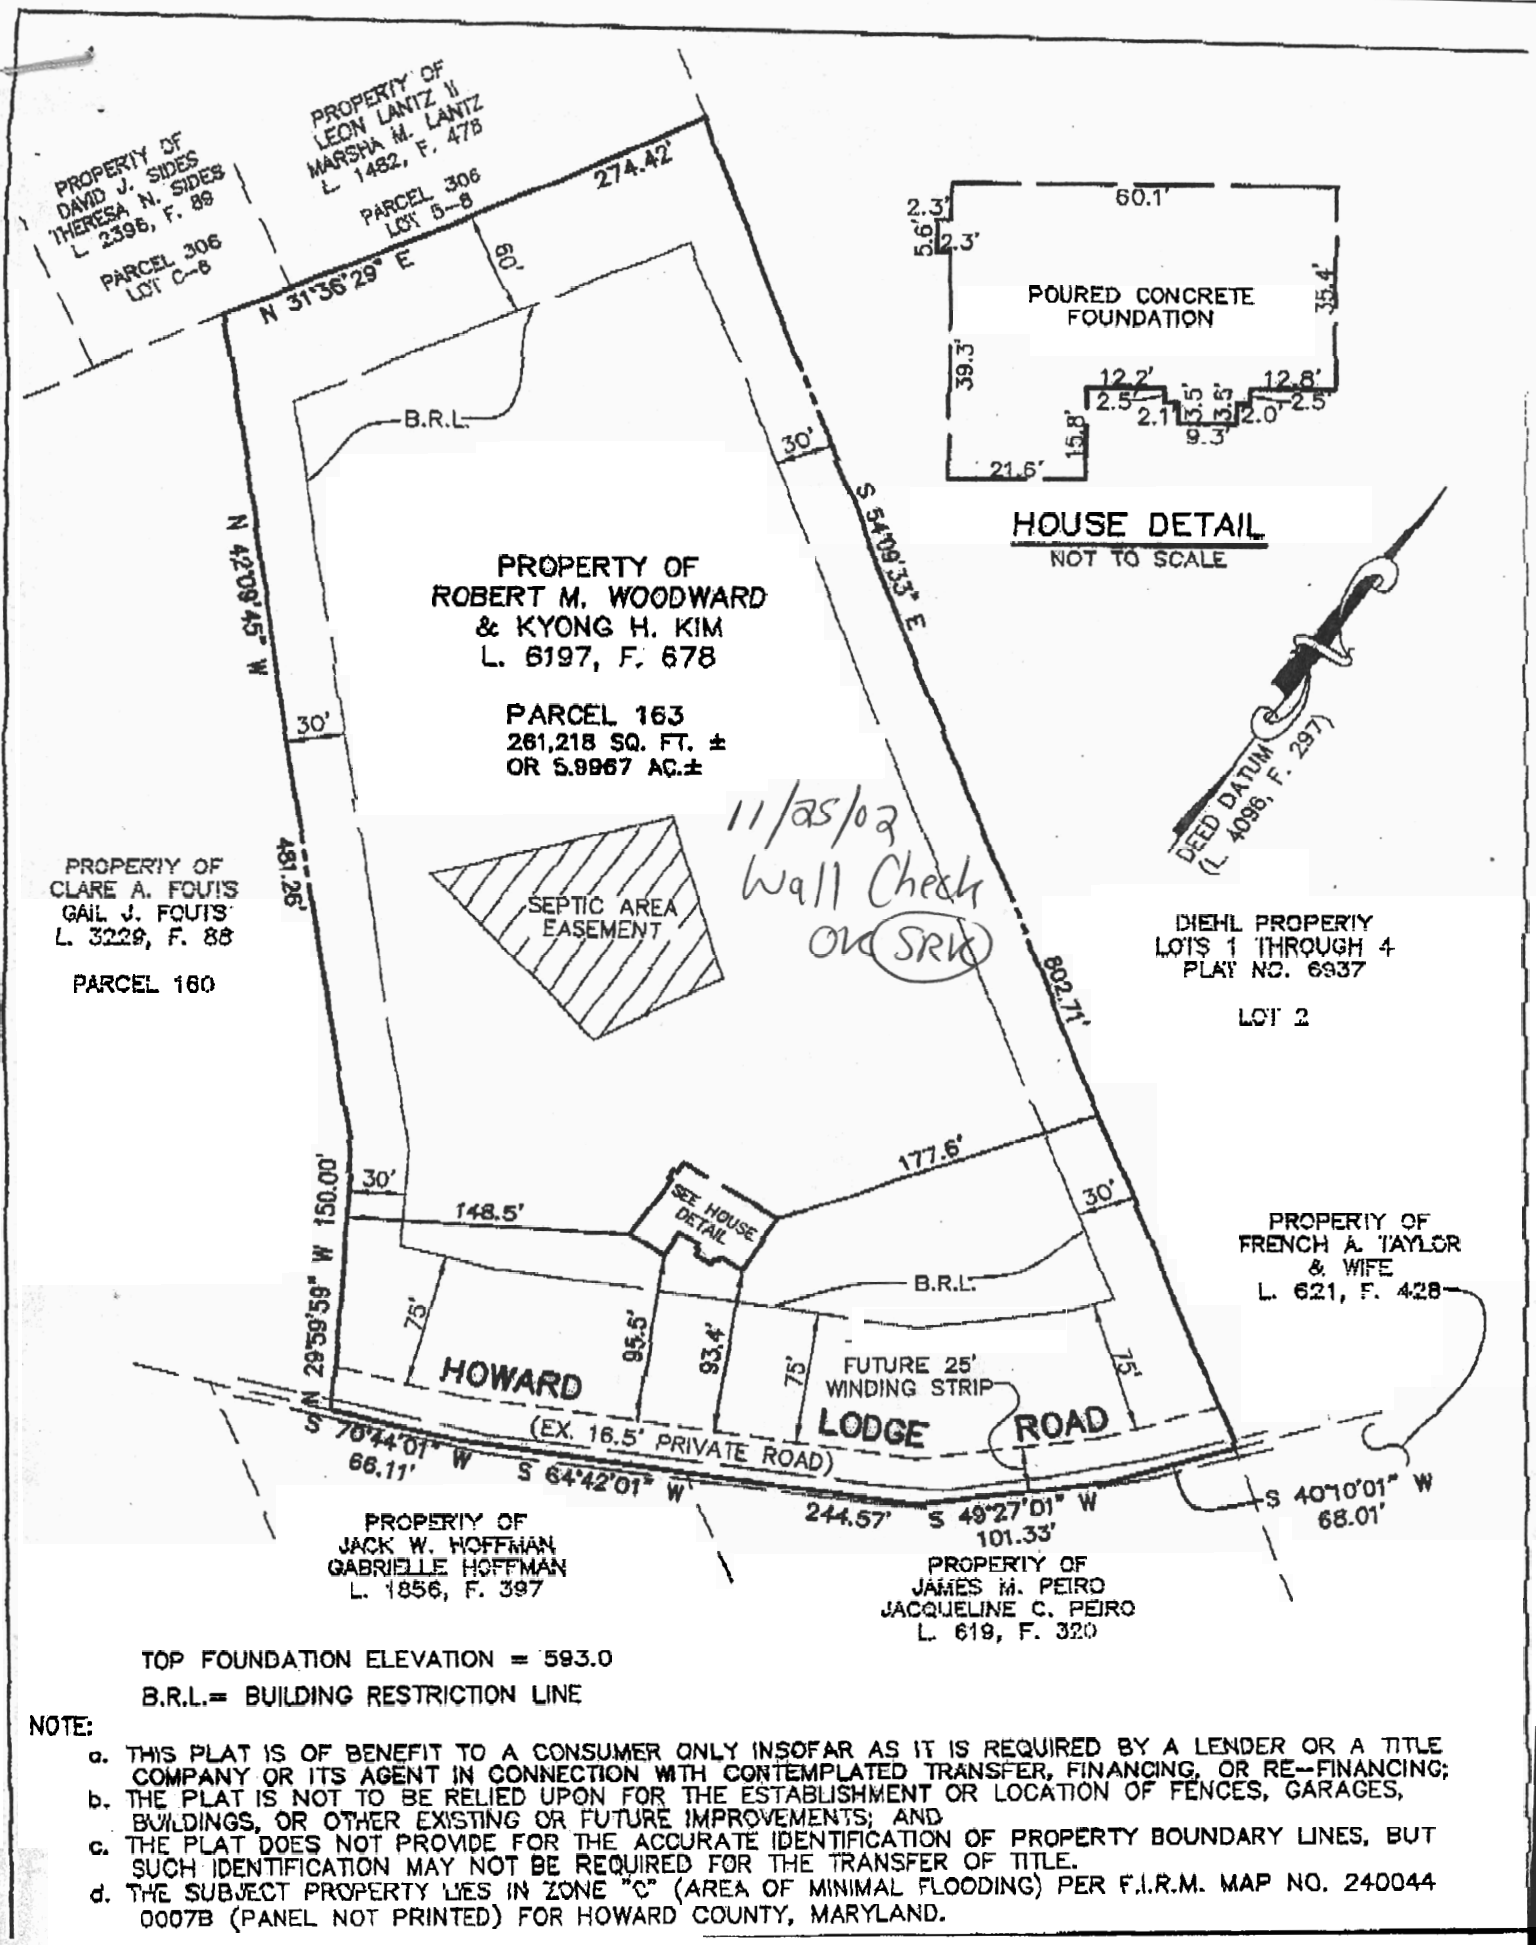


PROPERTY OF
**ROBERT M. WOODWARD
 & KYONG H. KIM**
 L. 6197, F. 678


PARCEL 163
 261,218 SQ. FT. ±
 OR 5.9967 AC.±

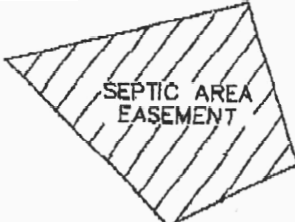

*11/25/02
 Wall Check
 on SR10*

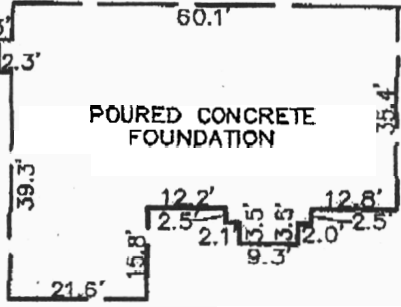

HOUSE DETAIL
 NOT TO SCALE

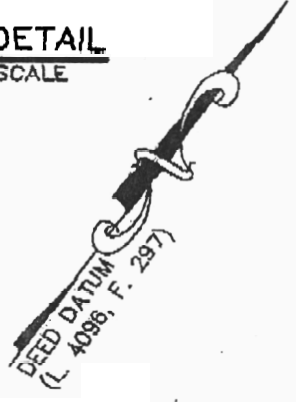

DIEHL PROPERTY
 LOTS 1 THROUGH 4
 PLAT NO. 6937

LOT 2

PROPERTY OF
**FRENCH A. TAYLOR
 & WIFE**
 L. 621, F. 428

PROPERTY OF
**JACK W. HOFFMAN
 GABRIELLE HOFFMAN**
 L. 1856, F. 397


PROPERTY OF
**JAMES M. PEIRO
 JACQUELINE C. PEIRO**
 L. 619, F. 320

TOP FOUNDATION ELEVATION = 593.0
 B.R.L. = BUILDING RESTRICTION LINE


NOTE:

- a. THIS PLAT IS OF BENEFIT TO A CONSUMER ONLY INsofar AS IT IS REQUIRED BY A LENDER OR A TITLE COMPANY OR ITS AGENT IN CONNECTION WITH CONTEMPLATED TRANSFER, FINANCING, OR RE-FINANCING;
- b. THE PLAT IS NOT TO BE RELIED UPON FOR THE ESTABLISHMENT OR LOCATION OF FENCES, GARAGES, BUILDINGS, OR OTHER EXISTING OR FUTURE IMPROVEMENTS; AND
- c. THE PLAT DOES NOT PROVIDE FOR THE ACCURATE IDENTIFICATION OF PROPERTY BOUNDARY LINES, BUT SUCH IDENTIFICATION MAY NOT BE REQUIRED FOR THE TRANSFER OF TITLE.
- d. THE SUBJECT PROPERTY LIES IN ZONE "C" (AREA OF MINIMAL FLOODING) PER F.I.R.M. MAP NO. 240044 0007B (PANEL NOT PRINTED) FOR HOWARD COUNTY, MARYLAND.


L 4096 F. 297

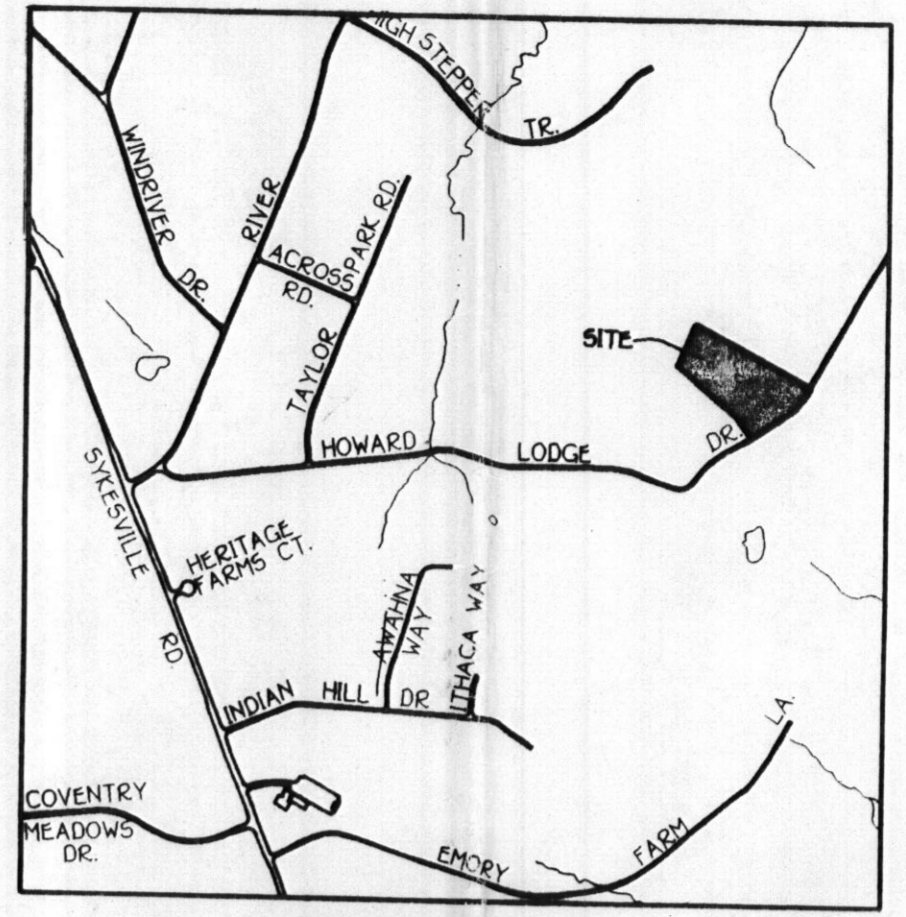

VICINITY MAP
SCALE: 1" = 1200'

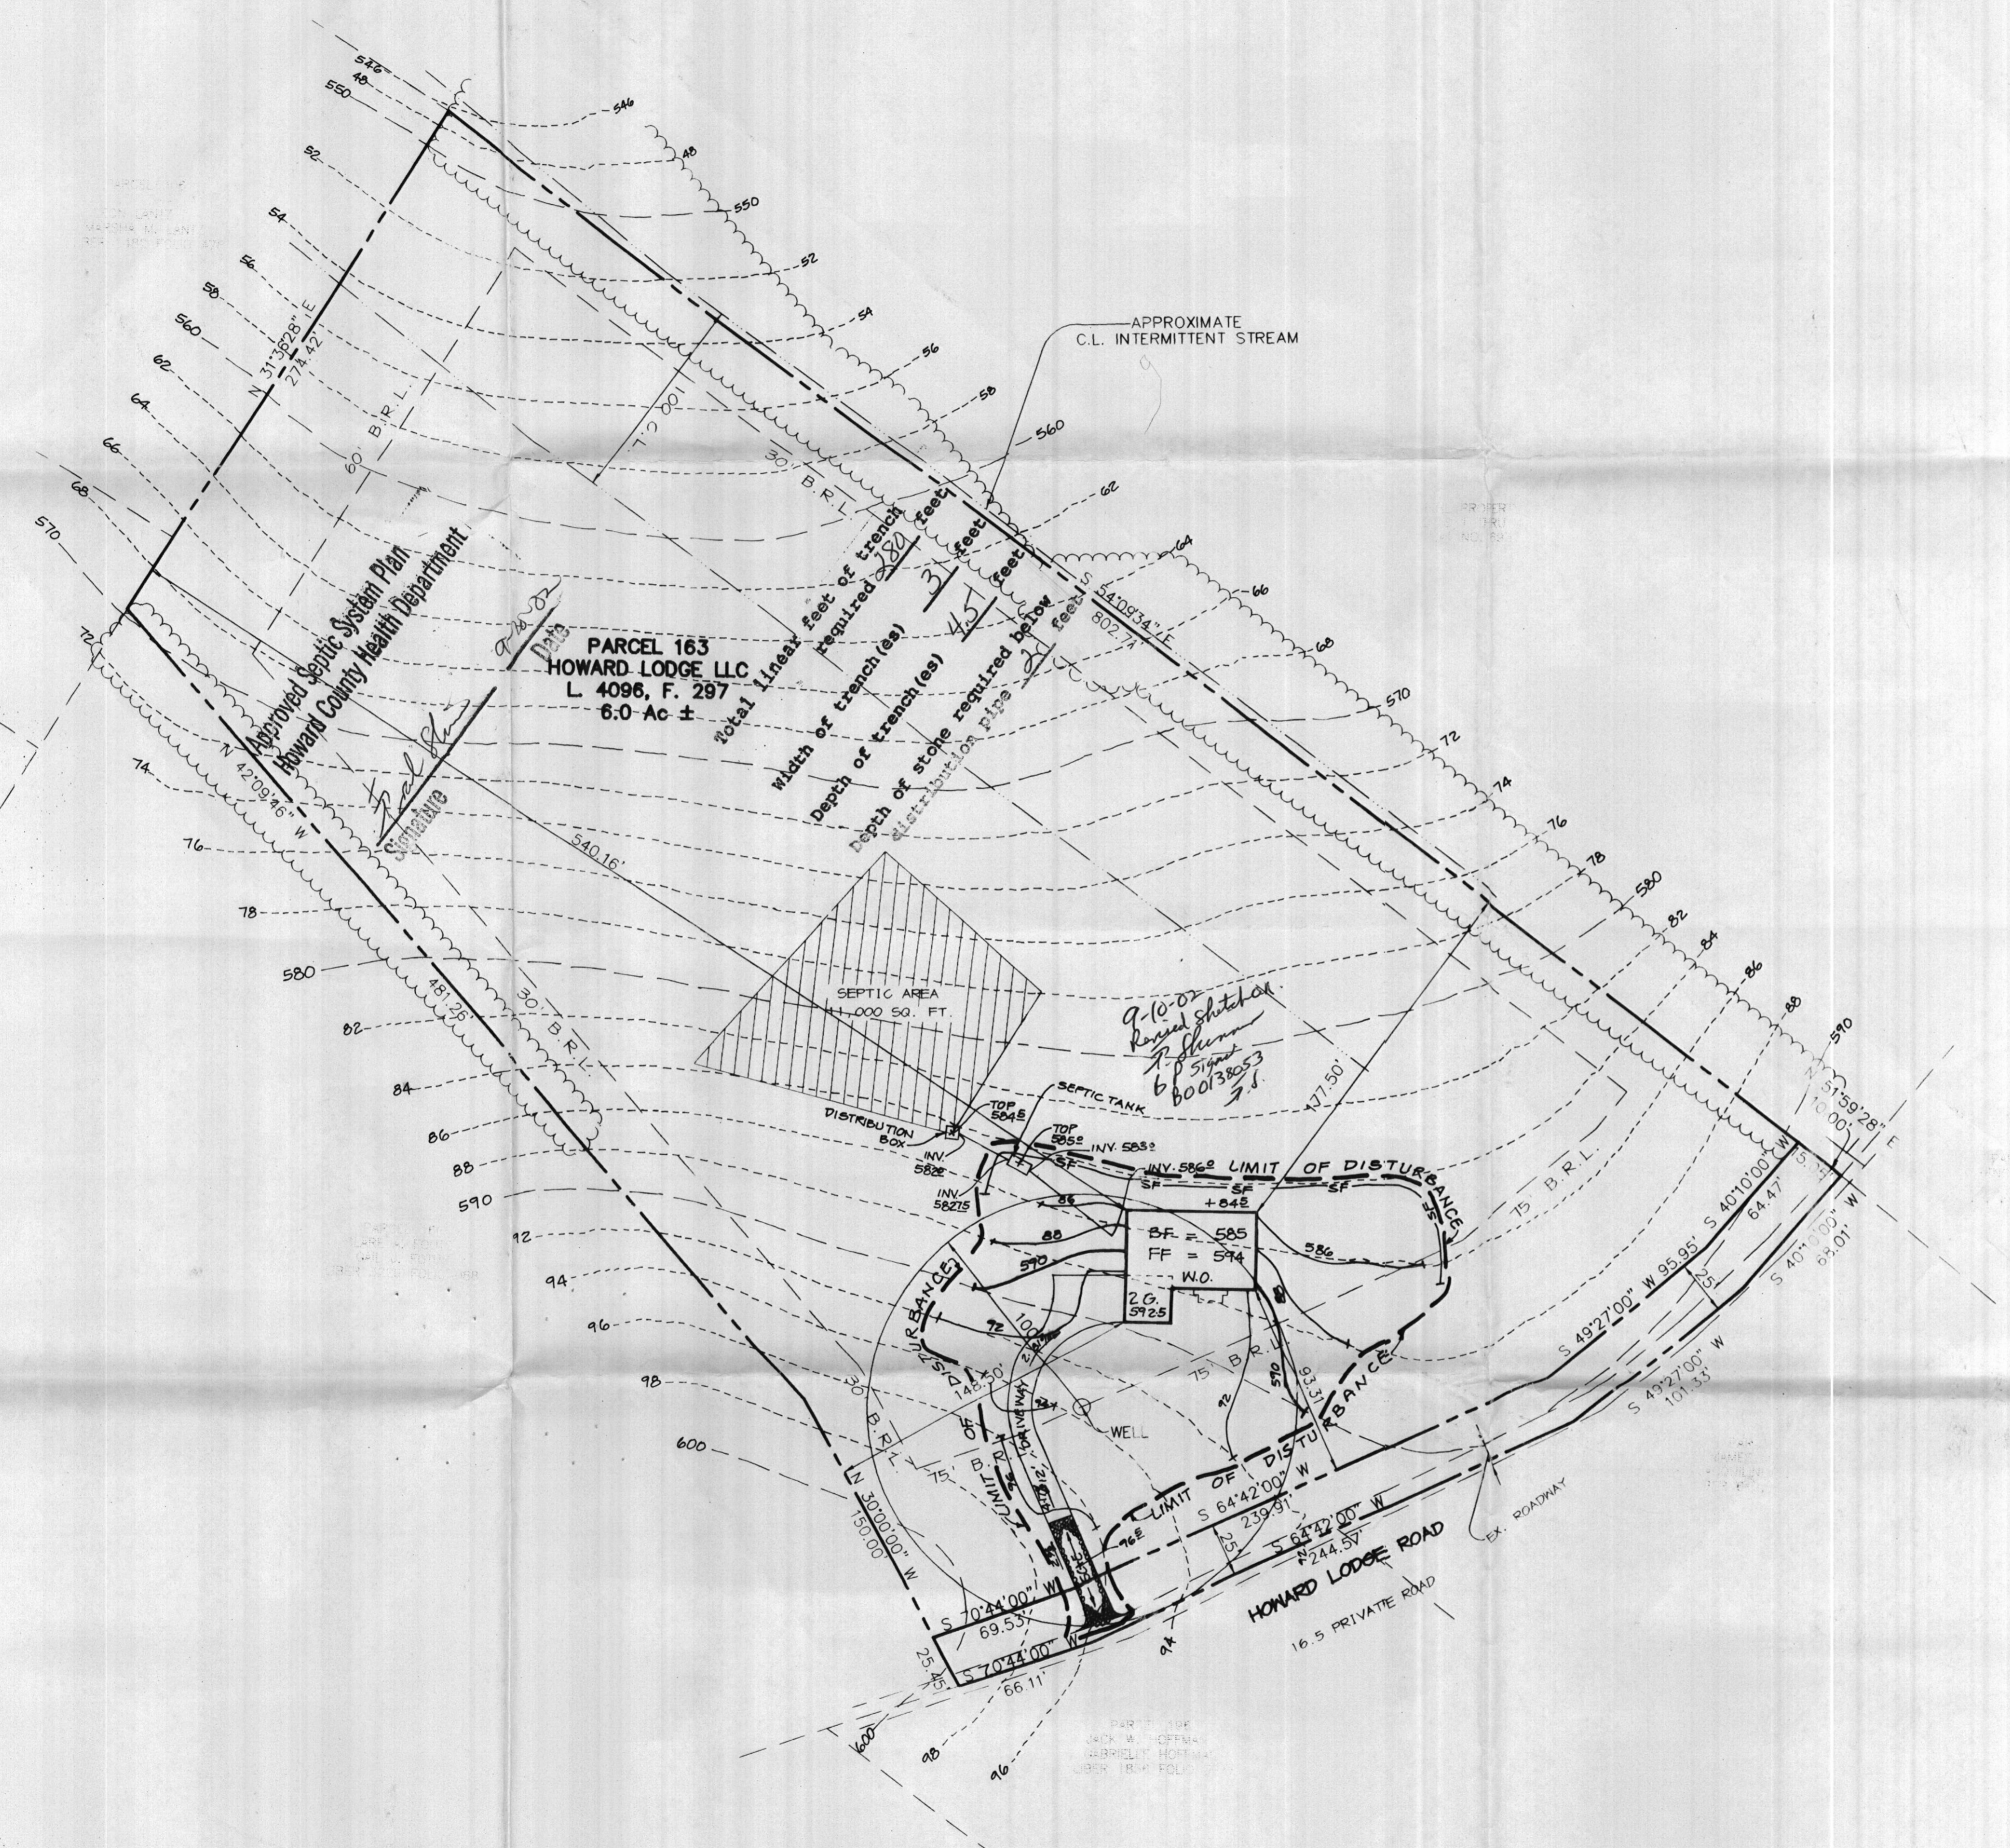

3" ASPHALT
4" CR-6
DRIVEWAY SECTION
NOT TO SCALE

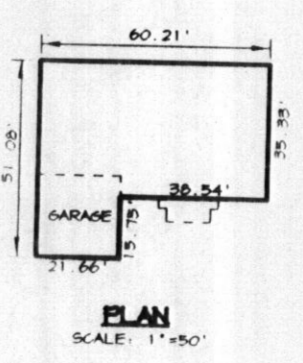

BY THE DEVELOPER :
I/WE CERTIFY THAT ALL DEVELOPMENT AND CONSTRUCTION WILL BE DONE ACCORDING TO THIS PLAN, AND THAT ANY RESPONSIBLE PERSONNEL INVOLVED IN THE CONSTRUCTION PROJECT WILL HAVE A CERTIFICATE OF ATTENDANCE AT A DEPARTMENT OF THE ENVIRONMENT APPROVED TRAINING PROGRAM FOR THE CONTROL OF SEDIMENT AND EROSION BEFORE BEGINNING THE PROJECT. I ALSO AUTHORIZE PERIODIC ON-SITE INSPECTIONS BY THE HOWARD SOIL CONSERVATION DISTRICT.

DEVELOPER _____ DATE _____

BY THE ENGINEER :
I CERTIFY THAT THIS PLAN FOR EROSION AND SEDIMENT CONTROL REPRESENTS A PRACTICAL AND WORKABLE PLAN BASED ON MY PERSONAL KNOWLEDGE OF THE SITE CONDITIONS AND THAT IT WAS PREPARED IN ACCORDANCE WITH THE REQUIREMENTS OF THE HOWARD SOIL CONSERVATION DISTRICT.

Chris Reid 8.19.02
ENGINEER _____ DATE _____

THESE PLANS HAVE BEEN REVIEWED FOR THE HOWARD SOIL CONSERVATION DISTRICT AND MEET THE TECHNICAL REQUIREMENTS FOR SOIL EROSION AND SEDIMENT CONTROL.

NATURAL RESOURCES CONSERVATION SERVICE _____ DATE _____

THIS DEVELOPMENT PLAN IS APPROVED FOR SOIL EROSION AND SEDIMENT CONTROL BY THE HOWARD SOIL CONSERVATION DISTRICT.

HOWARD SOIL CONSERVATION DISTRICT _____ DATE _____

APPROVED : HOWARD COUNTY DEPARTMENT OF PLANNING AND ZONING.

CHIEF, DIVISION OF LAND DEVELOPMENT _____ DATE _____

CHIEF, DEVELOPMENT ENGINEERING DIVISION _____ DATE _____

DATE NO. _____ REVISION _____

OWNER / DEVELOPER
MR & MRS. RUSS CONKLIN
11 SEMINOLE AVENUE
BALTIMORE, MARYLAND 21220-5638


PROJECT
HOWARD LODGE LLC
PARCEL 163

AREA
TAX MAP NO. 9 PARCEL 163
3RD ELECTION DISTRICT
HOWARD COUNTY, MARYLAND

TITLE
PLOT PLAN

Patton Harris Rust & Associates, p.c.
Engineers, Surveyors, Planners, Landscape Architects.
8818 Centre Park Drive
Columbia, MD 21045
T 410.997.8900
F 410.997.9282

8-19-02
DATE
DESIGNED BY : C.J.R.
DRAWN BY : J.V.A.
PROJECT NO : 11591-1-0
DATE : AUGUST 13, 2002
SCALE : 1" = 50'
DRAWING NO. 1 OF 2

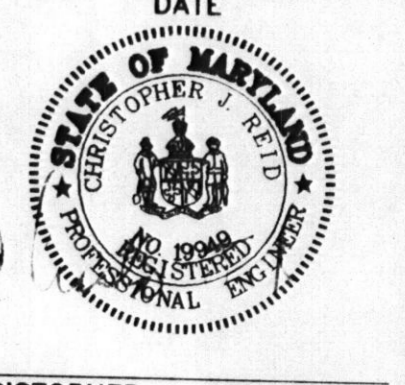

CHRISTOPHER J. REID #19949