

516458-A

PERMIT

SEWAGE DISPOSAL SYSTEM

MARYLAND STATE DEPARTMENT OF HEALTH

HOWARD COUNTY

ELLICOTT CITY

DISTRICT 9th

DATE 7/23/73

INDEXED
RE-INDEXED

1104/02 05-364817

Jack Fyock

IS PERMITTED TO INSTALL OF ALTER

ADDRESS Two Oaks Road, Glenwag, Maryland

PHONE 286-8939

A SEWAGE DISPOSAL SYSTEM LOCATED AT _____

SUBDIVISION _____ ROAD 5337 Broadwater Lane LOT Parcel 14

PROPERTY OWNER Mr. & Mrs. G. Alice Sallied Coy Morris

ADDRESS 5786 Stevens Forest Road, Columbia, Md.

SPECIFICATIONS 3 bedrooms

DRAIN FIELD _____ DEPTH _____ FEET. BOTTOM AREA _____ SQ. FT.

SEEPAGE PITS _____ ABSORBENT SIDE-WALL AREA _____ SQ. FT.

SEPTIC TANK CAPACITY 1500 GALLONS

FOR GARBAGE GRINDER, INCREASE DISPOSAL AREA 25% & TANK CAPACITY 50%.

OTHER DRY WELL - 500 sq. ft. absorbent sidewall area to begin below the first 24 in. of non-potable soil. Minimum depth permitted for dry well is 11 ft. Locate dry well 150 ft. from front property line and 160 ft. from right side line as soon from right-of-way.

NOTE: ALL PIPE FROM HOUSE TO DRY WELL MUST BE CAST IRON.
PERMIT VOID AFTER THREE YEARS.

NOTE: INSTALL STAND PIPE ON SEPTIC TANK AND DRY WELL.

PLANS APPROVED BY Robert V. Torre

DATE 9/19/72

FILL SEPTIC TANK AND DISTRIBUTION BOX WITH WATER BEFORE CALLING FOR AN INSPECTION. COVER NO WORK UNTIL INSPECTED AND APPROVED.

NEITHER THE HOWARD COUNTY COMMISSIONERS NOR THE HEALTH DEPARTMENT IS RESPONSIBLE FOR THE SUCCESSFUL OPERATION OF ANY SYSTEM.

LOG. PERMIT SIGNED AND RETURNED 1-02-02


BOD 133548
1,000 GAL. PROPANE TANK

LOG. PERMIT SIGNED AND RETURNED 12/6/72

Unit # 57918
P. Ben

17419

516458-A

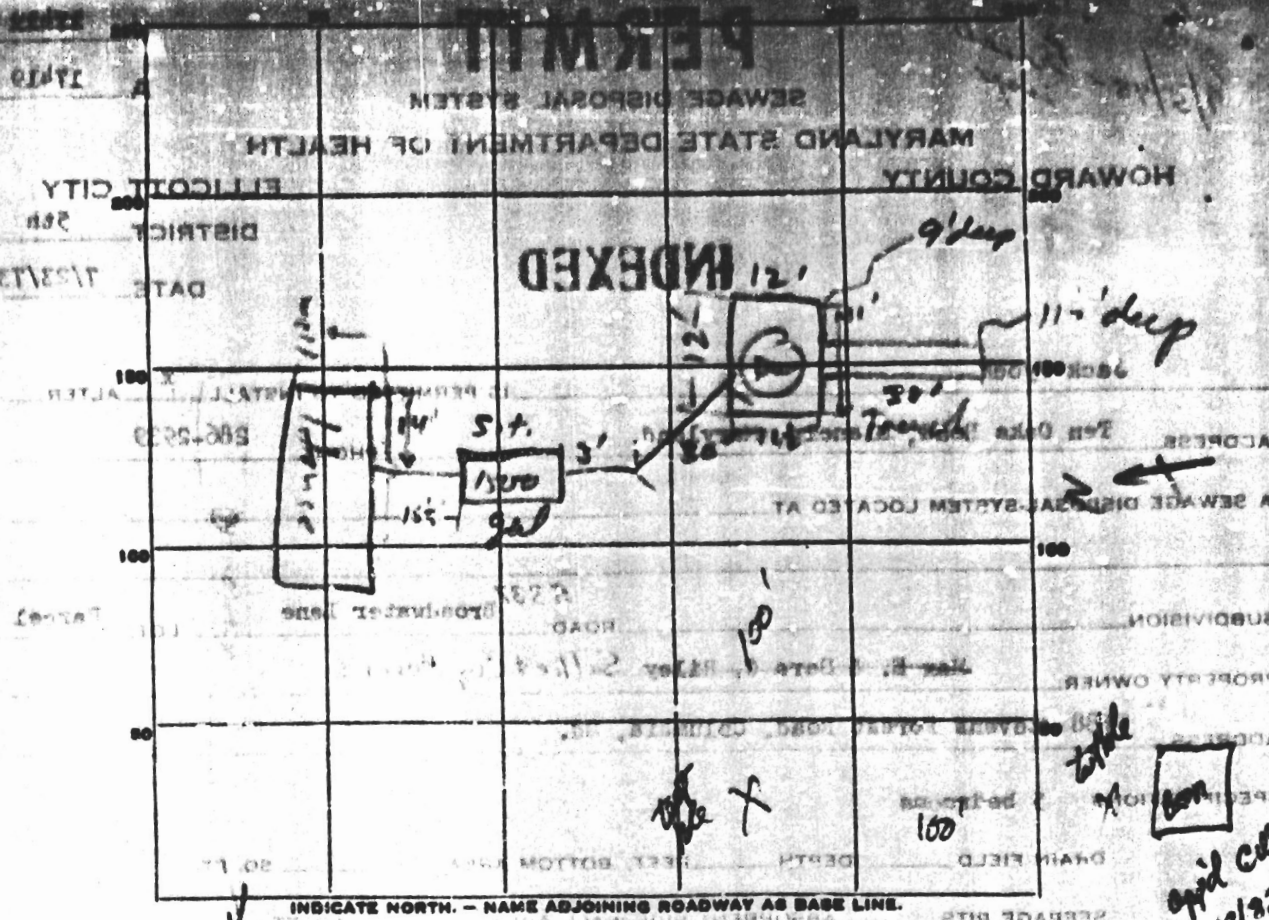

PERMIT CARD A-17419
P-18776

SEPTIC TANK, LEVEL CLEANOUTS

~~OTHER~~
~~TILE FIELD, DEPTH~~ ~~FT.~~ ~~TRENCH WIDTH~~ ~~FT.~~

Trench GRAVEL DEPTH 10 IN. TOTAL LENGTH 38 FT.

NUMBER OF TRENCHES 1 TOTAL BOTTOM AREA

SEEPLAGE PITS, INSIDE DIAMETER 4 1/2 FT. DEPTH BELOW INLET 9 FT.

ABSORBENT AREA 784.5 SQ. FT.

REMARKS Place for trench just in white ground

- Question: is it ok for pipe from well to cross sewage pipe?

DATE SYSTEM APPROVED 9/5/73 INSPECTOR R. Moreland

