

WELL COMPLETION REPORT

DATE WELL COMPLETED: 8-17-73

DEPTH OF WELL: 300

NO. NEAREST FOOT: 300

DRILLER IDENTIFICATION NO.: 42

OWNER: Kelly, Tracy

STREET OR RFD: [Blank]

POST OFFICE: [Blank]

WELL LOG

STATE THE KIND OF FORMATION PENETRATED, THEIR COLOR, DEPTH, THICKNESS AND IF WATER BEARING

DESCRIPTION OF FORMATION	FEET		WATER BEARING
	FROM	TO	
Top soil	0	2	
Sandy	2	14	
Medial	14	300	✓

8-17-73

20' case

18' open

5' log case

etc. DM

GROUTING RECORD

WELL HAS BEEN GROUTED (CIRCLE APPROPRIATE BOX)

TYPE OF GROUTING MATERIAL (CIRCLE ONE)

CEMENT GY
 GYTONITE CLAY GC

NO. OF BAGS: 5 NO. OF POUNDS: 500

GALLONS OF WATER: 30

DEPTH OF GROUT SEAL (NO. NEAREST FOOT):

FROM 0 TO 10

CASING RECORD

CASING TYPES (CIRCLE ONE)

INERT (APPROXIMATE CODE BELOW)

STEEL ST CONCRETE CO

PLASTIC PL OTHER OT

MAIN CASING TYPE: ST NOMINAL DIAMETER (NEAREST INCH): 6 TOTAL DEPTH OF MAIN CASING (NEAREST FOOT): 21

OTHER CASING (IF USED)

DIAMETER (INCH)	DEPTH (FEET) FROM	TO

SCREEN RECORD

SCREEN TYPE (CIRCLE ONE)

INERT (APPROXIMATE CODE BELOW)

STEEL ST BRASS OR MONEL BR

PLASTIC PL OTHER OT

DEPTH (NEAREST WHOLE FOOT)

DEPTH	DEPTH	DEPTH	DEPTH	DEPTH	DEPTH
1	2	3	4	5	6
7	8	9	10	11	12
13	14	15	16	17	18
19	20	21	22	23	24
25	26	27	28	29	30
31	32	33	34	35	36
37	38	39	40	41	42
43	44	45	46	47	48
49	50	51	52	53	54
55	56	57	58	59	60

SLOT SIZE 1. 2. 3.

DIAMETER OF SCREEN (NEAREST INCH): FROM 1 TO 2

GRAVEL PACK: FROM 1 TO 2

IF WELL DRILLED WAS A FLOWING WELL (CIRCLE BOX) F

DRILLER'S NAME: [Signature]

(PLEASE PRINT) [Signature]

SIGNATURE: [Signature]

PUMPING TEST

HOURS PUMPED (TO NEAREST HOUR): 2

PUMPING RATE (GALLONS PER MINUTE TO NEAREST GALLON): 1

METHOD USED TO MEASURE PUMPING RATE: [Handwritten]

WATER LEVEL (DISTANCE FROM LAND SURFACE) BEFORE PUMPING: 40

WATER LEVEL (DISTANCE FROM LAND SURFACE) WHEN PUMPING: 300

TYPE OF PUMPER USED (CIRCLE APPROPRIATE ONE FOR PUMPING TEST)

AIR A PISTON P TURBINE T

CENTRIFUGAL C ROTARY R OTHER (DESCRIBE BELOW) O

JET J SUBMERSIBLE S

PUMP INSTALLED

TYPE OF PUMP (WRITE APPROPRIATE LETTER IN BOX - SEE ABOVE: A, C, J, P, R, S, T, O)

DRILLER WILL INSTALL PUMP (CIRCLE APPROPRIATE BOX) Y

CAPACITY: GALLONS PER MINUTE (TO NEAREST GALLON): 31


PUMP HORSE POWER: 37

PUMP ELEVATION (NEAREST FOOT): 43

CASING HEIGHT (CIRCLE APPROPRIATE BOX AND ENTER CASING HEIGHT)

ABOVE + BELOW -

LAND SURFACE (NEAREST FOOT): 2

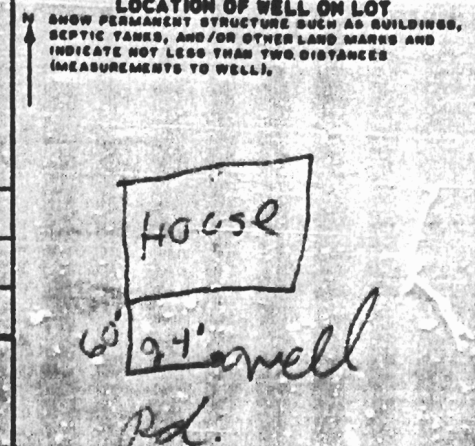

CIRCLE APPROPRIATE BOXES

A WELL WAS ABANDONED AND SEALED WHEN THIS WELL WAS COMPLETED

E ELECTRIC LOG OBTAINED

P TEST WELL CONVERTED TO PRODUCTION WELL

I HEREBY CERTIFY THAT I HAVE COMPLIED WITH ALL CONDITIONS STATED ON THE ABOVE-CAPTIONED "PERMIT TO DRILL WELL", AND THAT INFORMATION CONTAINED IN THIS REPORT IS TRUE, ACCURATE, AND COMPLETE TO THE BEST OF MY KNOWLEDGE, INFORMATION AND BELIEF.