

PUB. SEWER STATUS VERIFIED BY \_\_\_\_\_

ISSUE DATE: 8/23/1973

APPROVAL DATE: \_\_\_\_\_

# PERMIT INDEXED

P 516469-E

A REPAIR

## ON-SITE SEWAGE DISPOSAL SYSTEM HOWARD COUNTY HEALTH DEPARTMENT BUREAU OF ENVIRONMENTAL HEALTH

**65-352231**

\_\_\_\_\_ IS PERMITTED TO    INSTALL     ALTER

ADDRESS: \_\_\_\_\_    PHONE NUMBER: \_\_\_\_\_

SUBDIVISION: Linden Chapel Hills    LOT NUMBER: 6 Block C

ADDRESS: 4966 Morning Star Drive    PROPERTY OWNER: Parker

SEPTIC TANK CAPACITY (GALLONS): \_\_\_\_\_

PUMP CHAMBER CAPACITY (GALLONS): \_\_\_\_\_

NUMBER OF BEDROOMS: \_\_\_\_\_

SQUARE FEET PER BEDROOM: \_\_\_\_\_

LINEAR FEET OF TRENCH REQUIRED: \_\_\_\_\_

TRENCHES:	Trench to be _____ feet wide. Inlet _____ feet below original grade. Bottom maximum depth _____ feet below original grade. Effective area begins at _____ feet below original grade. _____ feet of stone below distribution pipe.
LOCATION:	_____
PURPOSE:	_____

PLANS APPROVED: \_\_\_\_\_    DATE: \_\_\_\_\_

NOTE: PERMIT VOID AFTER 2 YEARS

NOTE: CONTRACTOR RESPONSIBLE FOR SCHEDULING A PRE-CONSTRUCTION INSPECTION FOR ALL INSTALLATIONS

NOTE: WATERTIGHT SEPTIC TANKS REQUIRED

NOTE: ALL PARTS OF SEPTIC SYSTEM SHALL BE 100 FEET FROM ANY WATER WELL

NOTE: MANHOLE RISERS REQUIRED ON ALL SEPTIC TANKS AND PUMP CHAMBERS

**NEITHER THE HOWARD COUNTY COUNCIL NOR THE HEALTH DEPARTMENT IS RESPONSIBLE FOR THE SUCCESSFUL OPERATION OF ANY SYSTEM PERMITTEE RESPONSIBLE FOR OBTAINING FINAL APPROVAL ON THIS PERMIT CALL 410-313-2640 FOR INSPECTION OF SEPTIC SYSTEM**

P 516469-E

9/13/73 on 9/14/73  
Randy

# PERMIT

SEWAGE DISPOSAL SYSTEM

MARYLAND STATE DEPARTMENT OF HEALTH

HOWARD COUNTY

ELLICOTT CITY

DISTRICT 1

DATE 8/23/73

## INDEXED

9A C-2  
2088  
A-15748

Under SEWER IS PERMITTED TO INSTALL X ALTER

ADDRESS 13104 Sky Way, Ellicott City, Md. PHONE 521-8432

A SEWAGE DISPOSAL SYSTEM LOCATED AT \_\_\_\_\_

SUBDIVISION Linden Chapel Hills ROAD Morning Star Drive LOT 6, Blk. C,

PROPERTY OWNER Frank P. Wilson et al Parker Sec. 2

ADDRESS \_\_\_\_\_

SPECIFICATIONS - 3 bedrooms

DRAIN FIELD \_\_\_\_\_ DEPTH \_\_\_\_\_ FEET. BOTTOM AREA \_\_\_\_\_ SQ. FT.

SEEPAGE PITS \_\_\_\_\_ ABSORBENT SIDE-WALL AREA \_\_\_\_\_ SQ. FT.

SEPTIC TANK CAPACITY 1,000 GALLONS

FOR GARBAGE GRINDER, INCREASE DISPOSAL AREA 25% & TANK CAPACITY 50%.

OTHER Dry well - 100 sq. ft. absorbent sidewall area per bedroom to begin below the first 4 ft. of original grade. Max. depth permitted for dry well is 11 ft. below original grade. Place dry well 25 ft. from front lot line and 75 ft. from left side line as seen when facing from Morningstar Drive.

NOTE: ALL PIPE FROM HOUSE TO DRY WELL MUST BE CAST IRON.

PERMIT VOID AFTER THREE YEARS.


NOTE: INSTALL STAND PIPE ON SEPTIC TANK AND DRY WELL.

PLANS APPROVED BY D. W. Morahan DATE 7/27/73

CALL ALL SEPTIC TANK AND DISTRIBUTION BOX WITH WATER BEFORE CALLING FOR AN INSPECTION. COVER NO WORK UNTIL INSPECTED AND APPROVED.

NEITHER THE HOWARD COUNTY COMMISSIONERS NOR THE HEALTH DEPARTMENT IS RESPONSIBLE FOR THE SUCCESSFUL OPERATION OF ANY SYSTEM.

A 15748

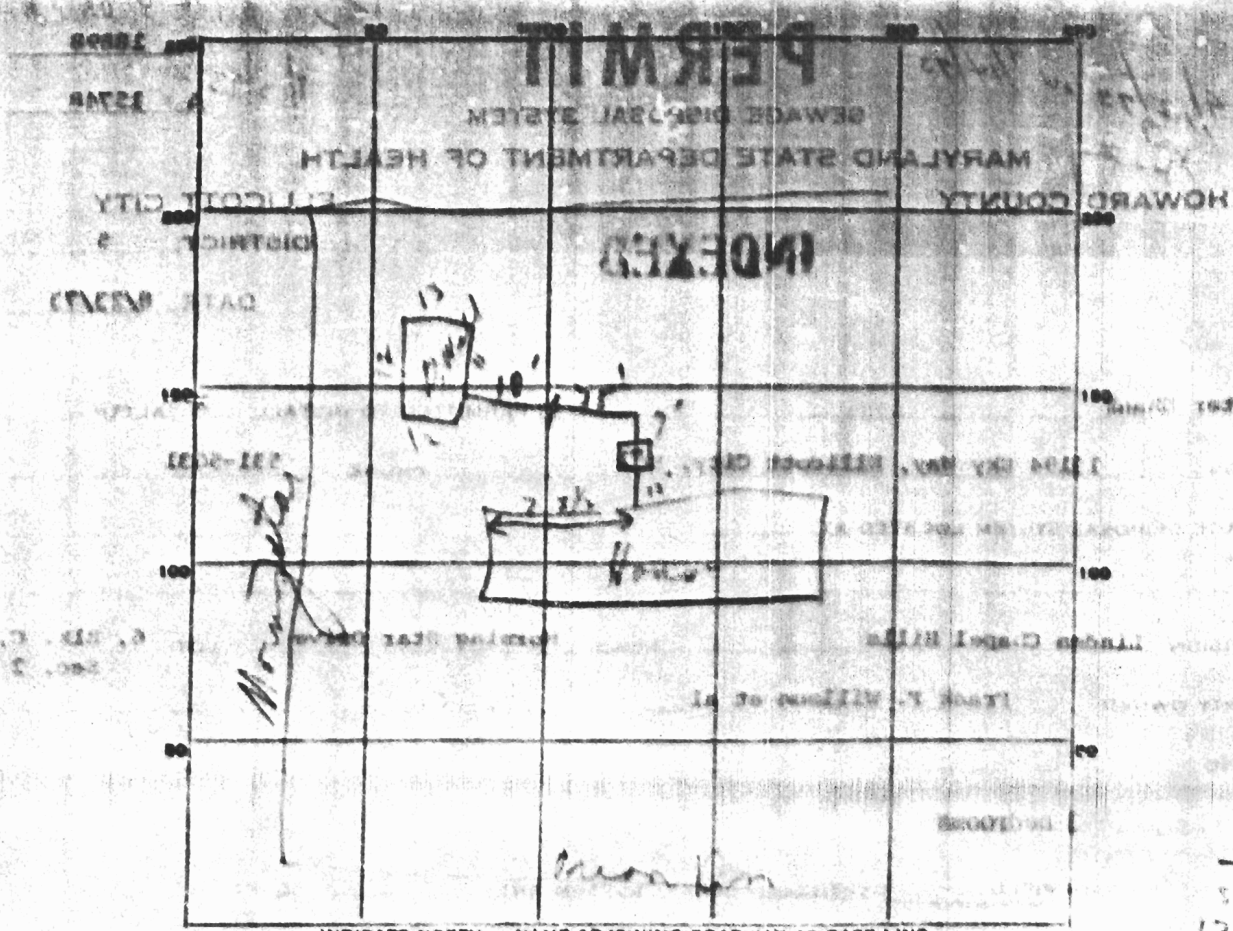

INDICATE NORTH - NAME ADJOINING ROADWAY AS BASE LINE.

47  
 12  
 4  
 8

PERMIT CARD Yes ST DW  
 SEPTIC TANK LEVEL OK CLEANOUTS OK OK  
 DISTRIBUTION BOX LEVEL \_\_\_\_\_  
 TILE FIELD, DEPTH 17 FT. TRENCH WIDTH 12 FT.  
 GRAVEL DEPTH 2 IN. TOTAL LENGTH 27 FT.  
 NUMBER OF TRENCHES 1 TOTAL BOTTOM AREA \_\_\_\_\_  
 SEEPAGE PITS, INSIDE DIAMETER 48 FT. DEPTH BELOW INLET \_\_\_\_\_  
 ABSORBENT AREA 51384 SQ. FT.

REMARKS 9/13/73 2' field was ground was called!  
2nd case - good

DATE SYSTEM APPROVED 9/13/73 INSPECTOR C. Shockey