

# APPLICATION

SEWAGE DISPOSAL TESTING

MARYLAND STATE DEPARTMENT OF HEALTH

HOWARD COUNTY

ELLICOTT CITY

DISTRICT 5

DATE 1/9/71

TO: THE COUNTY HEALTH OFFICER  
ELLICOTT CITY, MARYLAND

I HEREBY APPLY FOR THE NECESSARY TESTS IN ORDER TO CONSTRUCT OR RECONSTRUCT A SEWAGE DISPOSAL SYSTEM.

PROPERTY OWNER Frank P. & Linda Willson, et al

ADDRESS Lepton, Maryland 20702

Mr. Johnson  
PHONE 924-4811

PROPERTY LOCATION 22

SUBDIVISION Linden Chapel Hills

LOT NO. 6, Blk. B, Sec. 2

ROAD AND DESCRIPTION Road "A"

OCCUPANT \_\_\_\_\_

PERSON TO CONSTRUCT SYSTEM \_\_\_\_\_

ADDRESS \_\_\_\_\_

SIZE OF LOT 40,500 sq. ft.

TYPE BLDG 3 or 4

IF NOT SINGLE RESIDENCE DESCRIBE \_\_\_\_\_

SIGNATURE OF APPLICANT /s/ Robert Johnson


APPROVED BY \_\_\_\_\_ FOR \_\_\_\_\_ DATE \_\_\_\_\_

REJECTED BY \_\_\_\_\_ FOR \_\_\_\_\_ DATE \_\_\_\_\_

HOLD PENDING FURTHER TESTS \_\_\_\_\_ DATE \_\_\_\_\_

REASONS FOR REJECTION OR HOLDING \_\_\_\_\_

**THIS IS NOT A PERMIT**

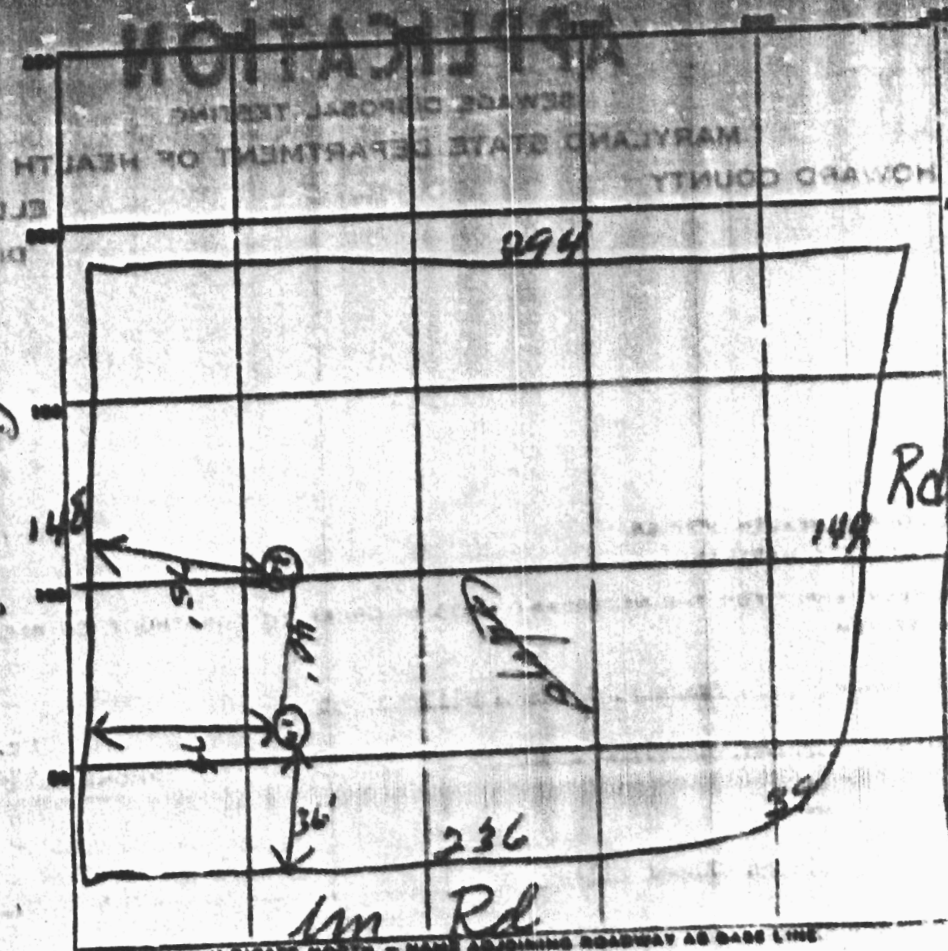

C-6

DATE	TEST NO.	DEPTH	PRE-WET		TEST - 1" DROP		TIME
			START	STOP	START	STOP	
5/23/54	1	11'	10:57	10:54	10:54	10:58	40
	2	4'	10:57	10:54	10:54	11:00	60
	3	9'	11:02	11:01	11:03	11:02	40
	4	3'	11:02	11:02	11:02	11:02	50

SOIL AUGER FINDING \_\_\_\_\_

TESTED BY *JAD* \_\_\_\_\_

REMARKS \_\_\_\_\_

THIS IS NOT A REPORT

