

LAYOUT _____ INSP 4 _____
 INSP 2 _____ INSP 5 _____
 INSP 3 _____ INSP 6 _____

ISSUE DATE: _____
 APPROVAL DATE: _____

**PERMIT
INDEXED**

P 516472-A
 A _____

**ON-SITE SEWAGE DISPOSAL SYSTEM
 HOWARD COUNTY HEALTH DEPARTMENT
 BUREAU OF ENVIRONMENTAL HEALTH**

05-348730

IS PERMITTED TO INSTALL ALTER

ADDRESS: _____ PHONE NUMBER: _____

SUBDIVISION: _____ LOT NUMBER: _____

ADDRESS: 6806 Haviland Mill Road PROPERTY OWNER: Mona Tsoukleris

SEPTIC TANK CAPACITY (GALLONS): _____ OUTLET BAFFLE FILTER REQUIRED

PUMP CHAMBER CAPACITY (GALLONS): _____ COMPARTMENTED TANK REQUIRED

BUILDING PERMIT SIGNED

NUMBER OF BEDROOMS: _____

AND RETURNED

SQUARE FEET PER BEDROOM: _____

5-12-04 B00147714-DECK

LINEAR FEET OF TRENCH REQUIRED: _____

TRENCHES:	Trench to be _____ feet wide. Inlet _____ feet below original grade. Bottom maximum depth _____ feet below original grade. Effective area begins at _____ feet below original grade. _____ feet of stone below distribution pipe.
LOCATION:	_____ ✓
NOTES:	PLAN PERMITS SIGNED 1/16/2002 B00133819 Install 500 gallon UG propane tank

PLANS APPROVED: _____ DATE: _____

- NOTE: PERMIT VOID AFTER 2 YEARS
- NOTE: CONTRACTOR RESPONSIBLE FOR SCHEDULING A PRE-CONSTRUCTION INSPECTION FOR ALL INSTALLATIONS
- NOTE: WATERTIGHT SEPTIC TANKS REQUIRED
- NOTE: ALL PARTS OF SEPTIC SYSTEM SHALL BE 100 FEET FROM ANY WATER WELL
- NOTE: MANHOLE RISERS REQUIRED ON ALL SEPTIC TANKS AND PUMP CHAMBERS UNLESS SPECIFICALLY AUTHORIZED

**NEITHER THE HOWARD COUNTY COUNCIL NOR THE HEALTH DEPARTMENT IS
 RESPONSIBLE FOR THE SUCCESSFUL OPERATION OF ANY SYSTEM
 PERMITTEE RESPONSIBLE FOR OBTAINING FINAL APPROVAL ON THIS PERMIT
 CALL 410-313-2640 FOR INSPECTION OF SEPTIC SYSTEM**

01010

Davis, Michael J

From: Georgeandmona [georgeandmona@verizon.net]
Sent: Monday, July 02, 2012 9:37 AM
To: Bricker, Robert
Cc: Davis, Michael J
Subject: Re: 2RE: waiver request

Thank you very much. We look forward to Mr. Davis' reply. Enjoy your Independence Day holiday. Hopefully with power soon.

Mona and George

On Jul 2, 2012, at 9:30 AM, "Bricker, Robert" <RBricker@howardcountymd.gov> wrote:

I have copied Mike Davis on this 'Reply'. You may use that link in your email to send your request to Mike.

Robert Bricker, REHS/R.S.
Environmental Sanitarian
Well and Septic Program

410-313-2691

From: georgeandmona [<mailto:georgeandmona@verizon.net>]
Sent: Friday, June 29, 2012 11:04 AM
To: Bricker, Robert
Subject: Re: waiver request

Mr. Bricker,


Thank you very much for your help with respect to our application and the process. I do not have the email address for Mr. Davis. Would it be possible for you to forward this to him or should I attach a PDF of our request for a waiver?
Mona

- 11750 Tria.

- call Darryl - plumb.
insp. to update on
our requirements

x1842

THE PLAT IS NOT TO BE RELIED UPON FOR THE ESTABLISHMENT OR LOCATION OF FENCES, GARAGES, BUILDINGS, OR OTHER EXISTING OR FUTURE IMPROVEMENTS; AND THE PLAT DOES NOT PROVIDE FOR THE ACCURATE IDENTIFICATION OF PROPERTY BOUNDARY LINES, BUT SUCH IDENTIFICATION MAY NOT BE REQUIRED FOR THE TRANSFER OF TITLE OR SECURING FINANCING OR RE-FINANCING.

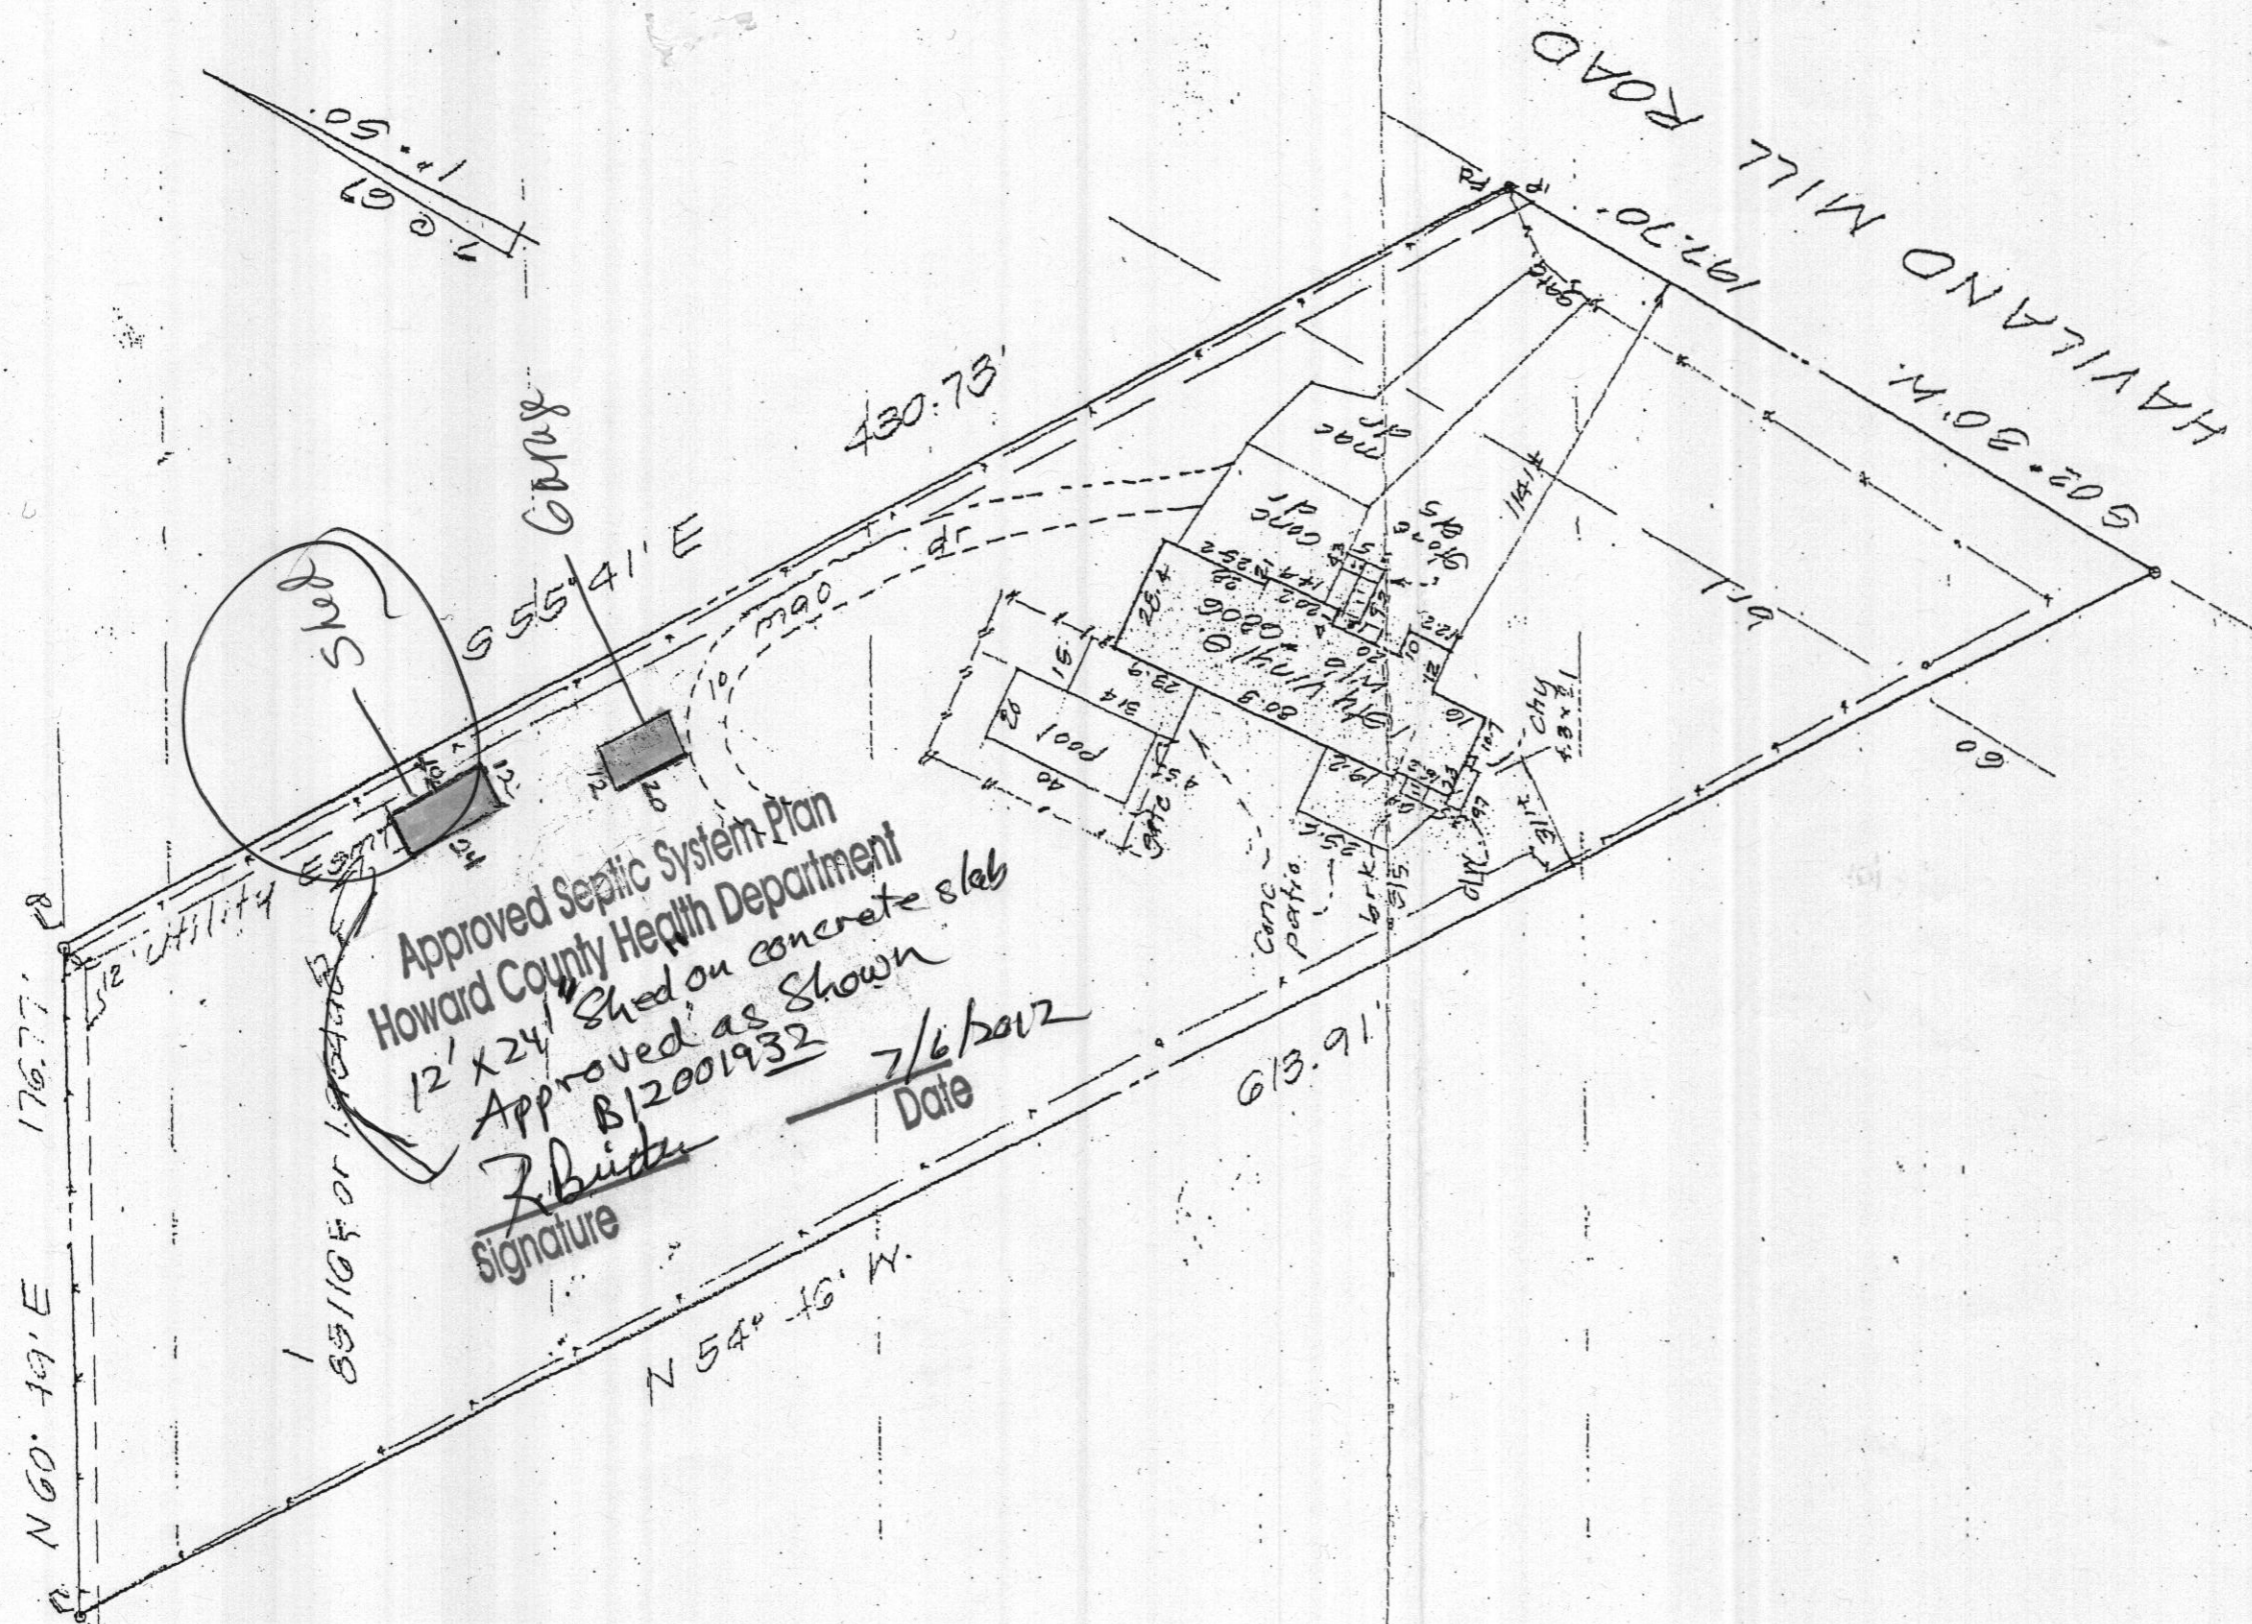

Approved Septic System Plan
 Howard County Health Department
 12' x 24' Shed on concrete slab
 Approved as Shown
 B12001932
 [Signature]
 Date 7/6/2012

NOTES: Not located in a H.U.D. designated Flood Hazard Zone as per F.E.M.A. Community Panel No. 24004400320
 This survey was prepared without the benefit of a title report.
 Information shown hereon should not be relied upon for construction of improvements.

TAX MAP GR. PAR. MTI DISK
 F.B.275 P.75

LOT IMPROVEMENT SURVEY
 6806 Haviland Mill Rd
 Lot 1
 JOHN W. GEITZ
 SURVEYOR



SURVEYOR'S CERTIFICATE
 I hereby certify that I have surveyed the property shown hereon for the purpose of locating the improvements only, and the improvements are located as shown. Exact property corners have not been established or set, unless otherwise noted. We assume no responsibility or liability for any right-of-ways or easements recorded or unrecorded or not appearing on the record plat / or mentioned in the title deed referred to hereon.

1160