

Copy of file 3:30

HOWARD COUNTY HEALTH DEPARTMENT

PERMIT-SEWAGE DISPOSAL SYSTEM

A 134

RE-INDEXED
INDEXED

Permit No. 0052

District B

Date _____

VAN SANT & BROWN

is permitted to

install

alter

a sewage disposal system located: Black's Corner

Route 99 S. side, 200 yards E. Route 32

Property Owner a. Dallas Slack

Address Sycamoreville

Location Black's Corner

SPECIFICATIONS:

PILE LINES Length width depth SEPTIC TANK

SEWAGE PITS Number Inside diam. Depth below surface

Absorbent area

SEPTIC TANK CAPACITY 750 gal.

OTHER: tile field to go within 100 ft. of route 99.

well to be located in rear on the higher ground

FEE _____

PLANS APPROVED BY: Walter W. Dullman 9/1/58

Fill septic tank and distribution box with water before calling for inspection.


No work is to be covered until inspected and _____ d.

Neither the Howard County Commissioners nor the Health Department is responsible for the successful operation of any installation.

A 134

P516503-A

P516503-A

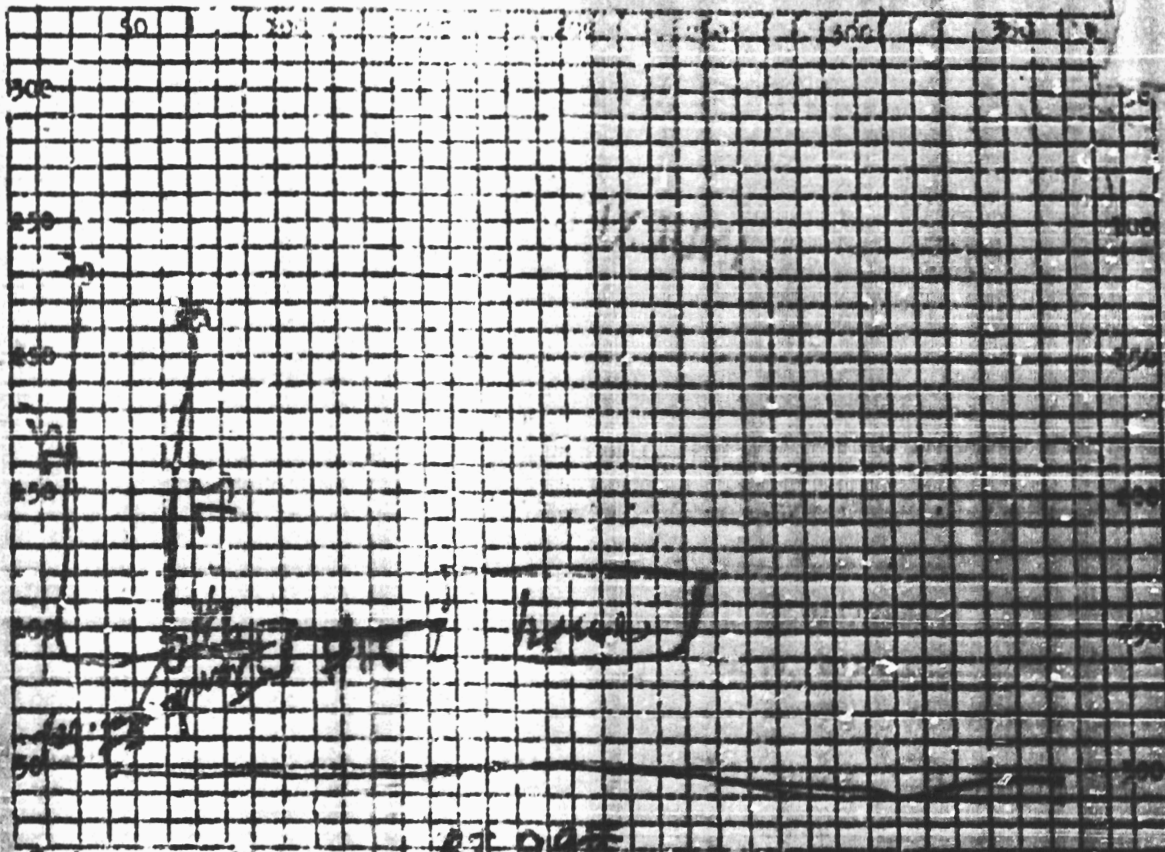

Each square = 10 feet.
 Locate system with reference to house and adjoining properties & Prev. Tests.

PERMIT CARD

Septic Tank Distance from Ground Surface Filled

Level Cleanouts

Distribution Box: Filled Level

Tile Field:

Depth of Tile

Width of Trenches

Grade Board

Total Length

Gravel Depth

Fall

No. of Trenches

Backfill on Hand

Seepage Pit:

Inside Diameter

Depth below inlet

Remarks:

Date System Approved and ready for Covering 3/

Inspector P. J. W.

CANT find this
file, but assigned it
to Kacie.

Kauffman
Collins
Smith
Black

1.613 case
Smith 1958

HOWARD COUNTY HEALTH DEPARTMENT

APPLICATION-SEWAGE DISPOSAL TESTING

Application No. 124

District 3

Date 22 Aug. 1958

TO: THE COUNTY HEALTH OFFICER
Ellicott City, Maryland

I, hereby, apply for the necessary tests in order to construct (or re-construct) a sewage disposal system.

PROPERTY OWNER Dallas Slack

Address Sykesville Phone Rev. 4-21-34

LOCATION OF PROPERTY: Subdivision _____ Lot No. _____

Road Slack's Corner, 32 and 99

OCCUPANT OF PROPERTY _____

Address _____ Phone _____

PERSON TO CONSTRUCT PLANT Souder Contracting Co., Pasadena

Address _____ Phone _____

SIZE OF LOT Four

TYPE OF BUILDING TO BE SERVED Residence

SYSTEM TO SERVE _____ PEOPLE NO. OF BEDROOMS 3

PERMIT NUMBER _____ SEE 10

SIGNATURE OF APPLICANT Dallas Slack

APPROVED BY [Signature] DATE 9/2/59

REJECTED BY _____ DATE _____

REASONS FOR REJECTION _____

FOR TEST FINDINGS, SEE OTHER SIDE.