

APPLICATION

SEWAGE DISPOSAL TESTING

9V
A-23272
P 04040

MARYLAND STATE DEPARTMENT OF HEALTH

HOWARD COUNTY

ELLICOTT CITY

DISTRICT

DATE

7500 Mount Park
Talbot Hill 319 sq ft bottom area
location in the area 75 ft x 150 ft from the side of the
lot across to Hill Rd and 65 ft to
14 ft from front lot line

TO: THE COUNTY HEALTH OFFICER
ELLICOTT CITY, MARYLAND

I, HEREBY, APPLY FOR THE NECESSARY TESTS IN ORDER TO CONSTRUCT OR RECONSTRUCT A SEWAGE DISPOSAL SYSTEM.

PROPERTY OWNER Joseph C. Miller

ADDRESS [REDACTED] 82692

PROPERTY LOCATION: Mount Park

SUBDIVISION _____ LOT NO _____

ROAD AND DESCRIPTION 21000 View Rd Northside 200 ft
West of intersection of Mt. View and Hill Rd

OCCUPANT Vacant PHONE _____

PERSON TO CONSTRUCT SYSTEM _____

ADDRESS _____ PHONE _____

SIZE OF LOT 1 acre TYPE BLDG 3 res
NUMBER OF BUILDINGS

IF NOT SINGLE RESIDENCE DESCRIBE _____

SIGNATURE OF APPLICANT Joseph C. Miller


APPROVED BY [Signature] FOR Talbot Hill DATE 1/10/61
(KIND OF SYSTEM)

REJECTED BY _____ FOR _____ DATE _____
(KIND OF SYSTEM)

HOLD PENDING FURTHER TESTS _____ DATE _____

REASONS FOR REJECTION OR HOLDING _____

THIS IS NOT A PERMIT

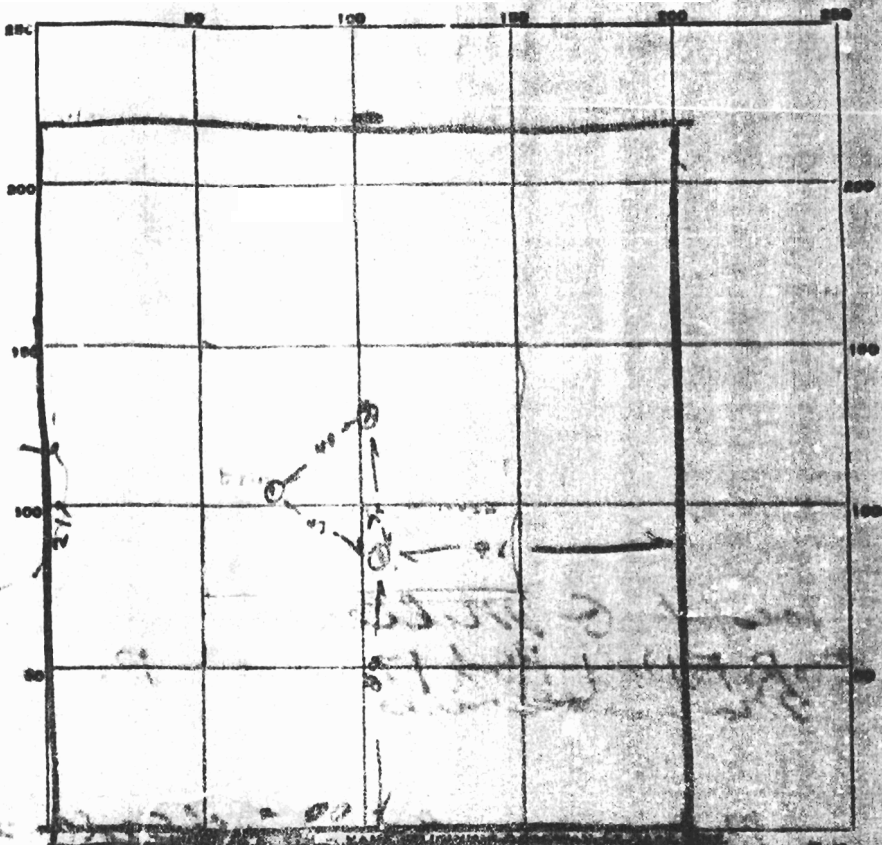

MT VIEW TO SAND HILL RD

DATE	TEST NO.	DEPTH	PRE-WET		TEST STOP		TIME
			START	STOP	START	STOP	
1/1/61	1	3	155	215	215	242	28 min
"	2	3	158	211	211	225	14 min
"	3	4	200	201	201	203	3 min

SOIL AUGER FINDING _____

TESTED BY Raymond Hodges

REMARKS _____

ALSO PRESENT Jack S. Miller LOT _____