

P 20397
45262-B
A 18604

SEWAGE DISPOSAL SYSTEM

MARYLAND STATE DEPARTMENT OF HEALTH
HOWARD COUNTY

ELLICOTT CITY
DISTRICT 4th
DATE 7/23/74

INDEXED
INDEXED

Briger Brothers IS PERMITTED TO INSTALL ALTER

ADDRESS Mr. Airy, Maryland PHONE 800-5006

A SEWAGE DISPOSAL SYSTEM LOCATED AT (2 1/2 mi. S.W. of A.E. N. 111th Rd.)

SUBDIVISION _____ ROAD 2031 Davall Road LOT _____

PROPERTY OWNER ~~Glyde Collins~~ Josiah Hall TABATHA WATSON

ADDRESS 3530 Bipsley Mill Road, Woodbine, Md.

SPECIFICATIONS 4 Bedrooms

DRAIN FIELD _____ DEPTH _____ FEET. BOTTOM AREA _____ SQ. FT.

SEEPAGE PITS _____ ABSORBENT SIDE-WALL AREA _____ SQ. FT.

SEPTIC TANK CAPACITY 1250 GALLONS

FOR GARBAGE GRINDER, INCREASE DISPOSAL AREA 25% & TANK CAPACITY 50%.

DRY WELL - To have 150 sq. ft. effective absorbent sidewall area per
~~foot~~ below inlet. Inlet to be 4 1/2 ft. below original grade and maximum depth
11 1/2 ft. Locate dry well 300 ft. from center of existing road and 225 ft. 115 ft.
off left property line as seen when facing lot from road. (Parse hold 1 and 2).

NOTE: ALL PIPE FROM HOUSE TO DRY WELL MUST BE CAST IRON.
PERMIT VOID AFTER THREE YEARS.

NOTE: INSTALL STAND PIPE ON SEPTIC TANK AND DRY WELL.

PLANS APPROVED BY I Charles B. Streaker DATE 7/20/73

FILL SEPTIC TANK AND DISTRIBUTION BOX WITH WATER BEFORE CALLING FOR AN INSPECTION. COVER NO WORK UNTIL INSPECTED AND APPROVED.


NEITHER THE HOWARD COUNTY COMMISSIONERS NOR THE HEALTH DEPARTMENT IS RESPONSIBLE FOR THE SUCCESSFUL OPERATION OF ANY SYSTEM.

LOG. PERMIT SIGNED
AND RETURNED 6-6-97
Serial # 59541 Prod
propose tank

BLDG. PERMIT SIGNED
AND RETURNED 6/19/84
Serial # 59541 Prod

A 45262-B

2031 Duwall Rd

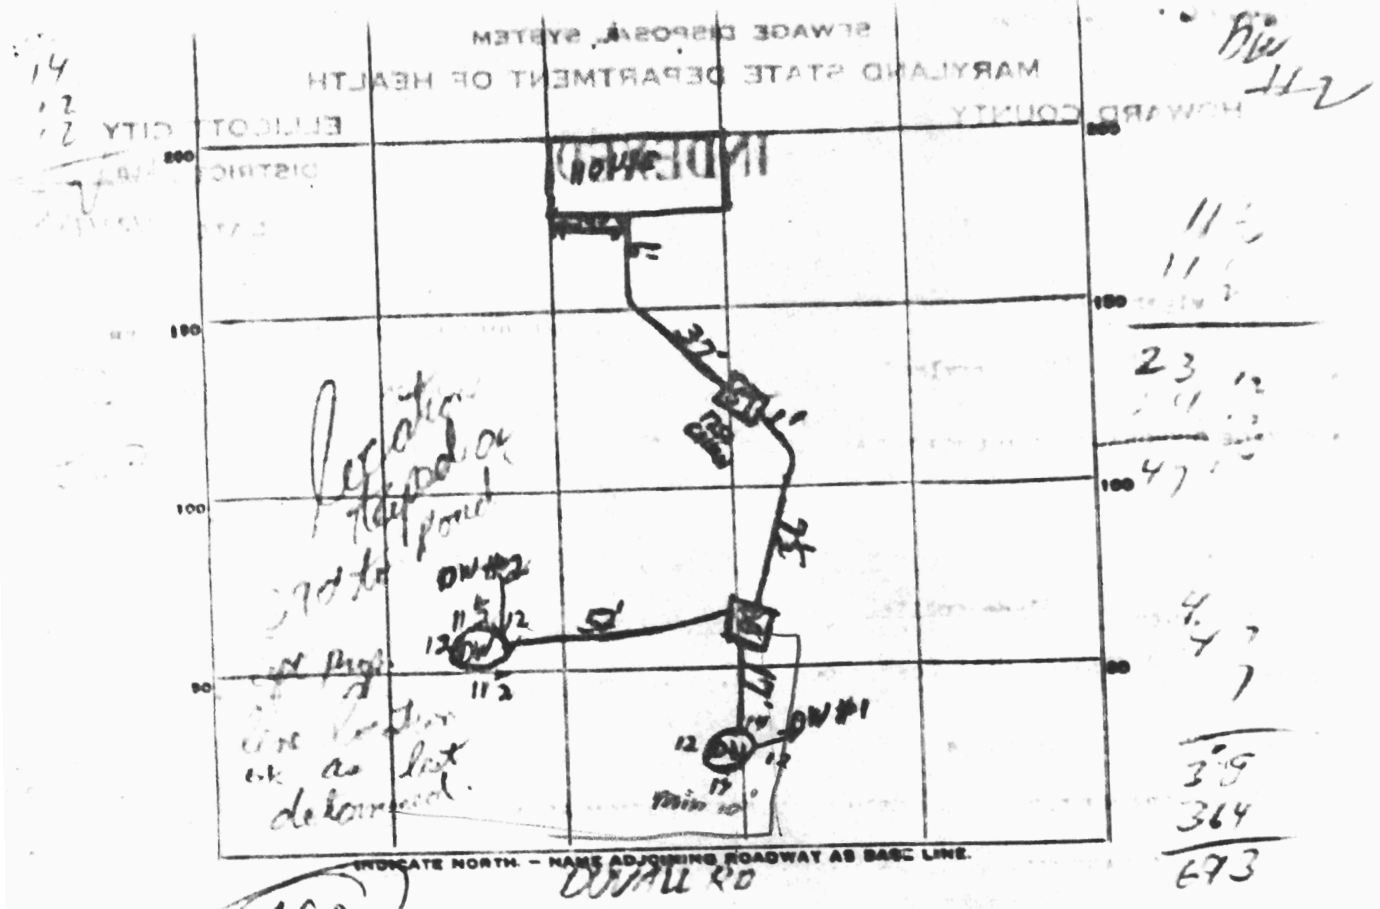

PERMIT CARD NO

SEPTIC TANK LEVEL OK CLEANOUTS OK

DISTRIBUTION BOX LEVEL OK

TILE FIELD DEPTH NA FT. TRENCH WIDTH NA FT.

GRAVEL DEPTH NA IN. TOTAL LENGTH NA FT.


NUMBER OF TRENCHES NA TOTAL BOTTOM AREA NA

STORAGE PITS 52 FT. DEPTH BELOW INLET 4 FT.

ABSORBENT AREA 364 SQ. FT. - 693

REMARKS: No permit condition, left note to call office before covering system. HZ
8' col. str. OK, cleanout tight R.M. all covered by D.V.'s

DATE SYSTEM APPROVED 8/20/24 INSPECTOR R. Morefield

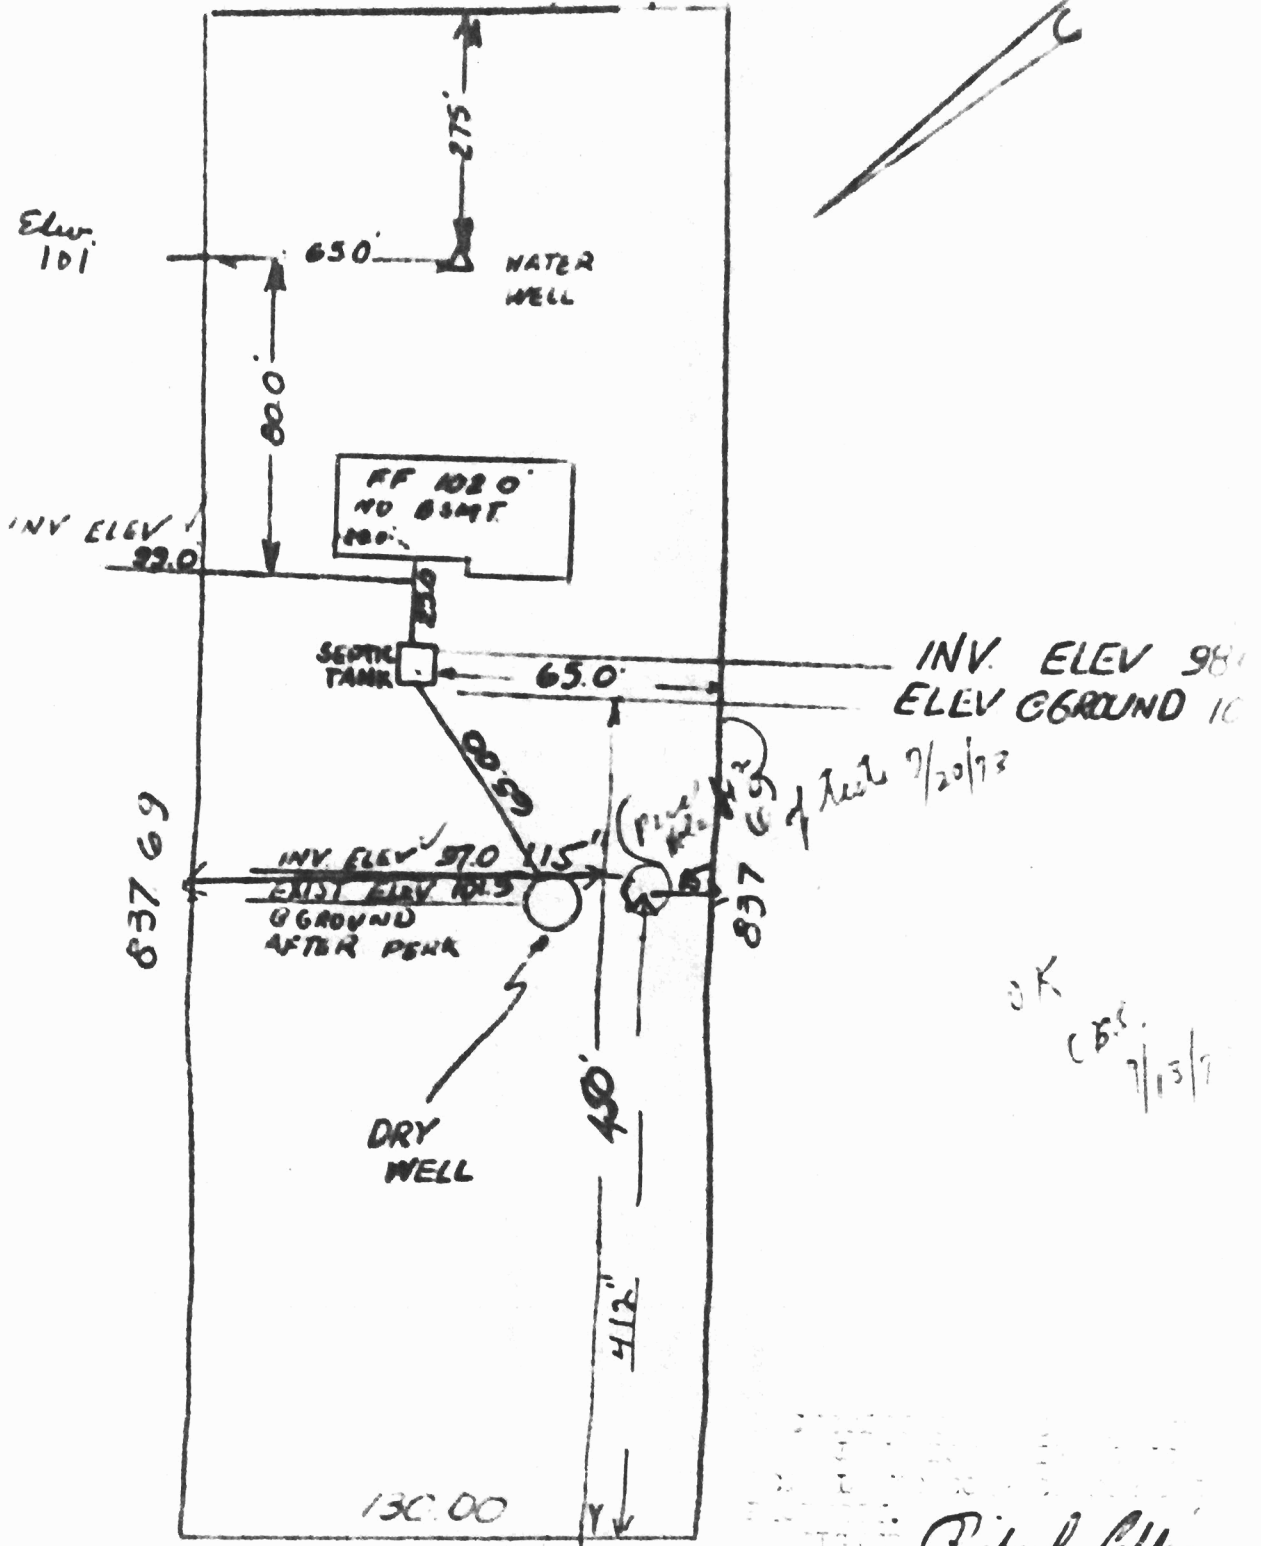

7 feet 2/20/73

OK
C.B.S.
7/13/73

DUVALL RD

Richard Collins