

LAYOUT 11/7/03-2:30 INSP 4 \_\_\_\_\_  
 INSP 2 11/13/03-PM INSP 5 \_\_\_\_\_  
 INSP 3 12/19/03-1PM INSP 6 \_\_\_\_\_

ISSUE DATE: 10/22/2003  
 APPROVAL DATE: 12/19/03

P 519633  
 A 516543

**PERMIT**  
**INDEXED**  
 04367354

**ON-SITE SEWAGE DISPOSAL SYSTEM  
 HOWARD COUNTY HEALTH DEPARTMENT  
 BUREAU OF ENVIRONMENTAL HEALTH**

Fogles Septic Clean, Inc IS PERMITTED TO INSTALL  ALTER   
 ADDRESS: 580 Obrecht Rd, Sykesville 21784 PHONE NUMBER: 410-795-5670  
 SUBDIVISION: Noah's Meadow LOT NUMBER: 1  
 ADDRESS: Route 97  
1015 Hoods Mill Road PROPERTY OWNER: Pulte Homes, Inc.  
 SEPTIC TANK CAPACITY (GALLONS): 1500 OUTLET BAFFLE FILTER REQUIRED   
 PUMP CHAMBER CAPACITY (GALLONS): 1500 COMPARTMENTED TANK REQUIRED   
 NUMBER OF BEDROOMS: 5  
 SQUARE FEET PER BEDROOM: 240  
 LINEAR FEET OF TRENCH REQUIRED: 400 HOUSE SERVED BY PUBLIC WATER

TRENCHES:	Trench to be 3.0 feet wide. Inlet 3.0 feet below original grade. Bottom maximum depth 5.0 feet below original grade. Effective area begins at 4.0 feet below original grade. 2.0 feet of stone below distribution pipe.
LOCATION:	Place the distribution box near the upper corner easement stake that is closest to the house. Run trenches on contour towards lot # 2.
NOTES:	Trenches must <sup>be</sup> spaced 10' center to center. Keep septic tanks out of center swale.


PLANS APPROVED: Brian Baker *ok me* DATE: 8/8/03

NOTES: PERMIT VOID AFTER 2 YEARS  
 CONTRACTOR IS RESPONSIBLE FOR SCHEDULING A PRE-CONSTRUCTION INSPECTION FOR ALL INSTALLATIONS  
 WATERTIGHT SEPTIC TANKS REQUIRED  
 ALL PARTS OF SEPTIC SYSTEM SHALL BE 100 FEET FROM ANY WATER WELL UNLESS SPECIFICALLY AUTHORIZED  
 MANHOLE RISERS REQUIRED ON ALL SEPTIC TANKS AND PUMP CHAMBERS UNLESS SPECIFICALLY AUTHORIZED  
 CONTRACTOR RESPONSIBLE FOR COMPLIANCE WITH APPLICABLE REGULATIONS, GUIDELINES AND THE TERMS OF THIS PERMIT

**NEITHER THE HOWARD COUNTY COUNCIL NOR THE HEALTH DEPARTMENT IS  
 RESPONSIBLE FOR THE SUCCESSFUL OPERATION OF ANY SYSTEM  
 PERMITTEE RESPONSIBLE FOR OBTAINING FINAL APPROVAL ON THIS PERMIT  
 ALL 410-313-2640 FOR INSPECTION OF SEPTIC SYSTEM**

A 516543

NOT TO SCALE

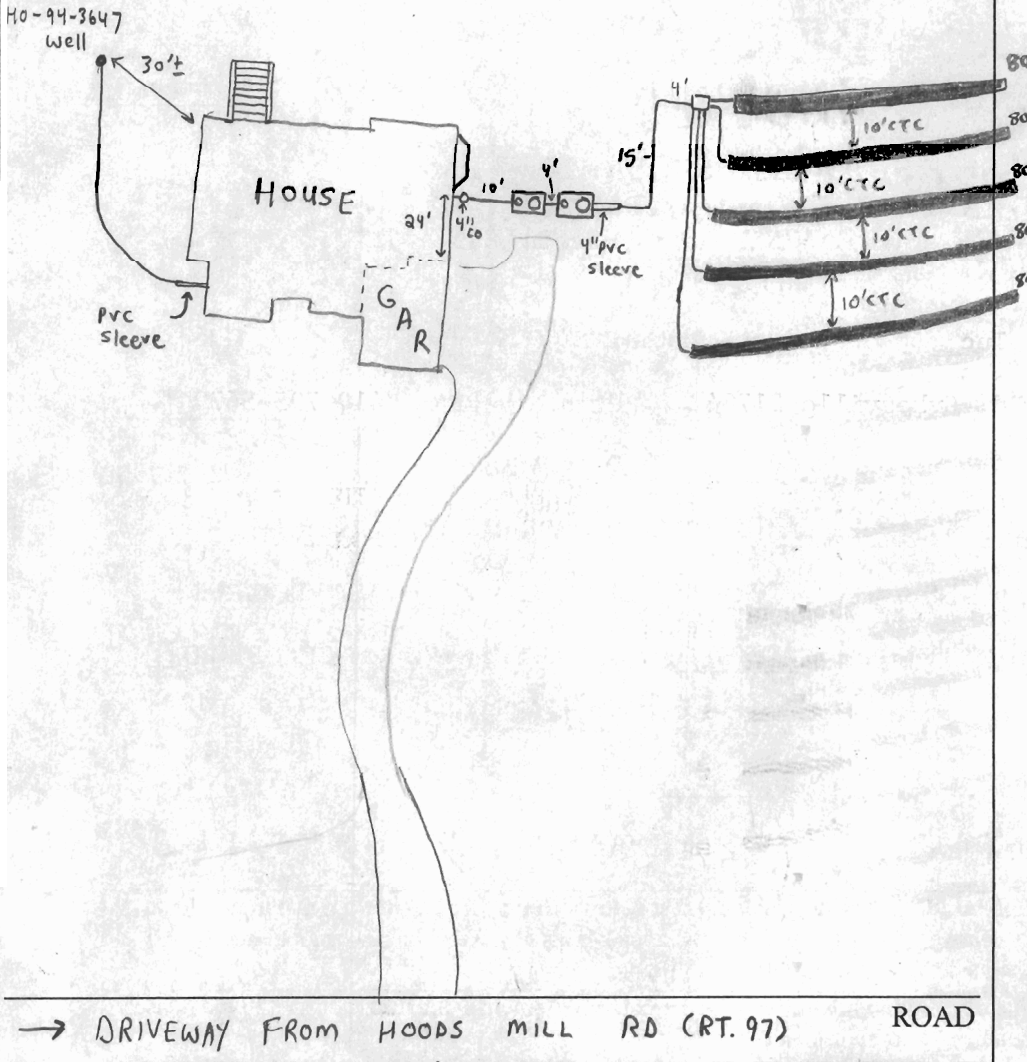

TRENCH/DRAINFIELD DATA		
WIDTH		BOTTOM
3	3	5
NUMBER OF TRENCHES	5	
TOTAL LENGTH	400'	
ABSORPTION AREA	1200 ft <sup>2</sup>	
DISTRIBUTION BOX LEVEL	✓	
DISTRIBUTION BOX BAFFLE	✓	
DISTRIBUTION BOX PORT	✓	

SEPTIC TANK DATA	
SEPTIC TANK 1 LEVEL	✓
CAPACITY	1500 GAL
SEAM LOC	Top
TANK LID DEPTH	2-3'
BAFFLES	✓
BAFFLE FILTER	NA
MANHOLE LOC	Rear
6" PORT LOC	Front
WATERTIGHT TEST	NA
SEPTIC TANK 2 LEVEL	
CAPACITY	1500 GAL
SEAM LOC	Top
TANK LID DEPTH	2-3'
BAFFLES	NA
BAFFLE FILTER	NA
MANHOLE LOC	Rear
6" PORT LOC	Front
WATERTIGHT TEST	NA

PRE-CONSTRUCTION 11/7/03 - SRA stated, contour a little off  
 Install per B.P. on correct contour (50)

INSTALLATION 11/13/03 - OK TO COVER ALL WORK, PUMP & ALARM TEST STILL NEEDED (SRK)  
12/19/03 - Pump & Alarm test OK (50)

FINAL INSPECTOR John O'Brien DATE OF APPROVAL 12/19/03







Maryland Division, 1501 S. Edgewood Street, Suite K, Baltimore, Maryland 21227 • (410) 644-5603 • Fax (410) 644-2643

August 7, 2003

Howard County Health Department  
Water and Sewerage Division  
3525 Ellicott Mills Drive  
Ellicott City, MD 21043  
Attn: Mr. Brian Baker, Sanitarian

RE: Noah's Meadows – Lots 1 and 2  
(Md. Route 97)

Mr. Baker,

In accordance with your request, I am forwarding this letter to clarify our intent with regard to the grading related to the house construction for the above-referenced lots.

As indicated on the building permit plans, we do not expect to conduct any grading activities inside the approved septic easement to accommodate the homes and associated driveways. This includes over-dig related to the basement excavation of these homes. As indicated in your message of earlier today, if field conditions are present that will require grading (fill) in the approved septic easement, this work will not be conducted until which time the installation of the septic system is approved by your office.

Should you have any questions or require additional information, please contact me at your earliest convenience. Your cooperation and assistance is greatly appreciated.

Sincerely,

A handwritten signature in black ink, appearing to read "Michael J. McCann".

Michael J. McCann  
Land Acquisition Manager

CC: Rich Conlon  
Ferry LaRuffo  
Tim Ganske  
Dianna Wenzlaff

OWNER Polte Homes Lot 1

ADDRESS 1015 Hoods Mill Road Woodbine, MD 21797

PLEASE SHOW BELOW:

- Property line dimensions and easements;
- Existing buildings;
- Existing well/septic; (show distance to nearest structure)
- Road names and location of alleys;
- If your property is in a tidal or riverine flood area, indicate elevation of 1 floor of proposed work.
- The proposed work and the setback distances to the proposed work.


Front Setback \_\_\_\_\_

Left Setback \_\_\_\_\_

Rear Setback \_\_\_\_\_

Right Setback \_\_\_\_\_

NOTE: Cannot fence access easement.

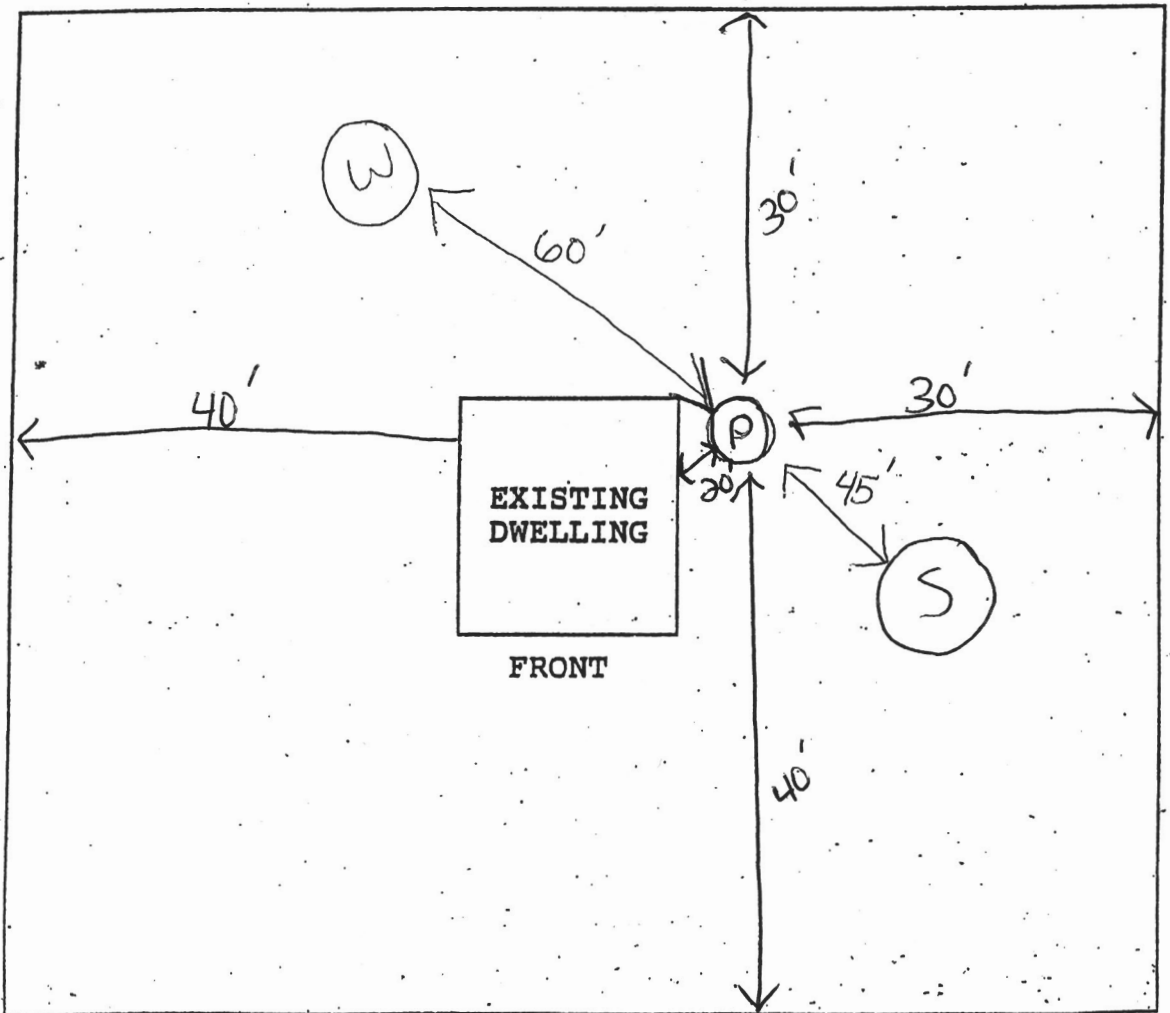

ROAD NAME Hoods Mill Road