

app-2-3-67
Aug

PERMIT

P. 1204
A. 0203

2/3/67
Leahy

SEWAGE DISPOSAL SYSTEM

MARYLAND STATE DEPARTMENT OF HEALTH

HOWARD COUNTY

INDEXED

ELLICOTT CITY

DISTRICT 3

DATE 1/25/67

Richard Lane

IS PERMITTED TO INSTALL T ALTER

ADDRESS Clabaster Road, Ellicott City, Maryland PHONE EL 2-7300

A SEWAGE DISPOSAL SYSTEM LOCATED AT _____

SUBDIVISION Burat Road ROAD 14015 Clabaster LOT 6, Blk. 2, Sub. 3, Pt. 2

PROPERTY OWNER Smart Home Development Co., Inc.

ADDRESS _____

SPECIFICATIONS - 4 bedrooms

DRAIN FIELD _____ DEPTH _____ FEET. BOTTOM AREA _____ SQ. FT.

SEEPAGE PITS _____ ABSORBENT SIDE WALL AREA _____ SQ. FT.

SEPTIC TANK CAPACITY 1,000 GALLONS

FOR GARBAGE GRINDER, INCREASE DISPOSAL AREA 22% & TANK CAPACITY 30%

OTHER Dry well - 108 sq. ft. throughout sidewalk area per bedroom.

Locate dry well 35 ft. from front lot line and 30 ft. from right side line of

lot in area when facing it from street "B".

PERMIT VOID AFTER THREE YEARS.


PLANS APPROVED BY Morgan & Fletcher DATE 9/24/64

FILL SEPTIC TANK AND DISTRIBUTION BOX WITH WATER BEFORE CALLING FOR AN INSPECTION. COVER NO WORK UNTIL INSPECTED AND APPROVED.

NEITHER THE HOWARD COUNTY COMMISSIONERS NOR THE HEALTH DEPARTMENT IS RESPONSIBLE FOR THE SUCCESSFUL OPERATION OF ANY SYSTEM.

0900

A 516977

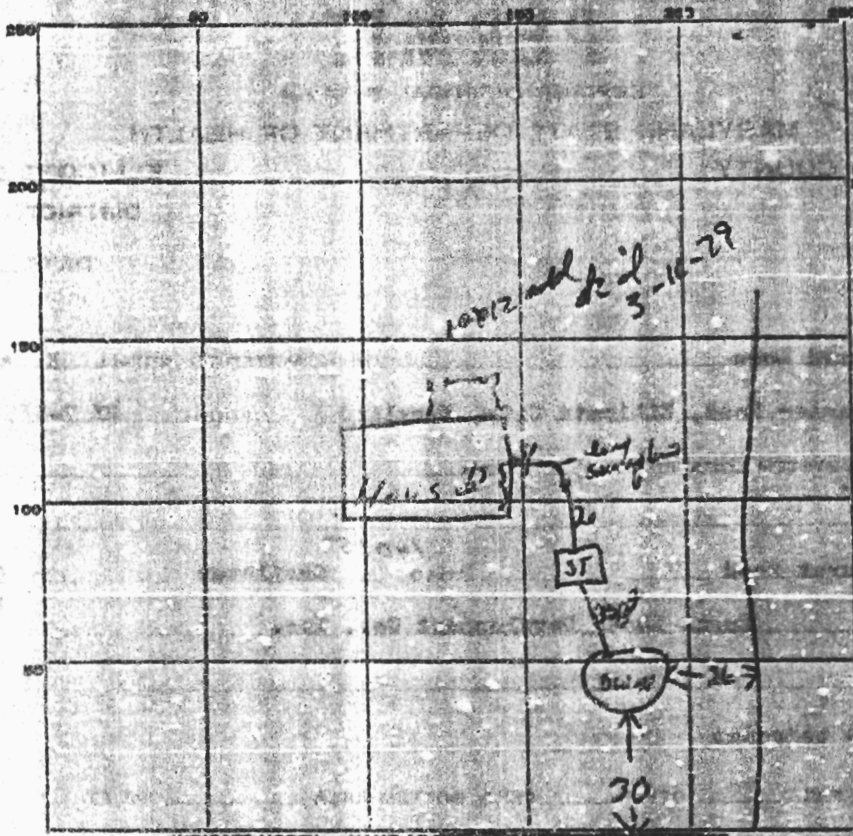

PERMIT CARD OK

SEPTIC TANK, LEVEL OK

CLEARANCE OK

DISTRIBUTION BOX, LEVEL _____

TILE FIELD, DEPTH _____ FT. TRENCH WIDTH _____ FT.

GRAVEL DEPTH _____ IN. TOTAL LENGTH _____ FT.

NUMBER OF TRENCHES _____ TOTAL BOTTOM AREA _____

SEEPAGE PIT, INSIDE DIAMETER 12 FT. DEPTH BELOW INLET 12 FT.

ABSORBENT AREA 452 SQ. FT.

REMARKS _____

DATE SYSTEM APPROVED 2/3/67

INSPECTOR [Signature]