

516102 To Follow CABIN HILL PERK

5/14/02

1.00

PUB. SEWER STATUS VERIFIED BY Not Authorized per MARK

05-345758

ISSUE DATE: 5/14/2002

APPROVAL DATE: 5/14/02

PERMIT INDEXED

P 516973
A 516973
REPAIR

**ON-SITE SEWAGE DISPOSAL SYSTEM
HOWARD COUNTY HEALTH DEPARTMENT
BUREAU OF ENVIRONMENTAL HEALTH**

Cell

410,984 2185

Jack Fyock Septic Service IS PERMITTED TO INSTALL ALTER

ADDRESS: P.O. Box 89, Glenelg PHONE NUMBER: 410-988-9270

SUBDIVISION: Highland Acres LOT NUMBER: 1

ADDRESS: 7601 Brown Bridge Road PROPERTY OWNER: Olwine

SEPTIC TANK CAPACITY (GALLONS): 1000? ex TANK

PUMP CHAMBER CAPACITY (GALLONS): N/A just pumped 04/02

NUMBER OF BEDROOMS: 3?

SQUARE FEET PER BEDROOM: 210

LINEAR FEET OF TRENCH REQUIRED: 158 if possible


| | |
|-----------|---|
| TRENCHES: | Trench to be 2 feet wide. Inlet 4 feet below original grade. Bottom maximum depth 8 feet below original grade. Effective area begins at 4 feet below original grade. 4 feet of stone below distribution pipe. |
| LOCATION: | Existing septic system is failing. Call for inspection when ground is opened. |
| PURPOSE: | |

PLANS APPROVED: _____ DATE: 4/22/02

- NOTE: PERMIT VOID AFTER 2 YEARS
- NOTE: CONTRACTOR RESPONSIBLE FOR SCHEDULING A PRE-CONSTRUCTION INSPECTION FOR ALL INSTALLATIONS
- NOTE: WATERTIGHT SEPTIC TANKS REQUIRED
- NOTE: ALL PARTS OF SEPTIC SYSTEM SHALL BE 100 FEET FROM ANY WATER WELL
- NOTE: MANHOLE RISERS REQUIRED ON ALL SEPTIC TANKS AND PUMP CHAMBERS

NEITHER THE HOWARD COUNTY COUNCIL NOR THE HEALTH DEPARTMENT IS RESPONSIBLE FOR THE SUCCESSFUL OPERATION OF ANY SYSTEM PERMITTEE RESPONSIBLE FOR OBTAINING FINAL APPROVAL ON THIS PERMIT CALL 410-313-2640 FOR INSPECTION OF SEPTIC SYSTEM

A 516973

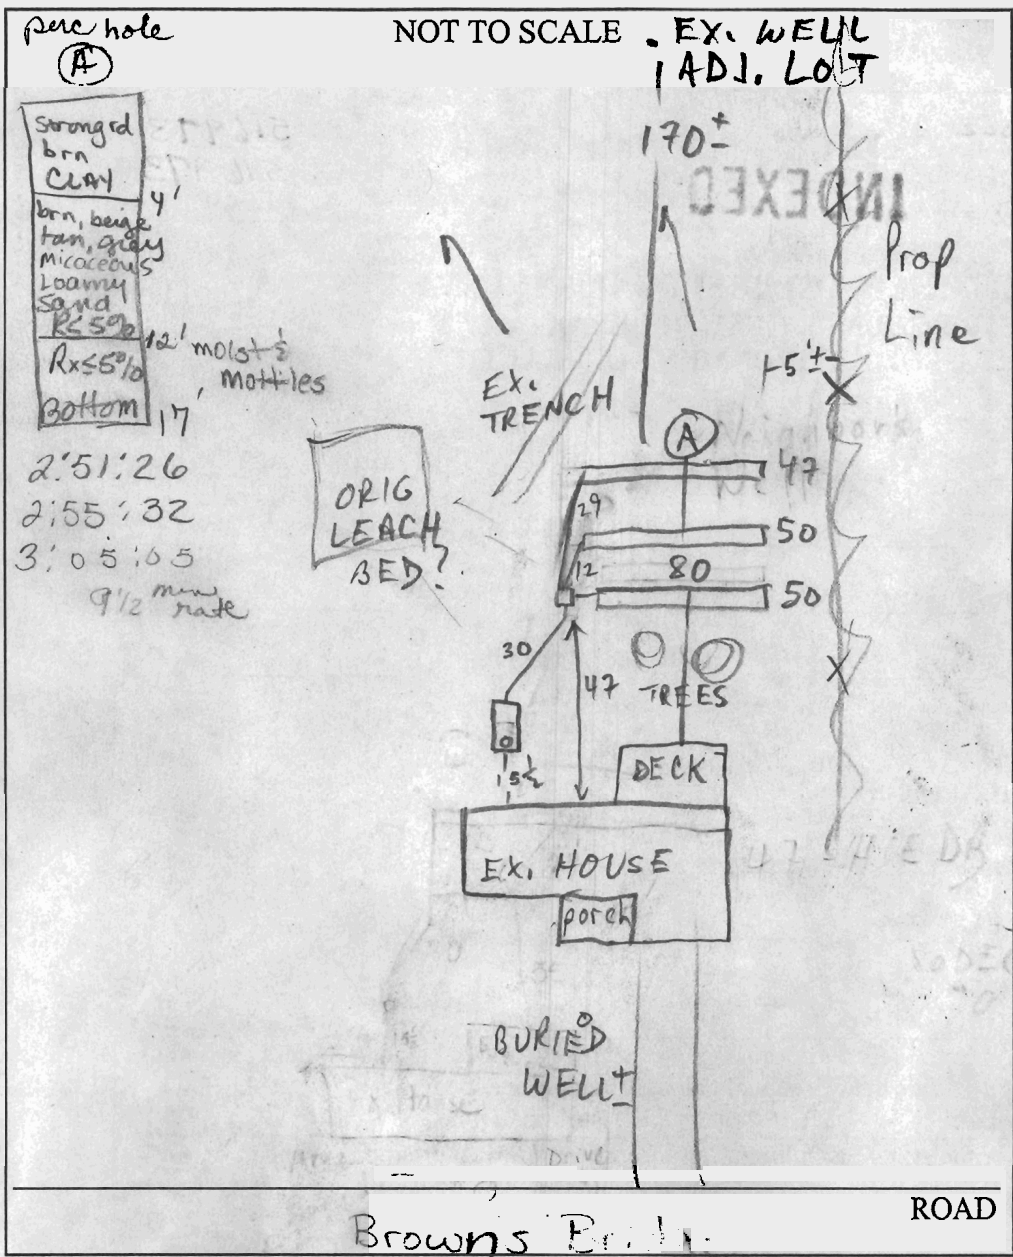

TRENCH/DRAINFIELD DATA

| WIDTH | INLET | BOTTOM |
|-------|-------|--------|
| 4 | 4 | 8 |

NUMBER OF TRENCHES _____

TOTAL LENGTH 147

ABSORPTION AREA 581

DISTRIBUTION BOX LEVEL

DISTRIBUTION BOX BAFFLE

DISTRIBUTION BOX PORT

SEPTIC TANK DATA

SEPTIC TANK 1 LEVEL EX.

CAPACITY 52 GAL

SEAM LOC MID ?

TANK LID DEPTH ?

BAFFLES ?

BAFFLE FILTER -

MANHOLE LOC -

6" PORT LOC FRONT

WATERTIGHT TEST -

SEPTIC TANK 2 LEVEL _____

CAPACITY _____ GAL

SEAM LOC _____

TANK LID DEPTH _____

BAFFLES _____

BAFFLE FILTER _____

MANHOLE LOC _____

6" PORT LOC _____

WATERTIGHT TEST _____

PRE-CONSTRUCTION 5/7/02 To try place 4 short trenches
behind deck while avoiding trees. There is a well
 INSTALLATION directly downhill of any trenches that could
potentially be placed near the rear lot line. To stay
10' from existing trenches. (A)
5/14/02 OK TO FINISH + COVER MR/LB

FINAL INSPECTOR M. Ripkin / J. Boris DATE OF APPROVAL 5/14/02

7/7/74
cancel 2-3 PM

PERMIT

P. 20308
A. _____

SEWAGE DISPOSAL SYSTEM

MARYLAND STATE DEPARTMENT OF HEALTH

HOWARD COUNTY

ELLICOTT CITY

DISTRICT 5

INDEXED

DATE 7/23/74

BLDG. PERMIT SIGNED
AND RETURNED 6/8/74

Serial # 43274
Paul

Paul Thompson

IS PERMITTED TO INSTALL ALTER X

ADDRESS Brown Bridge Road, Highland, Md. PHONE 286-2613

A SEWAGE DISPOSAL SYSTEM LOCATED AT _____

SUBDIVISION Highland Acres ROAD 7501 Brown Bridge Rd. LOT 271, Sec. 2
(across from Highland Green)

PROPERTY OWNER Clarence Cayell

ADDRESS _____

SPECIFICATIONS

DRAIN FIELD _____ DEPTH _____ FEET, BOTTOM AREA _____ SQ. FT.

SEEPAGE PITS _____ ABSORBENT SIDE-WALL AREA _____ SQ. FT.

SEPTIC TANK CAPACITY _____ GALLONS

FOR GARBAGE GRINDER, INCREASE DISPOSAL AREA 25% & TANK CAPACITY 50%.

OTHER REPAIR - Call for inspection when ground is opened up so Sanitation can

240

recommend repair system,

PLANS APPROVED BY Palmer F. Wine DATE 7/16/74

FILL SEPTIC TANK AND DISTRIBUTION BOX WITH WATER BEFORE CALLING FOR AN INSPECTION. COVER NO WORK UNTIL INSPECTED AND APPROVED.

NEITHER THE HOWARD COUNTY COMMISSIONERS NOR THE HEALTH DEPARTMENT IS RESPONSIBLE FOR THE SUCCESSFUL OPERATION OF ANY SYSTEM.

Paul 7-17-74
11' 255 258 258-304 (6)

BLDG. PERMIT SIGNED
AND RETURNED 9/12/74
Serial # 21048 - Ned

21048

7/17/74
cancel 2-3 PM

PERMIT

P. 2732
A

SEWAGE DISPOSAL SYSTEM

MARYLAND STATE DEPARTMENT OF HEALTH

HOWARD COUNTY

ELLICOTT CITY

INDEXED

DISTRICT 5

BLDG. PERMIT SIGNED
AND RETURNED 6/2/74
Serial # 43274
Paul

DATE 7/23/74

Paul Thompson IS PERMITTED TO INSTALL 2

ADDRESS Brown Bridge Road, Highland, Md. PHONE 286-2613

A SEWAGE DISPOSAL SYSTEM LOCATED AT _____

SUBDIVISION Highland Acres ROAD 7801 Brown Bridge Rd. LOT 271, Sec. 2
(corner from Highland Road)

PROPERTY OWNER Charles Carroll

ADDRESS _____

SPECIFICATIONS

DRAIN FIELD _____ DEPTH _____ FEET, BOTTOM AREA _____ SQ. FT.

SEEPAGE PITS _____ ABSORBENT SIDE-WALL AREA _____ SQ. FT.

SEPTIC TANK CAPACITY _____ GALLONS

FOR GARBAGE GRINDER, INCREASE DISPOSAL AREA 25% & TANK CAPACITY 50%.

OTHER REPAIR - Call for inspection when ground is opened up so Sanitation can
recommend repair system.

PLANS APPROVED BY Palmer F. Wine DATE 7/16/74


FILL SEPTIC TANK AND DISTRIBUTION BOX WITH WATER BEFORE CALLING FOR AN INSPECTION. COVER NO WORK UNTIL INSPECTED AND APPROVED.

NEITHER THE HOWARD COUNTY COMMISSIONERS NOR THE HEALTH DEPARTMENT IS RESPONSIBLE FOR THE SUCCESSFUL OPERATION OF ANY SYSTEM.

Paul 7-17-74
11' 255 258 258-364 6

BLDG. PERMIT SIGNED
AND RETURNED 9/2/74
Serial # 21048 - Reed

7-22-78

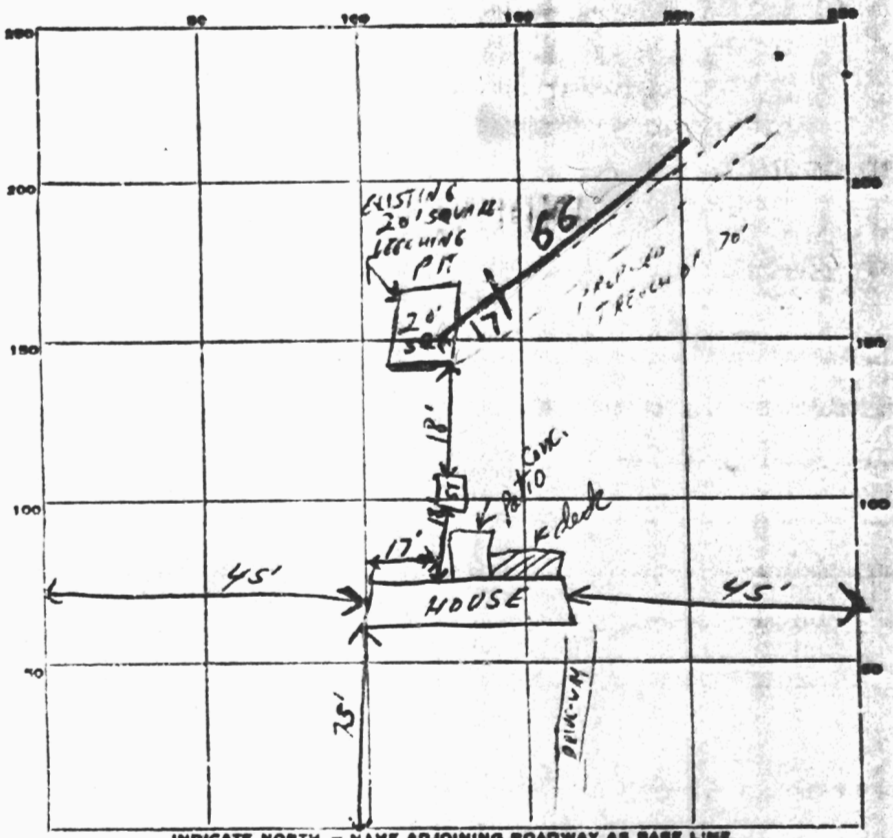

70
980

Brown Bridge Rd

PERMIT CARD _____

SEPTIC TANK, LEVEL EXISTING

CLEANOUTS _____

DISTRIBUTION BOX, LEVEL _____

DITCH

TILE FIELD, DEPTH 17 FT. TRENCH WIDTH 2 FT.

GRAVEL DEPTH 8 FT IN. TOTAL LENGTH 66

NUMBER OF TRENCHES 1

TOTAL BOTTOM AREA 579

66
1836 (Both sides)
579 (Bottom area)
528

SEEPAGE PITS, INSIDE DIAMETER _____ FT.

DEPTH BELOW INLET _____ FT.

ABSORBENT AREA _____ SQ. FT.

REMARKS

trench to run in length 70ft from existing pit
disconnecting existing pit. Max. depth of trench 12 feet.
Connect tank to trench with 2" depth of
gravel to 8ft. absorbent on 560 sq ft. Call for
final ck out before covering system 7-17-74 1112
inst. B lasted 9 years

DATE SYSTEM APPROVED 7/18/74

INSPECTOR Raymond J. Hodge



HOWARD COUNTY HEALTH DEPARTMENT

P516973

DATE 5 / 14 / 2002

Received From Jack Fyock Septic Service

410-988-9270

PO Box 89 Glenely MD 21737

For Repair Permit

- CASH
- CHECK

7601 Brown Bridge

NO.

13085

Twenty-five and 00/100

Dollars

\$ 25 | 00

Received By Mary L Briggs

P# need to go on permits when file comes back from field.