

**THIS REPORT
MUST BE SUBMITTED
WITHIN 30 DAYS
AFTER COMPLETION
OF THE WELL**

WELL COMPLETION REPORT

WELL DESCRIPTION

Permit Number H-1100-314
Owner John Parrish
Address Homewood
Subdivision Well Street
Section 4 Lot 2

WELL LOG

State the kind of formations penetrated, their color, their depth, their thickness, and if water-bearing

CASING AND SCREEN RECORD

State the kind and size and position of casing, liner, shoe, screen, and other accessories (if no casing used, give diameter of well).

	FEET		DIAM. (inches)	FEET	
	from	to		from	to
Spoil	0	3	Steel 6 1/4	30'	
Shale	3	25			
Hard Gray Rock	25	220			
water		90			

PUMPING TEST
Hours Pumped 4 1/2
Type of Pump Used sub
Pumping Rate 3
Gallons per Minute


WATER LEVEL
(Distance from land surface to water)
Before Pumping 65 Ft.
When Pumping 220 Ft.

APPEARANCE OF WATER
Clear _____ Cloudy _____
Taste _____
Odor _____

Height of Casing Above Land Surface 1 Ft.

PUMP INSTALLED
Type _____
Capacity _____
Gallons per Minute _____
Gallons per Hour _____
Pump Column Length _____ Ft.

LOCATION OF WELL ON LOT
Show permanent structures such as building(s), septic tank, and/or other landmarks and indicate not less than 2 distances (measurements) to well.

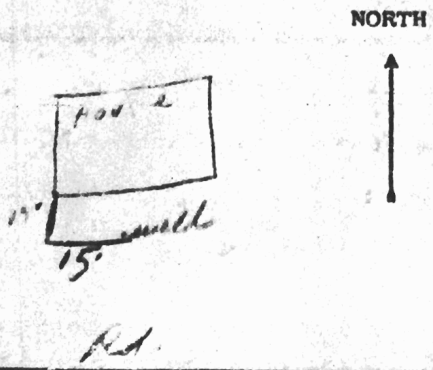

DATE WELL WAS COMPLETED

June 23, 66

I hereby affirm that this report contains no willful misrepresentations or falsifications and that information given in this report is true, accurate and complete to the best of my knowledge and belief.

J. H. Costello, Well Driller

Well Driller License No.: 72