

5/13/02
10:00

04-325842

PUB. SEWER STATUS VERIFIED BY NASRK

ISSUE DATE: 5/9/2002
APPROVAL DATE: 5-17-02

PERMIT INDEXED

P 516968
A 516968
REPAIR

ON-SITE SEWAGE DISPOSAL SYSTEM HOWARD COUNTY HEALTH DEPARTMENT BUREAU OF ENVIRONMENTAL HEALTH

Fogles Septic Clean, Inc IS PERMITTED TO INSTALL ALTER

ADDRESS: 580 Obrecht Road PHONE NUMBER: 410-795-5670

SUBDIVISION: Mill Green LOT NUMBER: 2

ADDRESS: 3366 Hipsley Mill Road PROPERTY OWNER: Geralis

SEPTIC TANK CAPACITY (GALLONS): Replace ex. w/ 1250 T.S.

PUMP CHAMBER CAPACITY (GALLONS): N/A.

NUMBER OF BEDROOMS: 4

SQUARE FEET PER BEDROOM: 210

LINEAR FEET OF TRENCH REQUIRED: 210 3-70' trenches

TRENCHES:	Trench to be <u>2</u> feet wide. Inlet <u>4</u> feet below original grade. Bottom maximum depth <u>8</u> feet below original grade. Effective area begins at <u>3 1/2</u> feet below original grade. <u>4</u> feet of stone below distribution pipe.
LOCATION:	In support of building permit B00135569. Call for inspection when ground is opened.
PURPOSE:	<u>ADDITION OF 1 BDRM</u> <u>call for inspect</u>

PLANS APPROVED: MR. KB DATE: 5/13/02


- NOTE: PERMIT VOID AFTER 2 YEARS
- NOTE: CONTRACTOR RESPONSIBLE FOR SCHEDULING A PRE-CONSTRUCTION INSPECTION FOR ALL INSTALLATIONS
- NOTE: WATERTIGHT SEPTIC TANKS REQUIRED
- NOTE: ALL PARTS OF SEPTIC SYSTEM SHALL BE 100 FEET FROM ANY WATER WELL
- NOTE: MANHOLE RISERS REQUIRED ON ALL SEPTIC TANKS AND PUMP CHAMBERS

NEITHER THE HOWARD COUNTY COUNCIL NOR THE HEALTH DEPARTMENT IS RESPONSIBLE FOR THE SUCCESSFUL OPERATION OF ANY SYSTEM PERMITTEE RESPONSIBLE FOR OBTAINING FINAL APPROVAL ON THIS PERMIT CALL 410-313-2640 FOR INSPECTION OF SEPTIC SYSTEM

A 516968

NOT TO SCALE

INDEXED

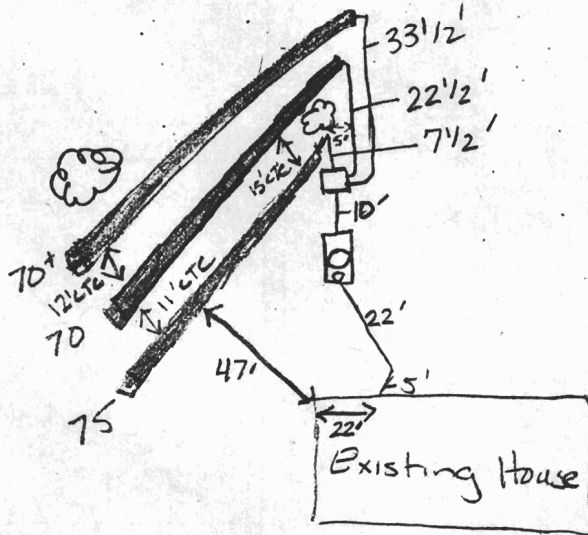

33660 Hipsley Mill

ROAD

TRENCH/DRAINFIELD DATA		
WIDTH	INLET	BOTTOM
2'	3'10"	7'10"
NUMBER OF TRENCHES		3
TOTAL LENGTH		215
ABSORPTION AREA		800
DISTRIBUTION BOX LEVEL		<input checked="" type="checkbox"/>
DISTRIBUTION BOX BAFFLE		<input checked="" type="checkbox"/>
DISTRIBUTION BOX PORT		<input type="checkbox"/>

SEPTIC TANK DATA		levelers
SEPTIC TANK 1 LEVEL	yes	used
CAPACITY	1250	GAL
SEAM LOC	T.S.	
TANK LID DEPTH	4'	
BAFFLES	yes	
BAFFLE FILTER	NO	
MANHOLE LOC	middle	
6" PORT LOC	front	
WATERTIGHT TEST		
SEPTIC TANK 2 LEVEL		
CAPACITY		GAL
SEAM LOC		
TANK LID DEPTH		
BAFFLES		
BAFFLE FILTER		
MANHOLE LOC		
6" PORT LOC		
WATERTIGHT TEST		

NA

PRE-CONSTRUCTION

INSTALLATION 5/17/02 3 trenches, 70, 70+, 75 installed. The tree between the first two trenches is 5' away from the 22 1/2' line. All work satisfactory, OK to cover. Neighboring wells are of no concern due to tops and their elevations. (Rb)

FINAL INSPECTOR Goodking

DATE OF APPROVAL 5-17-02