

Check out
9/14/61

PERMIT

P 03024
A 03007

SEWAGE DISPOSAL SYSTEM

MARYLAND STATE DEPARTMENT OF HEALTH

HOWARD COUNTY

ELLCOTT CITY

DISTRICT

DATE 6-2-61

INDEXED

Aubrey E. Fleming

IS PERMITTED TO INSTALL ALTER

ADDRESS Mt. Airy, Md.

PHONE Mt. Airy 1734

A SEWAGE DISPOSAL SYSTEM LOCATED AT On 144 in Poplar Springs across from Farm Repair

SUBDIVISION

ROAD

LOT

PROPERTY OWNER Aubrey E. Fleming

ADDRESS Mt. Airy, Md.

SPECIFICATIONS

DRAIN FIELD DEPTH FEET, BOTTOM AREA SQ. FT.

SEEPAGE PITS ADJORBENT SIDE-WALL AREA SQ. FT.

SEPTIC TANK CAPACITY 750 GALLONS

FOR GARBAGE GRINDER, INCREASE DISPOSAL AREA AND TANK CAPACITY NOW

OTHER Dry Well - 38sq. ft. side wall area below the inlet.


PLANE APPROVED BY Walter T. Leovy

DATE 6-2-61

FILL SEPTIC TANK AND DISTRIBUTION BOX WITH WATER BEFORE CALLING FOR AN INSPECTION. COVER NO WORK UNTIL INSPECTED AND APPROVED.

NEITHER THE HOWARD COUNTY COMMISSIONERS NOR THE HEALTH DEPARTMENT IS RESPONSIBLE FOR THE SUCCESSFUL OPERATION OF ANY SYSTEM.

03501

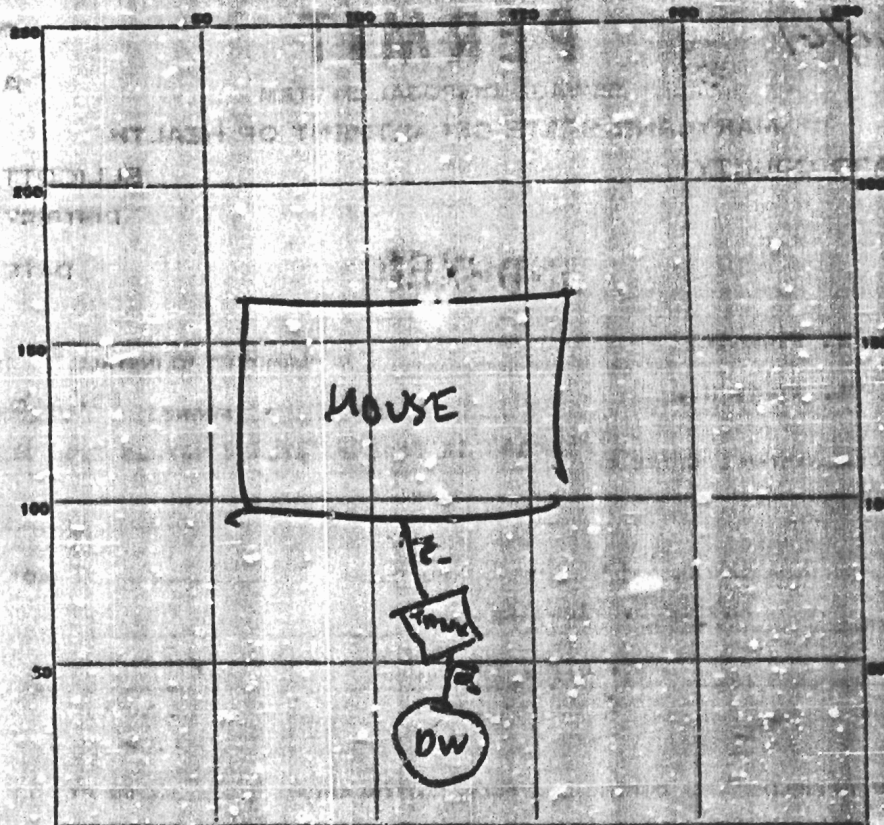

INCHES NORTH - NAME ADJOINING ROADWAY AS BASE LINE

RTE 144

PERMIT CARD

SEPTIC TANK, LEVEL ✓ 1000 concrete CLEANOUTS

DISTRIBUTION BOX, LEVEL _____

TILE FIELD, DEPTH _____ FT. TRENCH WIDTH _____ FT.

GRAVEL, DEPTH _____ IN. TOTAL LENGTH _____ FT.

NUMBER OF TRENCHES _____ TOTAL BOTTOM AREA _____

SIZE PAGE PITS, INSIDE DIAMETER 10 FT. DEPTH BELOW INLET 11 FT.

ABSORBENT AREA 341 SQ. FT.

REMARKS _____

DATE SYSTEM APPROVED 8/10/61 INSPECTOR J. J. [Signature]