

PERMIT

P 19779

A 516953

SEWAGE DISPOSAL SYSTEM

MARYLAND STATE DEPARTMENT OF HEALTH

HOWARD COUNTY

03-296822

ELLICOTT CITY

DISTRICT 3rd

INDEXED

DATE 4/15/74

Roland Barth

IS PERMITTED TO INSTALL ALTER

ADDRESS Clarksville Pike, Ellicott City, Maryland

PHONE 730-8495

A SEWAGE DISPOSAL SYSTEM LOCATED AT _____

SUBDIVISION Everlea

ROAD Everlea Road

LOT 9, Blk. B, Sec. 3

PROPERTY OWNER E. L. Ramsburg

Deane Rhincoort as of 4/21/81

662-2215

ADDRESS 185 Henryton Road, Marriottsville, Md.

SPECIFICATIONS 3 bedrooms

DRAIN FIELD _____ DEPTH _____ FEET, BOTTOM AREA _____ SQ. FT.

SEEPAGE PITS _____ ABSORBENT SIDE-WALL AREA _____ SQ. FT.

SEPTIC TANK CAPACITY 1000 GALLONS

FOR GARBAGE GRINDER, INCREASE DISPOSAL AREA 22% & TANK CAPACITY 50%.

OTHER DRY WELL - To have 125 sq. ft. effective absorbent sidewall area per bedroom below inlet. Inlet to be 4 ft. below original grade and maximum depth 12 ft. Locate dry well 233 ft. down right property line and 20 ft. in from right property line. Use perc hole (1 & 2) as seen when facing lot from unnamed road.

NOTE: ALL PIPE FROM HOUSE TO DRY WELL MUST BE CAST IRON.

PERMIT VOID AFTER THREE YEARS.

NOTE: INSTALL STAND PIPE ON SEPTIC TANK AND DRY WELL.


PLANS APPROVED BY Charles B. Streaker

DATE 9/20/73

FILL SEPTIC TANK AND DISTRIBUTION BOX WITH WATER BEFORE CALLING FOR AN INSPECTION. COVER NO WORK UNTIL INSPECTED AND APPROVED.

NEITHER THE HOWARD COUNTY COMMISSIONERS NOR THE HEALTH DEPARTMENT IS RESPONSIBLE FOR THE SUCCESSFUL OPERATION OF ANY SYSTEM.

516953

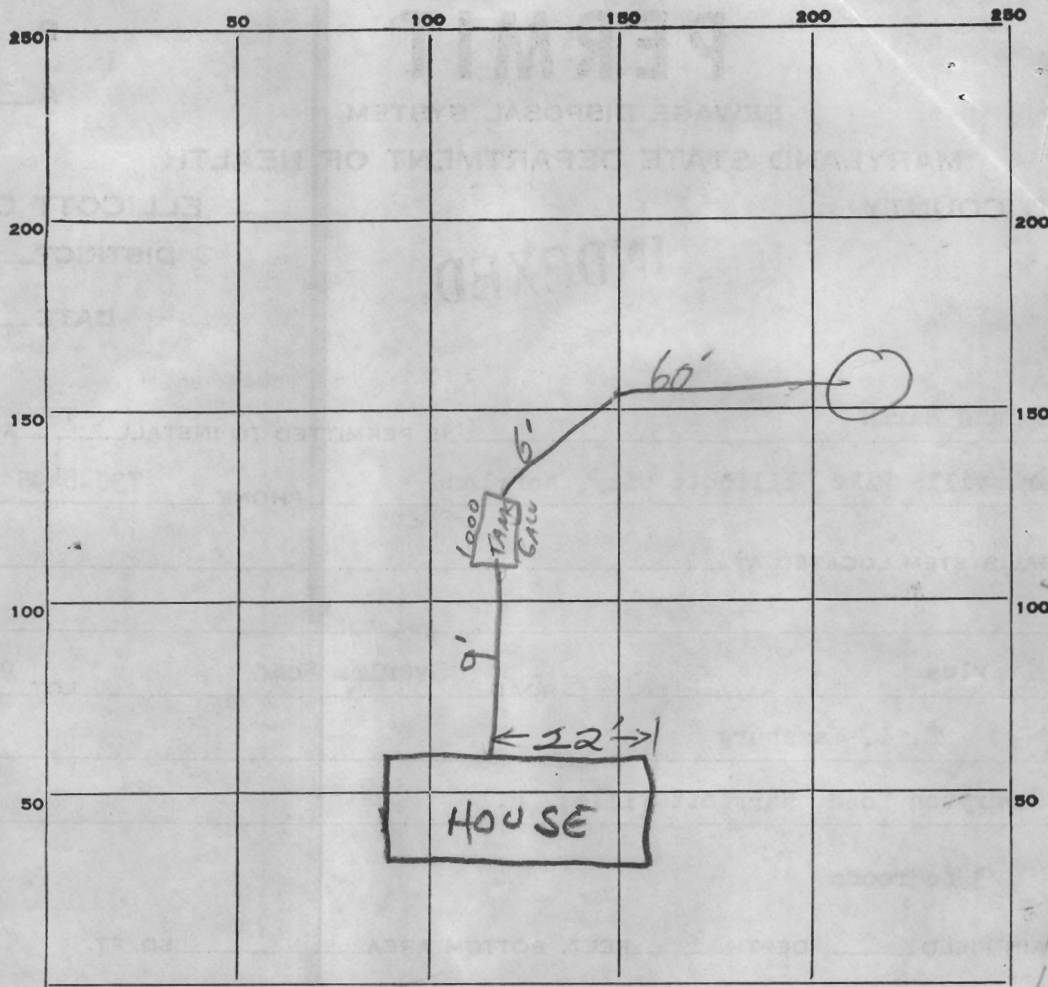

INDICATE NORTH. - NAME ADJOINING ROADWAY AS BASE LINE.

ROAD

PERMIT CARD _____

SEPTIC TANK, LEVEL OK

CLEANOUTS OK

DISTRIBUTION BOX, LEVEL N/A

TILE FIELD, DEPTH N/A FT.

TRENCH WIDTH N/A FT.

GRAVEL DEPTH _____ IN.

TOTAL LENGTH _____ FT.

NUMBER OF TRENCHES _____

TOTAL BOTTOM AREA _____

SEEPAGE PITS, INSIDE DIAMETER 57 FT.

DEPTH BELOW INLET 7' FT.

ABSORBENT AREA 394 SQ. FT.

REMARKS

4-19-74 H.Z. & F.F.

4/19/74 Cleanouts cemented properly - System otherwise OK

DATE SYSTEM APPROVED

4/19/74

INSPECTOR

William H. Jupp

